IREDELL COUNTY HEALTH DEPARTMENT

Statesville Office (704) 878-5305 Mooresville Office (704) 660-3625 PERMIT # 213943

IMPROVEMENT PERMIT / AUTHORIZATION TO CONSTRUCT / OPERATION PERMIT / EXISTING SYSTEM

PIN # 4730361077

APPLICANT: SAC LLC APPLICANT ADDRESS: 115 Kimmel Dr.

SITE ADDRESS: 305 State Park Rd. PHONE: 704-528-7766 ALT. PHONE: N/A

SITE DIRECTIONS: Hwy 21S TR Perth TR State Park Property on Left

SUBDIVISION: Twinn Creek Estates SECTION: 1 LOT # 64 LOT AREA: 0.87acres DESIGN FLOW: Existing L.T.A.R.: Existing

Septic Tank	Existing (gal)	STB	Date	☐ New System ☐ Repair ☐ Expansion System Type: I II III IV V VI	☑ Residence	No. Bedrooms	Ex
Pump Tank	(gal)	PT	Date	System Description: Existing	☐ Business	No. Persons	Ex
Pump Make		Model	Serial #	Repair System Description:	☐ Other	No. Employees	
# Nitrification Fields	Ex	# Lines	Ex	Linear Ft: Ex	Maintenance Agreement Required: ☐ YES ☑ NO	☐ Slab	☑ Crawl Space
Trench Width	Ex	Max. Trench Bottom Depth	Ex	Gravel Depth Ex	☑ GRAVITY ☐ PRESSURE	☐ Basement w/plumbing	☐ Basement w/o plumbing


Water Supply: ☐ Private ☑ Public ☐ Community

Comments / Conditions:

- Maintain a minimum of 5' between screen porch foundation & all components of septic tank system.

INITIAL SITE SKETCH

AS BUILT SKETCH

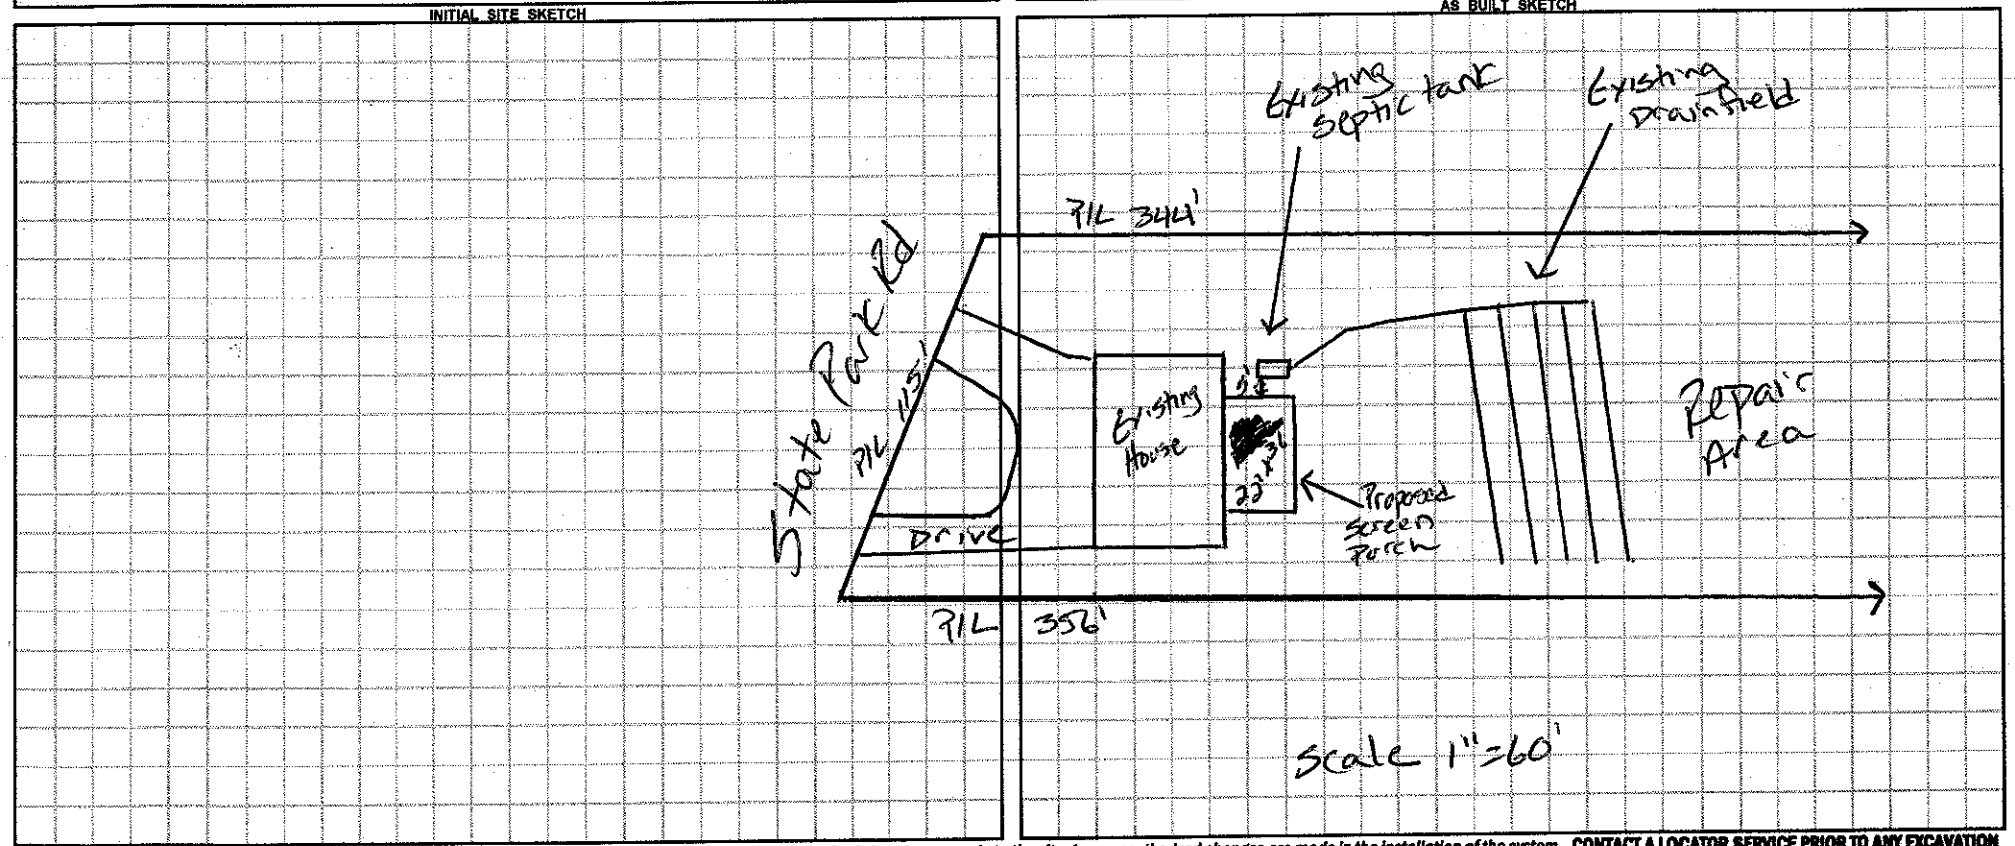

Permit can be suspended or revoked if any false information is supplied toward securing the permit / any unauthorized changes are made to the site / any unauthorized changes are made in the installation of the system. **CONTACT A LOCATOR SERVICE PRIOR TO ANY EXCAVATION**

☐ **IMPROVEMENT PERMIT** *with plat valid without expiration.* ☐ **IMPROVEMENT PERMIT** *with site plan valid for 60 mos.* ☐ **AUTHORIZATION TO CONSTRUCT** *valid for period equal to IMPROVEMENT PERMIT--not to exceed 60 mo.*

Owner / Applicant Signature: [signature] Date: 10/8/15

IMPROVEMENT PERMIT by: _____ Date: _____

AUTHORIZATION TO CONSTRUCT by: _____ Date: _____

Installed by: _____

OPERATION PERMIT by: _____ Date: _____

Existing System Inspected by: [signature] Date: 10-9-15

Health Dept. Copy - WHITE Applicant (Final Approval) - YELLOW Applicant (Conditional Approval) - PINK