IREDELL COUNTY HEALTH DEPARTMENT

CT

STATESVILLE 704-878-5305 MOORESVILLE 704-664-5281

IMPROVEMENT PERMIT / AUTHORIZATION TO CONSTRUCT / OPERATION PERMIT / EXISTING SYSTEM INSPECTION

PERMIT# 138440 PIN# 4730-26-2107 DATE 10/18/06

OWNER OR APPLICANT VASILE LAZAR PHONE: Business 704-799-0645 Home 704-906-5102

ADDRESS 275 Whippoor Will RD MOORESVILLE NC 28117

LOCATION 21 SOUTH @ PORTH @ STATE PARK ON LEFT RIGHT PUSHPOLA WATER

SUBDIVISION TWIN CREEKS BLOCK / SECTION 1 LOT 63 LOT AREA 0.79AC SITE CLASS. PS DESIGN FLOW 480 L.T.A.R. .3

Septic Tank: 1000 Gallons; STB 825 Date 10-17-06

Pump Tank: _____ Gallons; PT _____ Date _____

Pump Make: _____ Model _____ Serial No. _____

Nitrification Field: No Fields 1 Square Feet 66=1600' Linear Feet 400'

No Lines 5 Trench Width 36" Max Trench Bottom Depth 36" Gravel Depth NA

☒ New System ☐ Repair ☐ Expansion System Type: I (II) III IV V VI

System Description: 60%/40% 25%/REDUCT

Repair System Description: LP 50%/REDUCT

Maintenance Agreement Required: ☐ Yes ☒ No

☒ House/Mod. Home ☐ Mobile Home ☐ Business ☐ Other

No. Bedrooms 4 No. Persons 8 No. Employees _____

Water Supply: ☐ Individual ☒ Public ☐ Community


☐ Gravity ☐ Pressure ☐ Slab ☒ Crawl Space ☐ Basement w/plumbing ☐ Basement wo/plumbing

Comments:/Conditions: (1) INSTALL LINES ON CONTOURS USING DROP BOXES + OBTAIN SETBACKS (2) CALL Prior to Grading Out Ditch For Consultation visit.


Comments:/Conditions: DIVERTIDE Filter + MANHOLE RISER Filled + NOT WITH THIS DONE TO Prevent interception with contours.

1"=50'

INITIAL SITE SKETCH

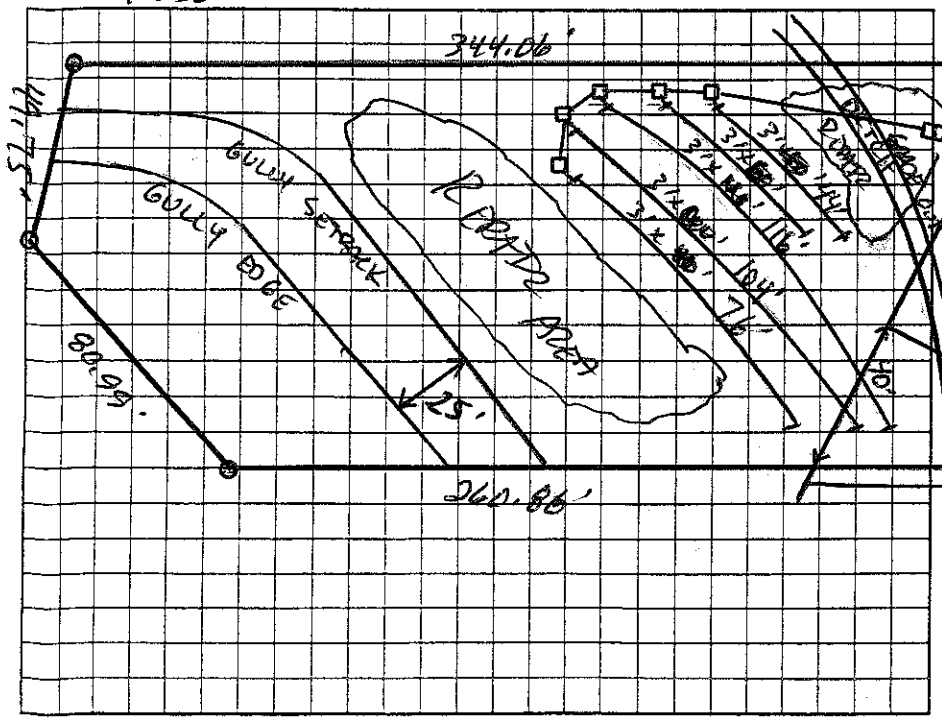

AS BUILT SKETCH

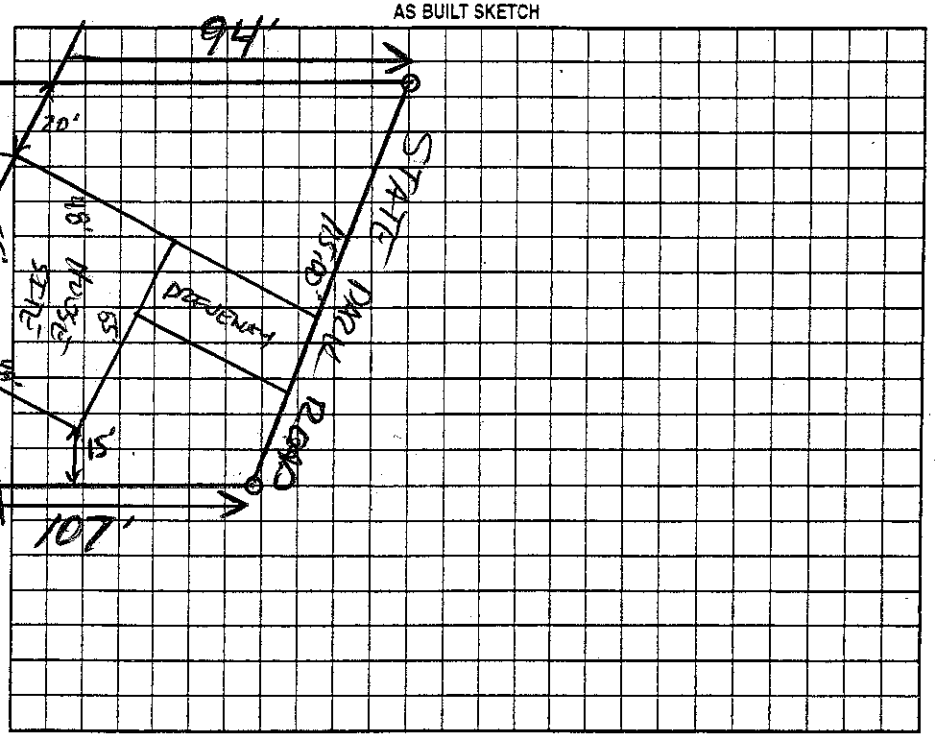

Permit can be suspended or revoked if any false information is supplied toward securing the permit/any unauthorized changes are made to the site/any unauthorized changes are made in the installation of the system. Improvement Permit with plat valid without expiration ☐ Improvement Permit with site plan valid for sixty months ☒ Authorization to Construct is valid for a period equal to that of Improvement Permit – not to exceed sixty months.

Signed: [signature] date 10-19-06 Installed by: RONALD SEPTIC

Improvement Permit by: [signature] date 10-18-06 Operation Permit by: [signature] date 1-3-07

Authorization to Construct by: [signature] date 10-18-06 Existing System Inspection by: _____ date _____

HEALTH DEPT. COPY: WHITE OWNER COPY (FINAL): YELLOW OWNER COPY (INITIAL): PINK