IREDELL COUNTY HEALTH DEPARTMENT

Statesville Office (704) 878-5305 Mooresville Office (704) 660-3625 PERMIT # 215875

IMPROVEMENT PERMIT / AUTHORIZATION TO CONSTRUCT / OPERATION PERMIT / EXISTING SYSTEM

PIN # 4730-36-2971.000

APPLICANT: Andrew Ventresca APPLICANT ADDRESS: 7931 Bayles Dr. Huntersville NC 28078

SITE ADDRESS: 256 State Park Rd. Troutman NC 28166 PHONE: 704-615-4970 ALT. PHONE: 315-730-3463

SITE DIRECTIONS: Perth Rd. S to State Park Rd., Site on R

SUBDIVISION: Pump Farm + Marengo Property SECTION: — LOT # 1 LOT AREA: 1.2 Acre DESIGN FLOW: 360 GPD L.T.A.R.: .3

Septic Tank	1000 (gal)	STB	786	Date	3-11-16		
Pump Tank	(gal)	PT		Date			
Pump Make		Model		Serial #			
# Nitrification Fields	1	# Lines	3 @ 100'	Linear Ft:	300'		
Trench Width	36"	Max. Trench Bottom Depth *	28" Lowest	* Gravel Depth	N/A		

☒ New System ☐ Repair ☐ Expansion System Type: I II ☒ III IV V VI

System Description: 25% Reduction - Gravity

Repair System Description: LS-RIPS

Maintenance Agreement Required: ☐ YES ☒ NO

☒ GRAVITY ☐ PRESSURE

☒ Residence No. Bedrooms 3

☐ Business No. Persons 6

☐ Other No. Employees


☐ Slab ☒ Crawl Space

☐ Basement w/plumbing ☐ Basement w/o plumbing


Water Supply: ☒ Private ☐ Public ☐ Community

Comments / Conditions: Smooth/Sewer Drainfield Area where needed.

INITIAL SITE SKETCH

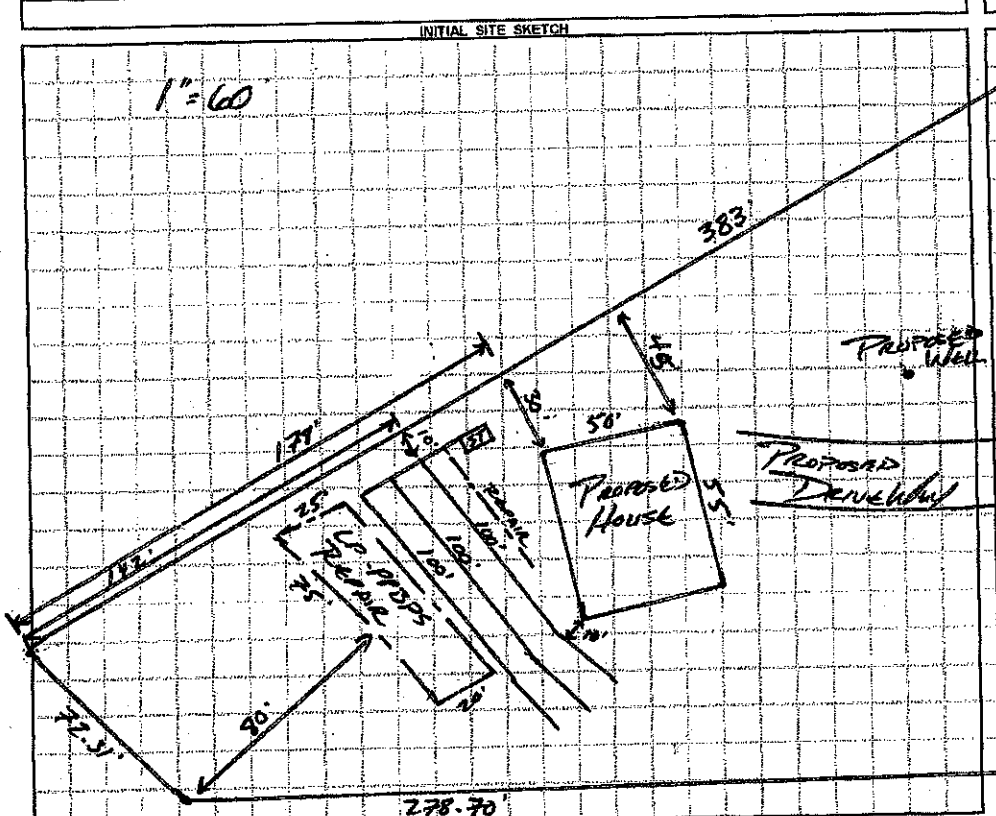

AS BUILT SKETCH

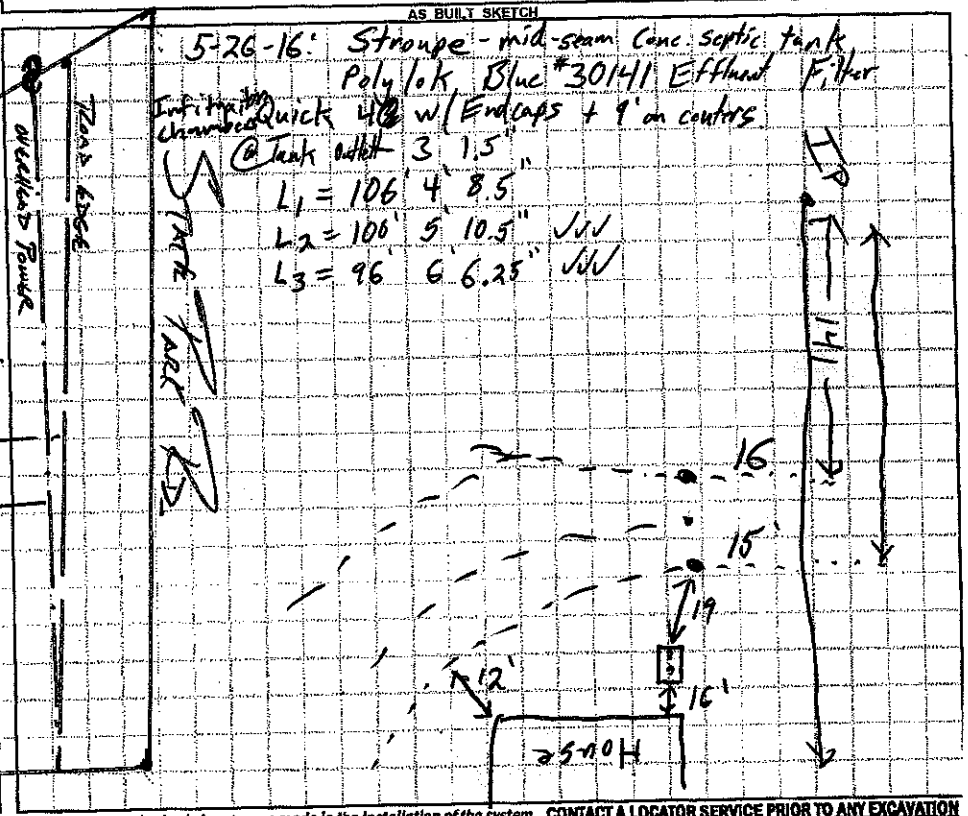

Permit can be suspended or revoked if any false information is supplied toward securing the permit / any unauthorized changes are made to the site / any unauthorized changes are made in the installation of the system. CONTACT A LOCATOR SERVICE PRIOR TO ANY EXCAVATION

☐ IMPROVEMENT PERMIT with plat valid without expiration. ☒ IMPROVEMENT PERMIT with site plan valid for 60 mos. ☒ AUTHORIZATION TO CONSTRUCT valid for period equal to IMPROVEMENT PERMIT—not to exceed 60 mo.

Owner / Applicant Signature: A.R. Ventresca Date:

Installed by: Tim Hice w/ Stanley Burns

IMPROVEMENT PERMIT by: APPROVED FEB 05 2016 Date:

OPERATION PERMIT by: Tim Hice Date: 5-26-16

AUTHORIZATION TO CONSTRUCT by: APPROVED FEB 05 2016 Date:

Existing System Inspected by: Date:

Health Dept. Copy - WHITE Applicant (Final Approval) - YELLOW Applicant (Conditional Approval) - PINK