IREDELL COUNTY HEALTH DEPARTMENT

CI

STATESVILLE 704-878-5305 MOORESVILLE 704-664-5281

IMPROVEMENT PERMIT / AUTHORIZATION TO CONSTRUCT / OPERATION PERMIT / EXISTING SYSTEM INSPECTION

PERMIT# 13426J PIN# 4730-36-2167 DATE 11-1-07

OWNER OR APPLICANT Mike Seaford PHONE: Business 704-634-1000 Home

ADDRESS 121 KALLIE LOOP Mooresville NC 28117

LOCATION DEPOT RD SOUTH, (R) State Park RD (L) RUNNING WATER

SUBDIVISION TWIN Creeks BLOCK / SECTION LOT 6 LOT AREA 1.642AC SITE CLASS. PS DESIGN FLOW 480 L.T.A.R. .25

Septic Tank: 1000 Gallons: STB 794 Date 10-4-07

Pump Tank: 1000 Gallons: PT 385 Date 10-26-07

Pump Make: Zoeller Model 6152-B Serial No.

Nitrification Field: No Fields 1 Square Feet 3840 Linear Feet 480'

No Lines 6 Trench Width 36" Max Trench Bottom Depth 24"

☒ New System ☐ Repair ☐ Expansion System Type: I II (III) IV V VI

System Description: PUMP 25% REDUCTION

Repair System Description: Low Pressure Pipe

Maintenance Agreement Required: ☐ Yes ☒ No

Gravel Depth n/a ☐ Gravity ☒ Pressure ☐ Slab ☐ Crawl Space ☒ Basement w/plumbing ☐ Basement wo/plumbing

☒ House/Mod. Home ☐ Mobile Home ☐ Business ☐ Other

No. Bedrooms 4 No. Persons 8 No. Employees

Water Supply: ☐ Individual ☒ Public ☐ Community

Comments:/Conditions: (1) EZ FLOW SYSTEM 25% REDUCTION MUST BE USED Per SAME DESIGN (2) SEE ATTACHED DESIGN FOR DETAILS (3) System FLAGGED Not Completely.


INITIAL SITE SKETCH

SEE ATTACHED DESIGN SUBMITTED BY SAME, INC PROJECT # 1588-07-082

AS BUILT SKETCH INSTALLED AS DRAWN

Permit can be suspended or revoked if any false information is supplied toward securing the permit/any unauthorized changes are made to the site/any unauthorized changes are made in the installation of the system. Improvement Permit with plat valid without expiration ☐ Improvement Permit with site plan valid for sixty months ☒ Authorization to Construct is valid for a period equal to that of Improvement Permit – not to exceed sixty months.

Signed: date 11/5/07

Improvement Permit by: date 11-7-07


Authorization to Construct by: date 11-5-07

Installed by: RDH WASTEWATER

Operation Permit by: date 12-13-07

Existing System Inspection by: date

HEALTH DEPT. COPY: WHITE OWNER COPY (FINAL): YELLOW OWNER COPY (INITIAL): PINK

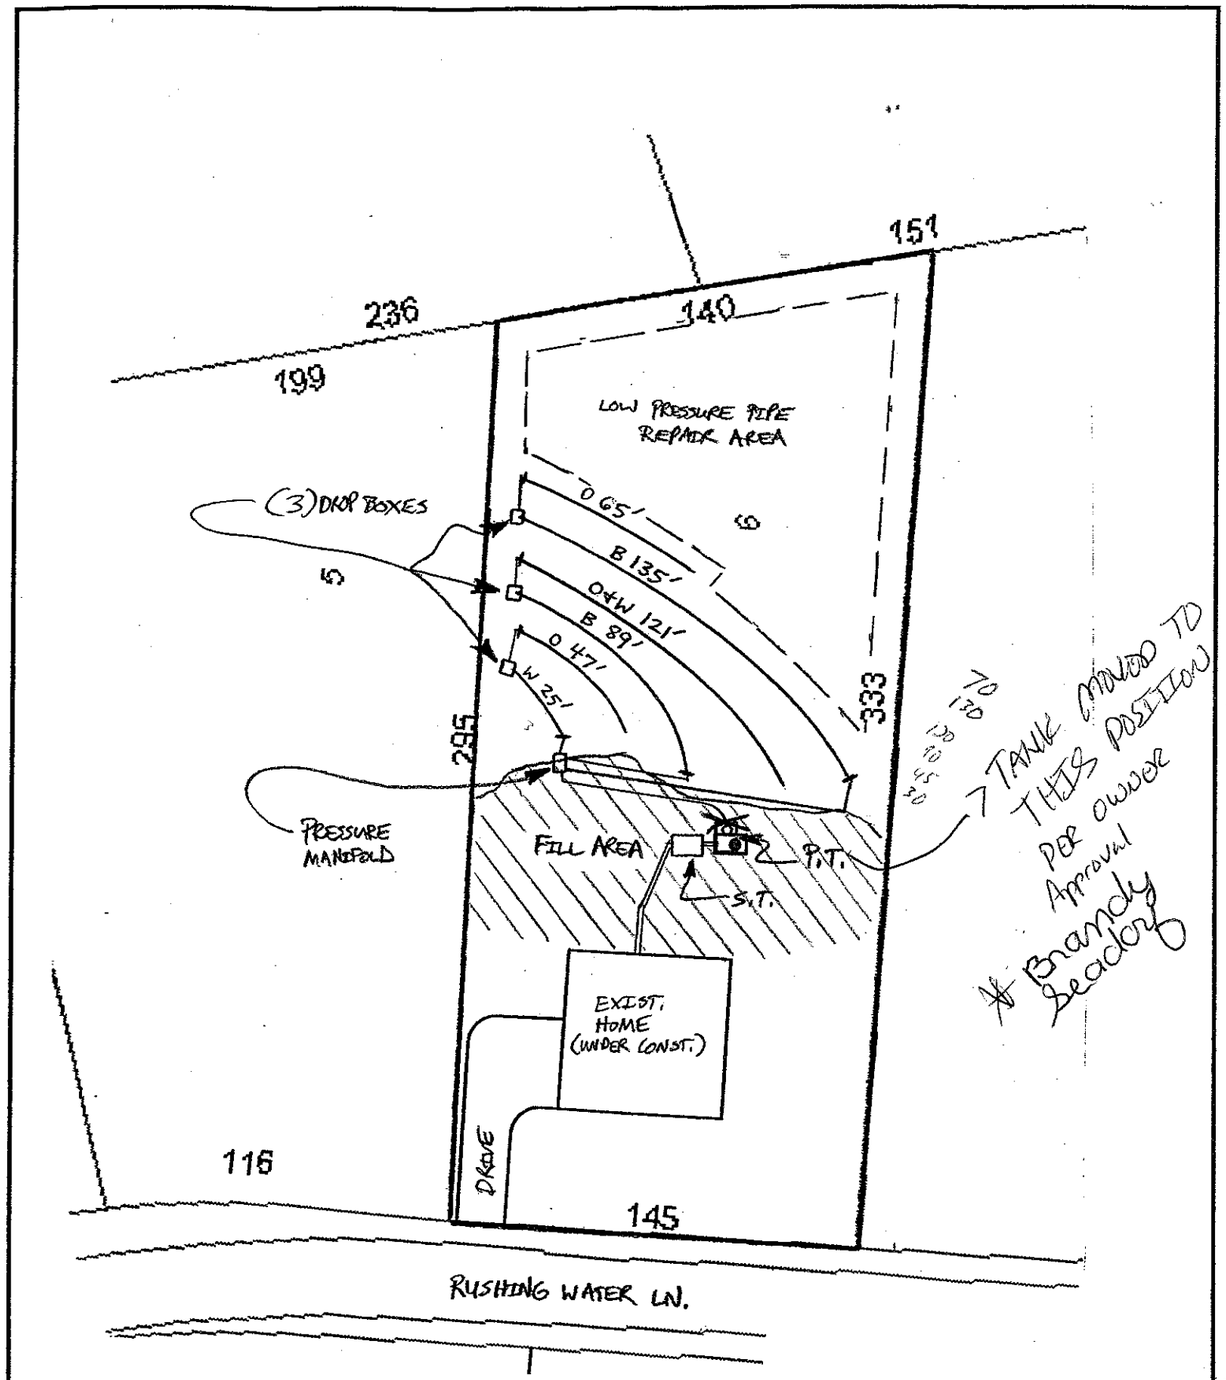

APPROX. SCALE: 1" = 50 Feet	S&ME ENVIRONMENTAL SERVICES · ENGINEERING · TESTING	LOT 6	SITE MAP
CHECKED BY: PGP			
DRAWN BY: PLM			
DATE: Oct-07		JOB NO. 1588-07-082	Twin Creeks Subdivision