Site address: 129 Rushing Water Ln., Troutman

IREDELL COUNTY HEALTH DEPARTMENT

STATESVILLE 704-878-5305 MOORESVILLE 704-664-5281

IMPROVEMENT PERMIT / AUTHORIZATION TO CONSTRUCT / OPERATION PERMIT / EXISTING SYSTEM INSPECTION

PERMIT# 138773 PIN# 4730348352 DATE 10-9-06

OWNER OR APPLICANT James Dickerson (Gilmore Johnson) PHONE Business ______ Home 704-239-6090

ADDRESS Box 99 Mt Mourne NC 28123

LOCATION State Park Road to Rushing Water 5th lot on left

SUBDIVISION Twin Creeks BLOCK / SECTION ______ LOT 5 LOT AREA ______ SITE CLASS. PS DESIGN FLOW 480 L.T.A.R. .25

Septic Tank: 1000 Gallons; STB 760 Date 10-18-10

Pump Tank: ______ Gallons; PT ______ Date ______

Pump Make: ______ Model ______ Serial No. ______

Nitrification Field: No Fields ______ Square Feet 1920 Linear Feet 480

No Lines 6 Trench Width 36" Max Trench Bottom Depth 36" Gravel Depth ______

☒ New System ☐ Repair ☐ Expansion System Type: I II ~~III~~ IV V VI

System Description: 25% GRAVEL

Repair System Description: 50% Low Pres

Maintenance Agreement Required: ☐ Yes ☒ No X Repair

☒ Gravity ☐ Pressure

☒ House/Mod. Home ☐ Mobile Home ☐ Business ☐ Other ______

No. Bedrooms 4 No. Persons ______ No. Employees ______


Water Supply: ☐ Individual ☒ Public ☐ Community

☐ Slab ☒ Crawl Space ☐ Basement w/plumbing ☐ Basement wo/plumbing


Comments:/Conditions:
Shave berm
★→ Call Health Dept prior to grading for consultive visit for grading specifications

Comments:/Conditions:
Maintain all setbacks
Install on contour

INITIAL SITE SKETCH

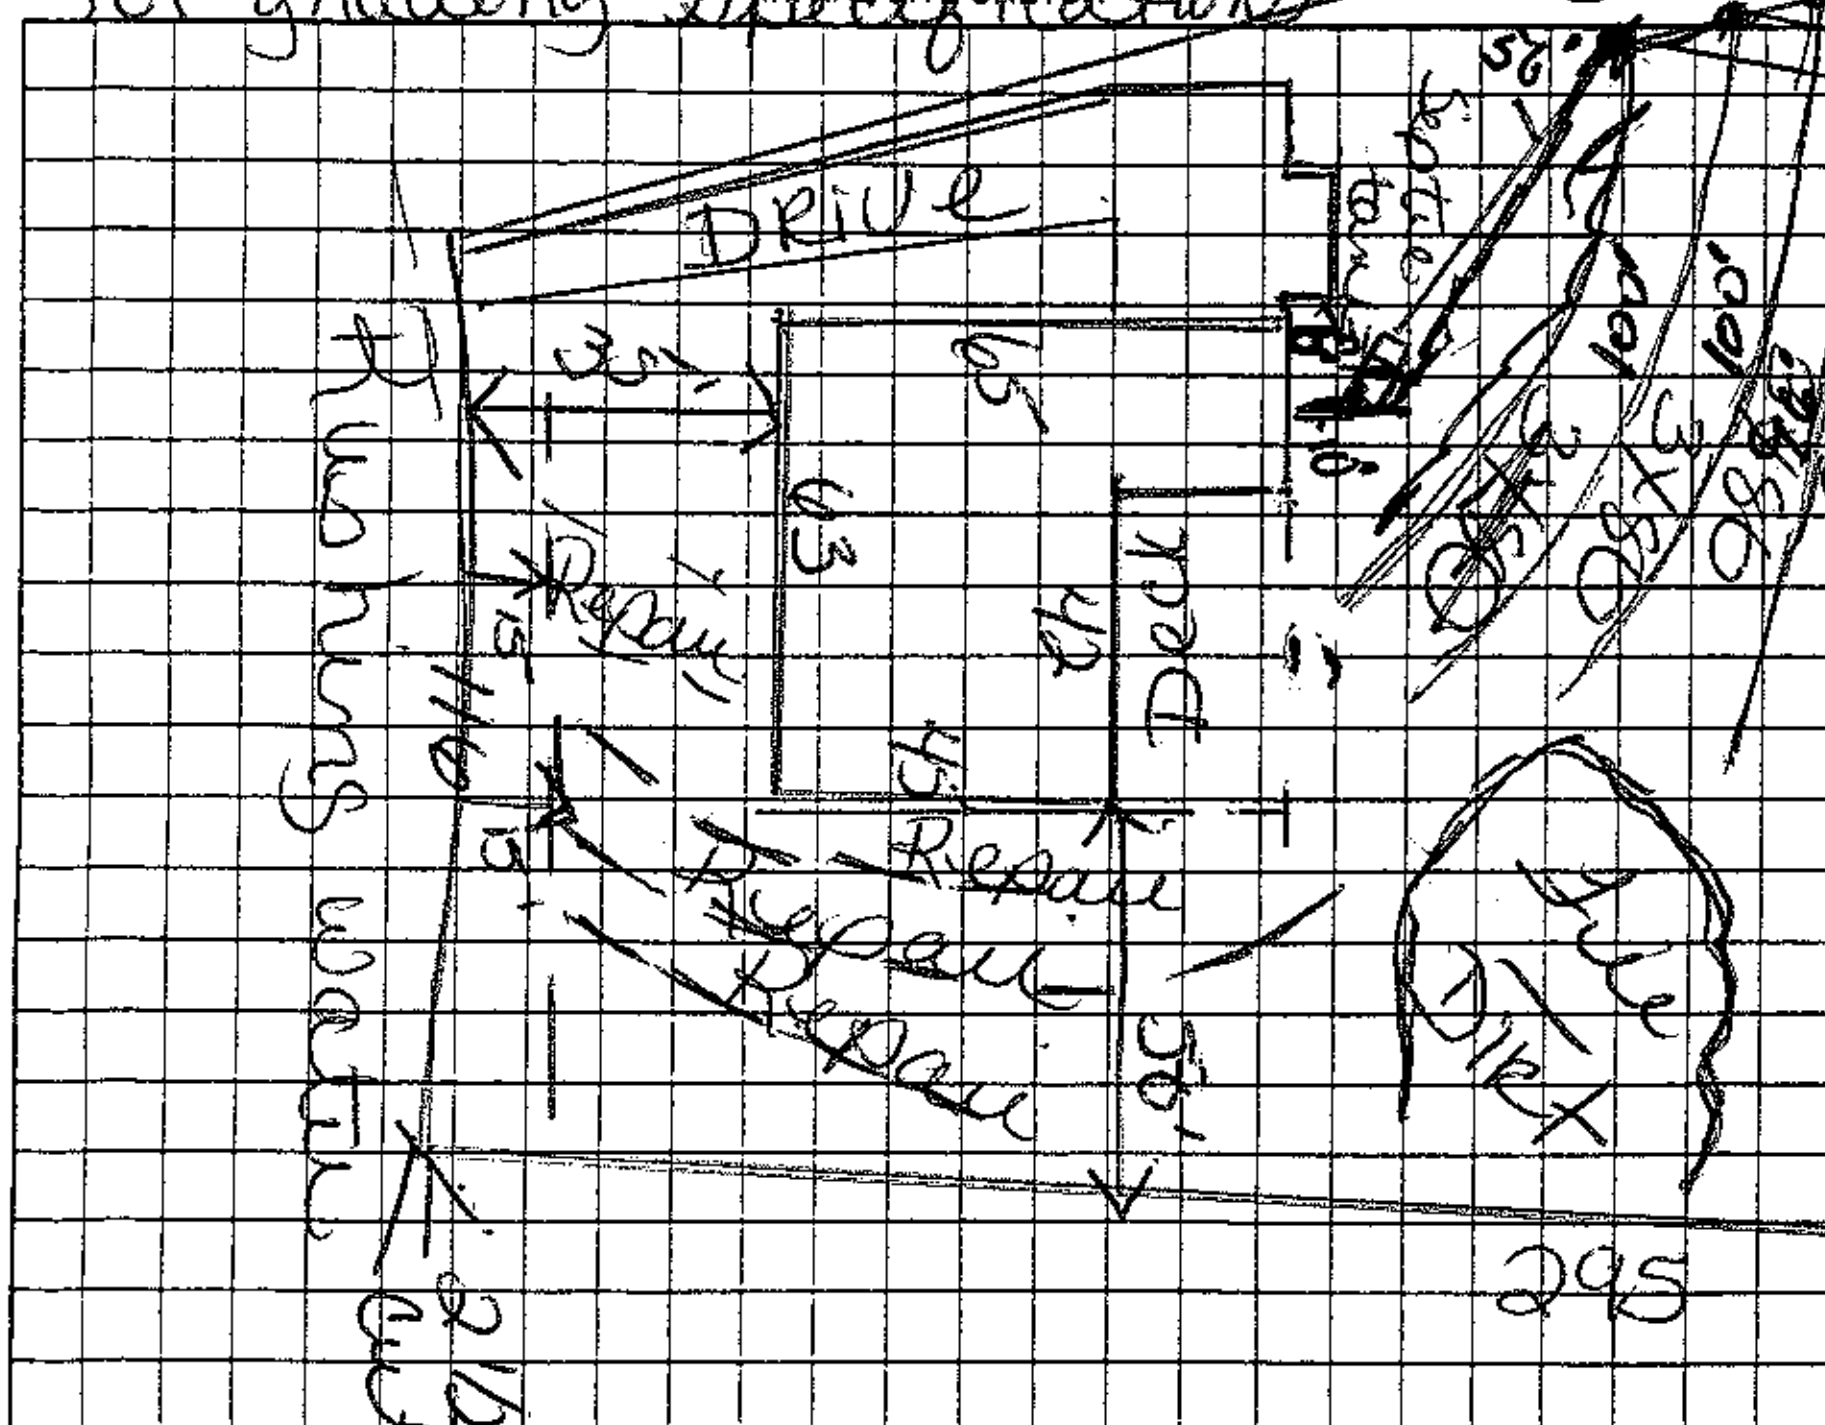

AS BUILT SKETCH

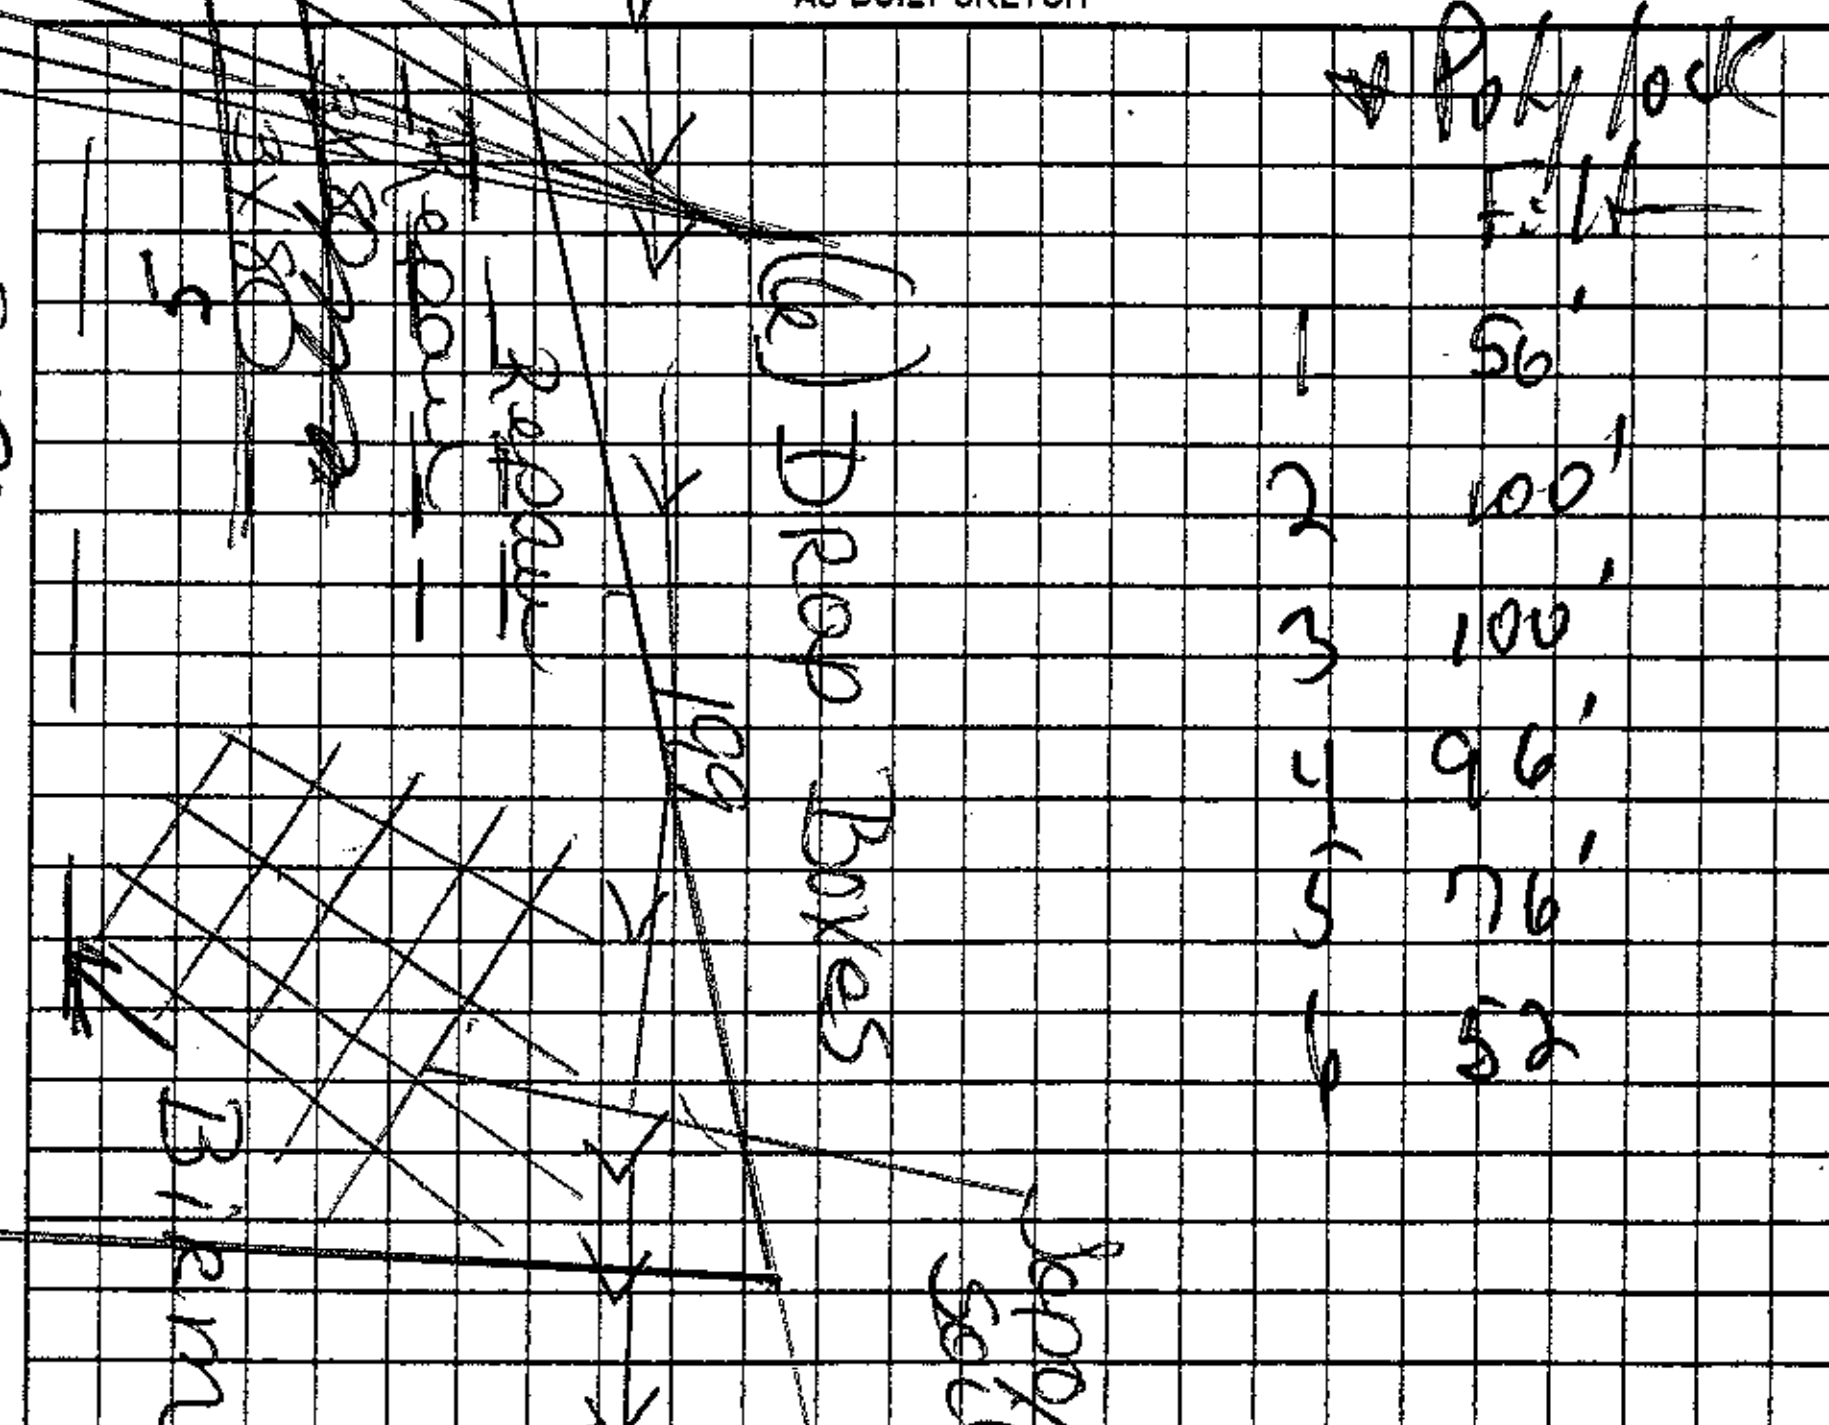

Permit can be suspended or revoked if any false information is supplied toward securing the permit/any unauthorized changes are made to the site/any unauthorized changes are made in the installation of the system. Improvement Permit with plat valid without expiration ☐ Improvement Permit with site plan valid for sixty months ☐ Authorization to Construct is valid for a period equal to that of Improvement Permit, not to exceed sixty months.

Signed: [signature] date 11/14/06

Improvement Permit by: Kelly J Cook date 11-7-06

Authorization to Construct by: Kelly J Cook date 11-07-06

Installed by: A-1 Backhoe

Operation Permit by: [signature], RS date 21 May 10

Existing System Inspection by: ______ date ______

HEALTH DEPT. COPY: WHITE OWNER COPY (FINAL): YELLOW OWNER COPY (INITIAL): PINK