CI

IREDELL COUNTY HEALTH DEPARTMENT

STATESVILLE 704-878-5305 MOORESVILLE 704-664-5281

IMPROVEMENT PERMIT / AUTHORIZATION TO CONSTRUCT / OPERATION PERMIT / EXISTING SYSTEM INSPECTION

PERMIT# 136353 PIN# 4730-36-8428 DATE 10/10/06

OWNER OR APPLICANT RYAN WEST DEVELOPERS LLC PHONE: Business 704-361-1085 Home 704-799-8645

ADDRESS 107 B Promenade DR MOORESVILLE NC 28117

LOCATION PERTH RD, STATE PARK RD ① RUSHING WATER ON LEFT LOT # 4

SUBDIVISION TWIN CREEKS BLOCK / SECTION ____ LOT 4 LOT AREA .73 SITE CLASS. PS DESIGN FLOW 360 L.T.A.R. .3

Septic Tank: 1000 Gallons; STB 1007 Date 9-4-06
Pump Tank: ____ Gallons; PT ____ Date ____
Pump Make: ____ Model ____ Serial No. ____
Nitrification Field: No Fields 1 Square Feet EQ=1200' Linear Feet 200'
No Lines 4 Trench Width 24" Max Trench Bottom Depth 36" Gravel Depth N/A

☒ New System ☐ Repair ☐ Expansion System Type: I II (III) IV V VI
System Description: 60% 50% REDUCT
Repair System Description: LD 50%
Maintenance Agreement Required: ☐ Yes ☒ No

☒ House/Mod. Home ☐ Mobile Home ☐ Business ☐ Other
No. Bedrooms 3 No. Persons 6 No. Employees ____

Water Supply: ☐ Individual ☒ Public ☒ Community

☐ Gravity ☐ Pressure ☐ Slab ☒ Crawl Space ☐ Basement w/plumbing ☐ Basement wo/plumbing

Comments/Conditions: ① INSTALL 4 LINES / 50' LONG / USING 1 FLOW DIVIDER TEE / 2 DIST BOXES WITH SPEED LEVELERS ② INSTALL LINES ON CONTOURS & MAINTAIN SETBACKS. ③ BOTTOM LINE OF

INITIAL SITE SKETCH

SEE ATTACHED PLAN SUBMITTED BY ROLLANS SOIL AND ENVIRONMENTAL

Comments/Conditions: REPAIR IS 15' OFF 2' CUT which is below ④ 11'9/16' P/L HAS FILLED CUT but end drainlines is 5'+ off gully which is filled & packed.

AS BUILT SKETCH

ROWCO FILTER & RISERS
BUILDER OK'D TANK CHANGES

Permit can be suspended or revoked if any false information is supplied toward securing the permit/any unauthorized changes are made to the site/any unauthorized changes are made in the installation of the system. Improvement Permit with plat valid without expiration ☐ Improvement Permit with site plan valid for sixty months ☒ Authorization to Construct is valid for a period equal to that of Improvement Permit – not to exceed sixty months.


Signed: ____ date 10/11/06 Installed by: WAYNE CLONTZ

Improvement Permit by: ____ date 10-10-06 Operation Permit by: ____ date 3-8-07

Authorization to Construct by: ____ date 10-10-06 Existing System Inspection by: ____ date ____

HEALTH DEPT. COPY: WHITE OWNER COPY (FINAL): YELLOW OWNER COPY (INITIAL): PINK

Wyatt Clark
361-1085

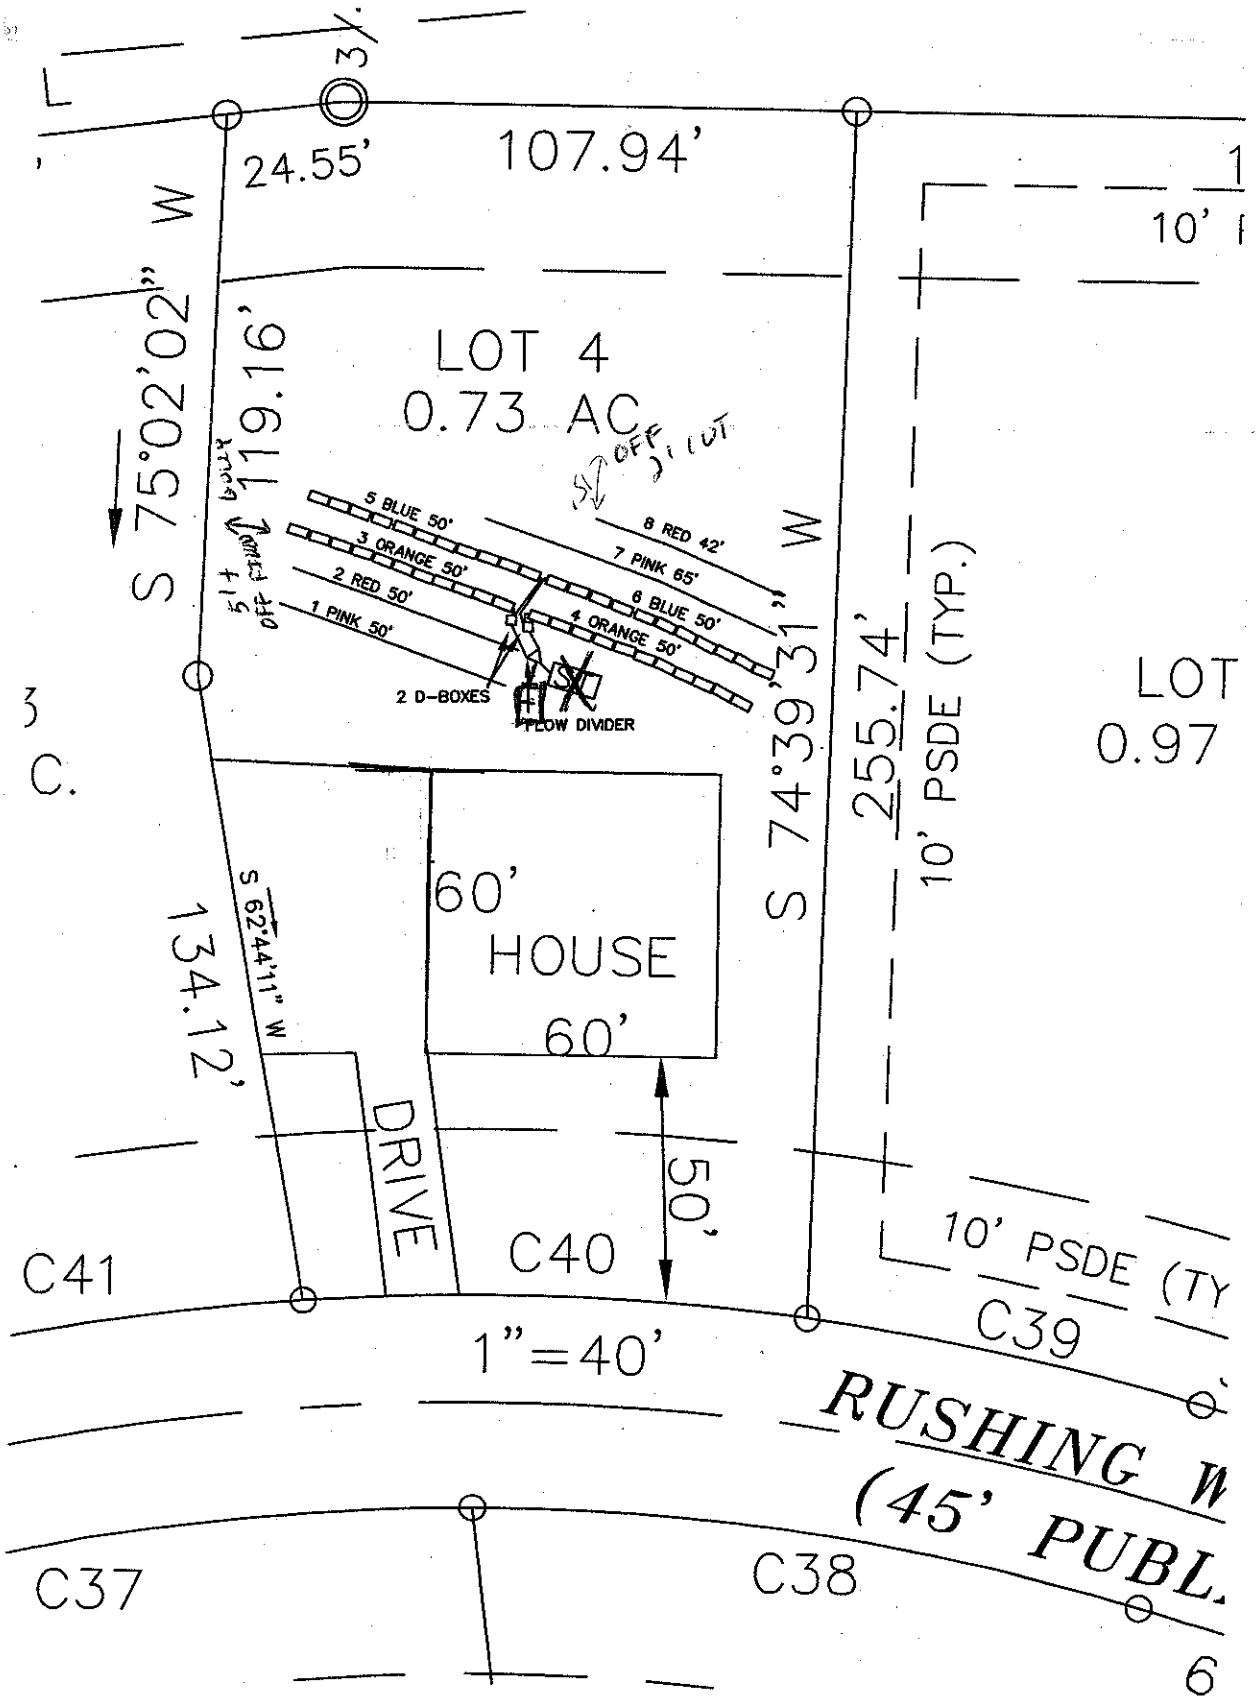

PLAN SUBMITTED BY
ROLLANS SOIL AND ENVIRONMENTAL

361-1085
Wyatt