118443

IREDELL COUNTY HEALTH DEPARTMENT

STATESVILLE 704-878-5305 MOORESVILLE 704-664-5281

IMPROVEMENT PERMIT / AUTHORIZATION TO CONSTRUCT / OPERATION PERMIT / EXISTING SYSTEM INSPECTION

PERMIT# 51-2-05-04 PIN# 4730-37-3313 DAVID CHANCEY DATE 7-20-04

OWNER OR CONTRACTOR FALLSTOWNE BAPTIST CHURCH PHONE: Business 704-507-7035 Home

ADDRESS 242 STATE PARK ROAD TROUTMAN, NC 28166

LOCATION PERTH ROAD SOUTH (R) STATE PARK 3/4 mile on RT

SUBDIVISION BLOCK / SECTION LOT LOT AREA 165,000 SqFt SITE CLASS. DESIGN FLOW EXISTING L.T.A.R. .5

Septic Tank: 1500 Gallons; STB Date

Pump Tank: Gallons; PT Date

Pump Make: Model Serial No.

Nitrification Field: No Fields 1 Square Feet 900' Linear Feet 300'

No Lines 3 Trench Width 36" Max Trench Bottom Depth Gravel Depth 12"

☐ New System ☐ Repair System Type: I (II) III, IV, V, VI

System Description: CONV GRAV

Repair System Description:

Maintenance Agreement Required: ☐ Yes ☒ No

☐ House/Mod. Home No. Bedrooms

☐ Mobile Home No. Bathrooms

☐ Business No. Employees

☒ Other CHURCH FELLOWSHIP


☐ Slab ☐ Crawl Space ☒ Basement w/plumbing ☐ Basement wo/plumbing

Water Supply: ☒ Individual ☐ Public ☐ Community


Comments:/Conditions: (1) THIS IS A PROPERLY FUNCTIONING SYSTEM IN USE, NO SIGNS OF FAILURE AT TIME OF CHECK. (2) FLOW IS NOT CHANGING (3) NEW BUILDING WILL BE JUST A STORAGE AREA

Comments:/Conditions: + FELLOWSHIP HALL. FLOW WILL REMAIN THE SAME, (3) MAINTAIN PROPER SETBACKS (4) BUILDING CODE MAY REQUIRE NEW SUPPLY LINE

INITIAL SITE SKETCH

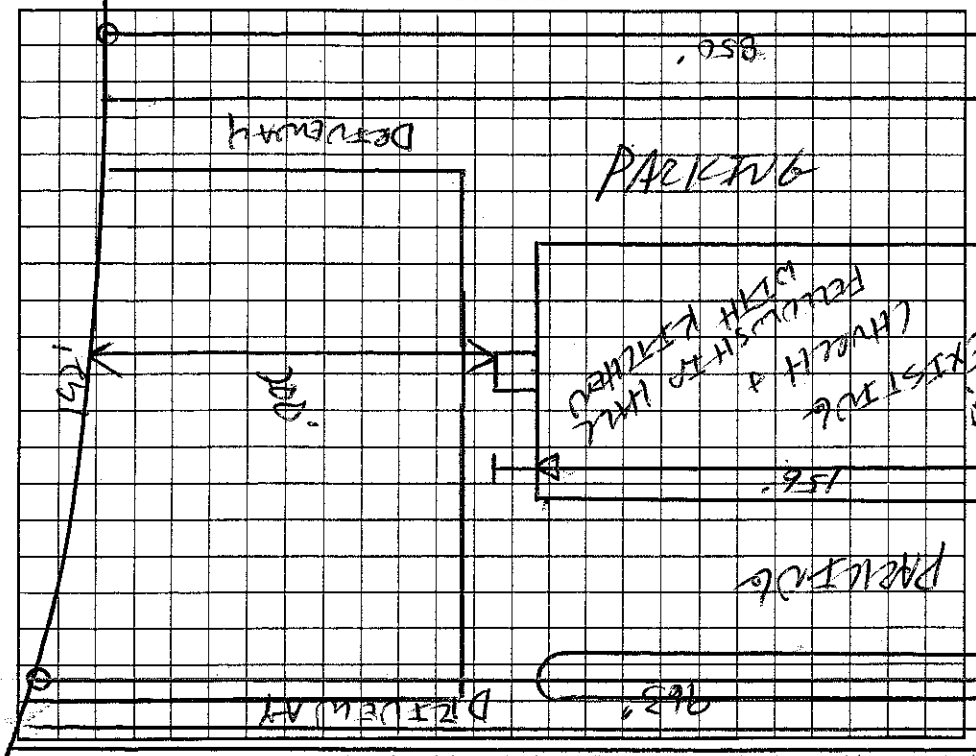

AS BUILT SKETCH

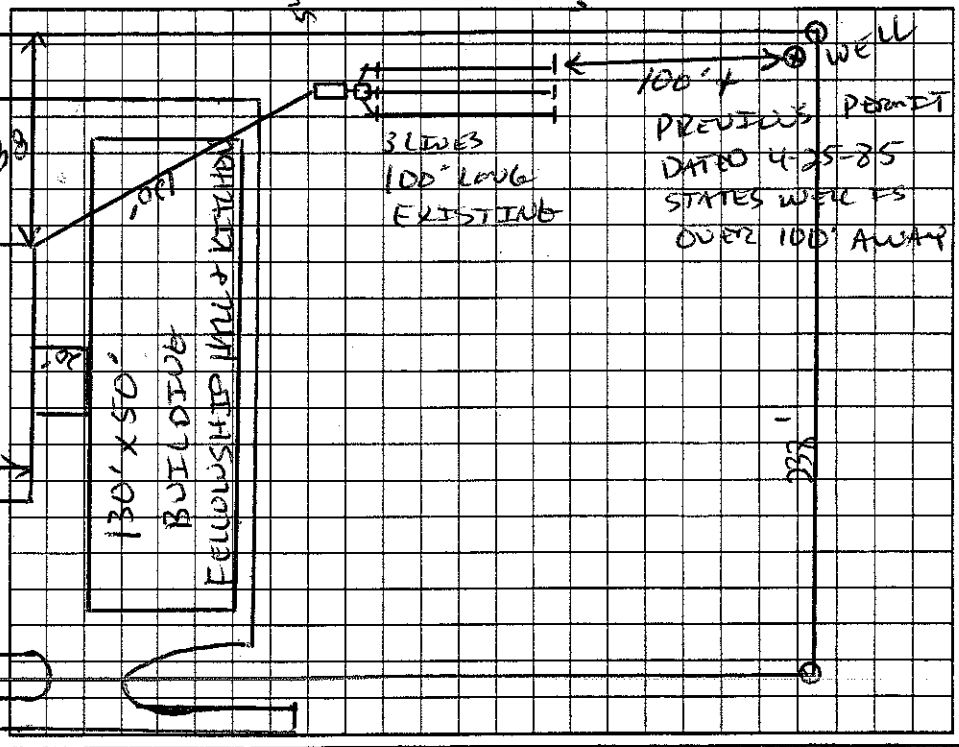

Permit can be suspended or revoked if any false information is supplied toward securing the permit/any unauthorized changes are made to the site/any unauthorized changes are made in the installation of the system. Improvement Permit with plat valid without expiration. Improvement Permit with site plan valid for sixty months. Authorization to Construct is valid for a period equal to that of Improvement Permit – not to exceed sixty months.

Signed: date 8/6/04 Installed by: AAA ENTERPRISES

Improvement Permit by: date Operation Permit by: date

Authorization to Construct by: date Existing System Inspection by: date 7-20-04

HEALTH DEPT. COPY: WHITE OWNER COPY (FINAL): YELLOW OWNER COPY (INITIAL): PINK