905466

IREDELL COUNTY HEALTH DEPARTMENT

STATESVILLE 704-878-5305 MOORESVILLE 704-664-5281

IMPROVEMENT PERMIT / AUTHORIZATION TO CONSTRUCT / OPERATION PERMIT / EXISTING SYSTEM INSPECTION

PERMIT# -2 TROUTMAN PIN# 4730 48 63 43 DATE 10/9/00

OWNER OR CONTRACTOR C & S ASSOCIATES PHONE: Business Home

ADDRESS 4474 LAKE DRIVE SHERRELLS FORD NC 28673

LOCATION PERTH CO - TR STATE PARK - TR MEADOW FALLS - AT END

SUBDIVISION MEADOW GLEN BLOCK / SECTION LOT 6 LOT AREA 1.6346AC SITE CLASS FS DESIGN FLOW 360GPD L.T.A.R. 1.35/1.62

Septic Tank: 1000 Gallons; STB 825 Date 8/7/00
Pump Tank: 1000 Gallons; PT 302 Date 8/1/00
Pump Make: ZOELLER Model 137 Serial No.
Nitrification Field: No Fields 1 Square Feet 900 Linear Feet 300
No Lines 3@100' Trench Width 36" Max Trench Bottom Depth 36" Gravel Depth

☐ ~~New~~ System ☐ Repair System Type: I, II, (III), IV, V, VI
System Description: PUMP 25% REDUCTION
Repair System Description: NONE
Maintenance Agreement Required: ☐ Yes ☒ ~~No~~

☐ ~~House~~/Mod. Home No. Bedrooms 3
☐ Mobile Home No. Bathrooms 2
☐ Business No. Employees
☐ Other


☐ Slab ☐ Crawl Space ☐ Basement w/plumbing ☐ Basement wo/plumbing

Water Supply:
☐ Individual
☒ ~~Public~~
☐ Community
TROUTMAN

Comments/Conditions: (REVISED PERMIT)

Comments/Conditions:

INITIAL SITE SKETCH 1" = 50'

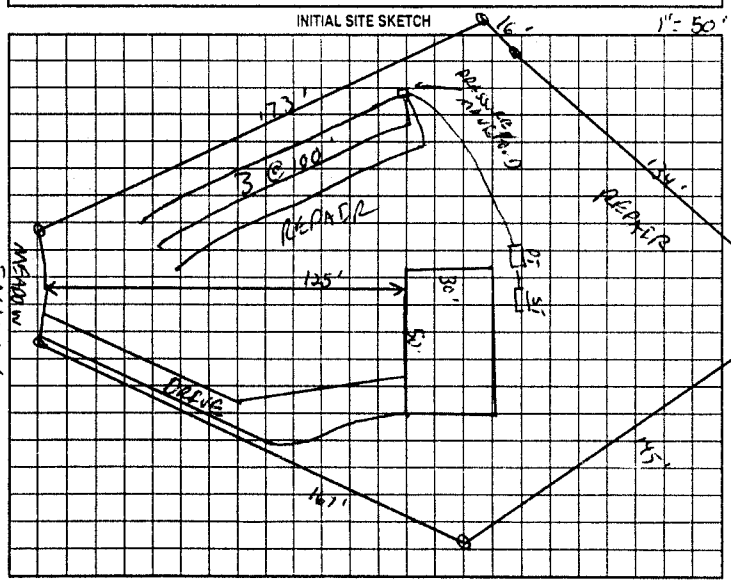

AS BUILT SKETCH

Permit can be suspended or revoked if any false information is supplied toward securing the permit/any unauthorized changes are made to the site/any unauthorized changes are made in the installation of the system. Improvement Permit with plat valid without expiration. Improvement Permit with site plan valid for sixty months. Authorization to Construct is valid for a period equal to that of Improvement Permit – not to exceed sixty months.

Signed: date

Improvement Permit by: [signature] RS date 10/9/00

Authorization to Construct by: [signature] RS date 10/9/00

Installed by: ROWAN SEPTEC

Operation Permit by: [signature] RS date 10/10/00

Existing System Inspection by: date

HEALTH DEPT. COPY: WHITE OWNER COPY (FINAL): YELLOW OWNER COPY (INITIAL): PINK