IREDELL COUNTY HEALTH DEPARTMENT

STATESVILLE 704-878-5305 (C.I.) MOORESVILLE 704-664-5281

IMPROVEMENT PERMIT / AUTHORIZATION TO CONSTRUCT / OPERATION PERMIT / EXISTING SYSTEM INSPECTION

PERMIT# TROUTMAN 112697 PIN# ~~4730-48-6343~~ 4730-38-5565 DATE 01/24/03

OWNER OR CONTRACTOR GERRY HUNT PHONE: Business 704-902-9000 ~~Home~~ TIM WHITTAKER 704-866-9540

ADDRESS P.O. BOX 134 TROUTMAN, NC 28611

LOCATION PERTH RD. (R) STATE PARK, (R) MEADOW GLEN, SHENANDOAH LP, FOLLOW SHENANDOAH TO KENTON COURT, PROPERTY @ END ON CUL-DE-SAC

SUBDIVISION MEADOW GLEN BLOCK / SECTION 4 LOT 99 LOT AREA 1.214 ACRES SITE CLASS. PS DESIGN FLOW 360 GPD L.T.A.R. 0.30 GPD/FT²

Septic Tank: 1,000 Gallons; STB 925 Date 4-23-03

Pump Tank: 1,000 Gallons; PT 302 Date 3-18-03

Pump Make: [illegible] Model [illegible] Serial No. L0468005

Nitrification Field: No Fields 1 Square Feet EQ to 1,200 Linear Feet 200

No Lines 3 Trench Width 24" Max Trench Bottom Depth 31" Gravel Depth N/A

☒ New System ☐ Repair System Type: I, II, III, (IV), V, VI

System Description: LOW PRESSURE, 50% REDUCTION

Repair System Description: LOW PRESSURE, 50% REDUCTION

Maintenance Agreement Required: ☒ Yes ☐ No

☒ House/Mod. Home ☐ Mobile Home ☐ Business ☐ Other ____

No. Bedrooms 3 No. Bathrooms 3 No. Employees ____


☐ Slab ☐ Crawl Space ☒ Basement w/plumbing ☐ Basement wo/plumbing

Water Supply: ☐ Individual ☒ Public ☐ Community

Comments:/Conditions: (1) INSTALL SYSTEM USING: 14 PANELS IN THE 60' LINE, 16 PANELS IN 70' LINES (USING 46 PANELS TOTAL)
* PRIOR TO BACK FILLING PUMP TANK A FINDING SHALL BE MADE THAT THE TANK IS WATER TIGHT (.1954(a)(4))
* SEE ATTACHED SHEETS FOR PUMP + PANEL INFO.

Comments:/Conditions: (2) HOME MUST BE PLACED IN PROPOSED LOCATION + NO GRADING OUTSIDE OF HOME + POSITIVE DRAINAGE AREA. (3) TANKS + LINES MUST BE PLACED WHERE SHOWN. (4) INSTALL LINES MAXIMUM TRENCH DEPTH 31". (5) CALL AFTER CLEARING FOR REFLAGGING.

INITIAL SITE SKETCH

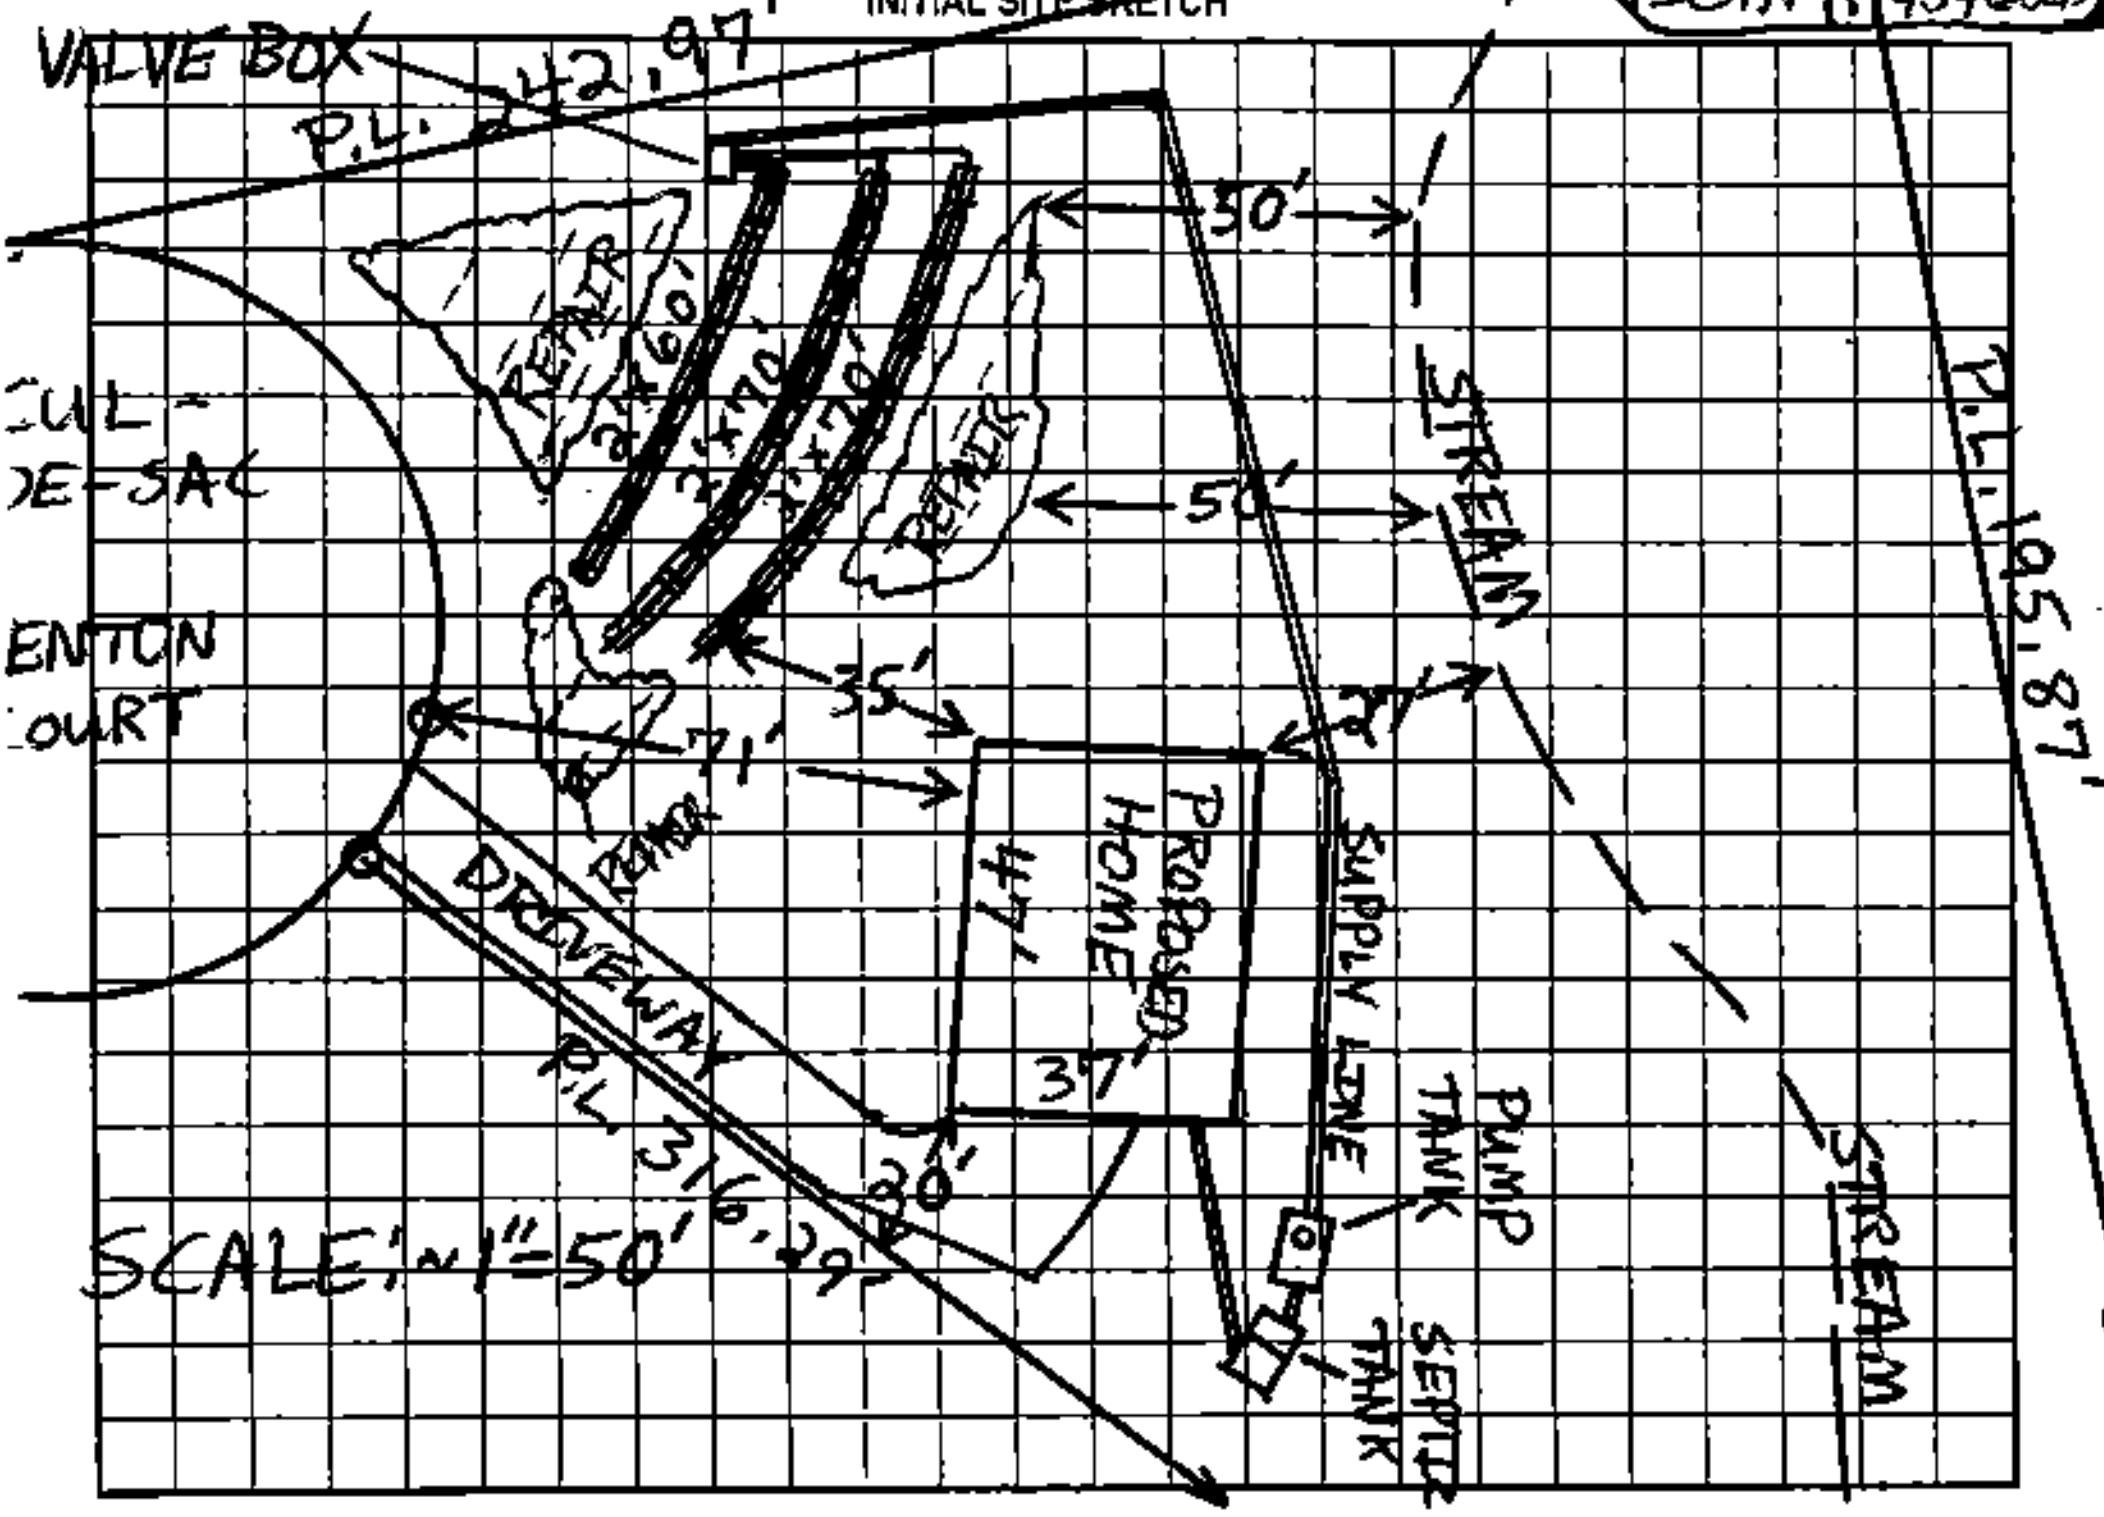

AS BUILT SKETCH

[illegible]
- lines okay, pressure check okay, Tanks okay
- Contract received 10/29/03 - WOJ

Installed As Shown per Initial Site Sketch

Permit can be suspended or revoked if any false information is supplied toward securing the permit/any unauthorized changes are made to the site/any unauthorized changes are made in the installation of the system. Improvement Permit with plat valid without expiration. Improvement Permit with site plan valid for sixty months. Authorization to Construct is valid for a period equal to that of Improvement Permit – not to exceed sixty months.

Signed: Gerry Hunt date 1-27-03 Installed by: Rowan Septic (8/27/03)

Improvement Permit by: Patrick Mitchell date 01/24/03 Operation Permit by: STEVE HEDRICK date 10-30-03

Authorization to Construct by: Patrick Mitchell date 01/27/03 Existing System Inspection by: ____ date ____

HEALTH DEPT. COPY-WHITE OWNER COPY (FINAL)-YELLOW OWNER COPY (INITIAL)-PINK