THIS PERMIT VOIDS PREVIOUS ISSUED 8-30-01

IREDELL COUNTY HEALTH DEPARTMENT

STATESVILLE 704-878-5305 MOORESVILLE 704-664-5281

IMPROVEMENT PERMIT / AUTHORIZATION TO CONSTRUCT / OPERATION PERMIT / EXISTING SYSTEM INSPECTION

PERMIT# Trauma 06442 PIN# 4730-38-7437 DATE 4-11-02

OWNER OR CONTRACTOR C & S ASSOCIATES PHONE: Business 704-202-4971 Home

ADDRESS 4474 LAKE DR SHERRILLS FORD NC 28673

LOCATION PERTH CH. ROAD TO STATE PARK ROAD, TR MEADOW GLEN DR, TL SHENANDOAH LOOP, LOT ON RIGHT AT KENTON COURT

SUBDIVISION MEADOW GLEN BLOCK / SECTION IV LOT 98 LOT AREA 0.5664 AC SITE CLASS PS DESIGN FLOW 360 LTAR 0.30 GPD/FT²

Septic Tank: 1000 Gallons: STB 825 Date 09/02/00
Pump Tank: 1000 Gallons: PT 302 Date 03/13/02
Pump Make: Zoeller Model N1-37 Serial No
Nitrification Field: No Fields 1 Square Feet 60 TO 1200 Linear Feet 300
No Lines FOUR Trench Width 36" Max Trench Bottom Depth 36" Gravel Depth N/A

✓New System Repair System Type I II III IV V
System Description 25% REDUCTION PUMP
Repair System Description 50% REDUCTION, LOW-PRESSURE
Maintenance Agreement Required Yes ✓No

✓House/Mod Home No Bedrooms 3
Mobile Home No Bathrooms 2
Business No Employees
Other


Water Supply: ☐ Individual ~~Public~~ ☐ Community

✓Slab ✓Crawl Space Basement w/plumbing Basement wo/plumbing


Comments:/Conditions: ① RUN WATER LINE TO LEFT SIDE OF DRIVEWAY KEEPING MINIMUM 10' FROM SYSTEM ② INSTALL 25% REDUCTION SYSTEM ③ SEE ATTACHED SHEETS FOR PUMP AND PRESSURE MANIFOLD REQUIREMENTS.

Comments Conditions ST-installed using risers, poly/sock filter

INITIAL SITE SKETCH

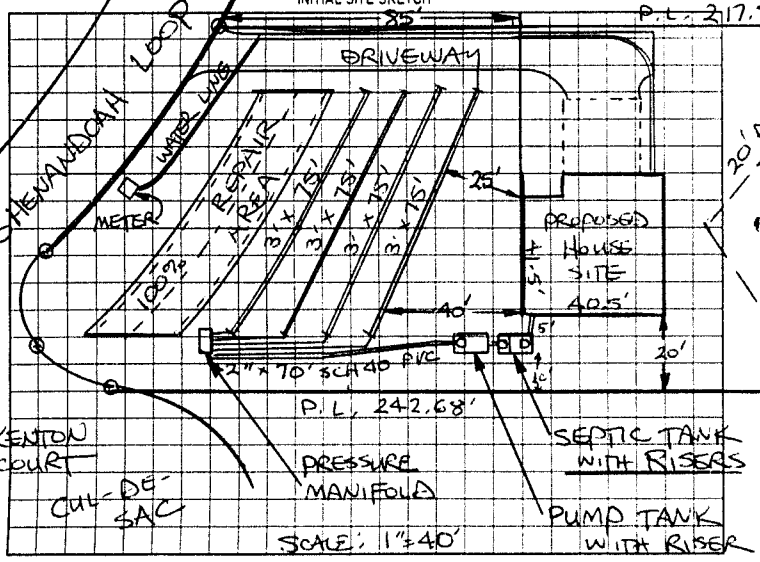

AS BUILT SKETCH

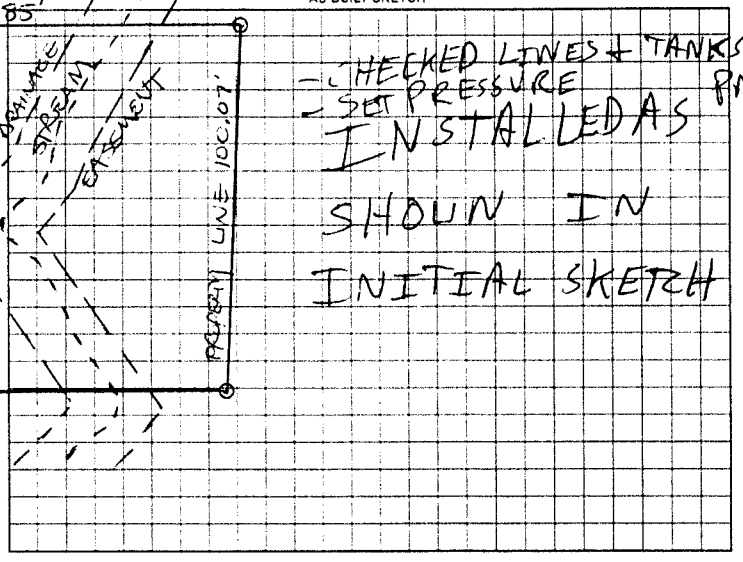

- CHECKED LINES + TANKS
- SET PRESSURE
INSTALLED AS SHOWN IN INITIAL SKETCH
PM

Permit can be suspended or revoked if any false information is supplied toward securing the permit, any unauthorized changes are made to the site, any unauthorized changes are made in the installation of the system. Improvement Permit with plat valid without expiration. Improvement Permit with site plan valid for sixty months. Authorization to Construct is valid for a period equal to that of Improvement Permit - not to exceed sixty months.

Signed: [signature] date 4-16-02 Installed by ROWAN SEPTIC

Improvement Permit by: STEVE HEDRICK date 4-11-02 Operation Permit by [signature] date 07/17/02

Authorization to Construct by: STEVE HEDRICK date 4-11-02 Existing System Inspection by date

HEALTH DEPT COPY WHITE OWNER COPY (FINAL) YELLOW OWNER COPY (INITIAL) PINK