106441 This permit voids Permit issued 8/2/01.

IREDELL COUNTY HEALTH DEPARTMENT

STATESVILLE 704-878-5305 (C) MOORESVILLE 704-664-5281

IMPROVEMENT PERMIT / AUTHORIZATION TO CONSTRUCT / OPERATION PERMIT / EXISTING SYSTEM INSPECTION

PERMIT# 080-5-0120/106441 PIN# 4730-48-6343 DATE 5/15/02

OWNER OR CONTRACTOR C T E Associates PHONE Business _____ Home _____

ADDRESS 4404 Lake Drive Sherrills Ford, N.C. 28673

LOCATION State Park Rd, (R) into Meadow Glenn to end Bear left Shenandoah (R) Kenton Ct. on Right - Corner lot

SUBDIVISION Meadow Glenn BLOCK / SECTION 4 LOT 102 LOT AREA .6692 Ac SITE CLASS V5 DESIGN FLOW 360 L.T.A.R. -3

Septic Tank: 1,000 Gallons: STB 825 Date 4-18-02
Pump Tank: 1,000 Gallons, PT 302 Date 2-08-02
Pump Make: Goulds Model N-740 Serial No —
Nitrification Field: No Fields 1 Square Feet 400 Linear Feet 200
No Lines 4 @ 50' Trench Width 24"-30" Max Trench Bottom Depth 36" Gravel Depth N/A

X New System ☐ Repair System Type I II III IV V
System Description: LPP PPBPS
Repair System Description: LP PPBPS
Maintenance Agreement Required X Yes ☐ No

X House/Mod Home ☐ Mobile Home ☐ Business ☐ Other
No. Bedrooms 3 No. Bathrooms 2 No. Employees ____
☐ Slab X Crawl Space ☐ Basement w/plumbing ☐ Basement wo/plumbing


Water Supply: ☐ Individual X Public ☐ Community

Comments/Conditions: (1) See attachments (2) must have signed operation agreement for system.


Comments/Conditions: CHANGED TO PRESSURE MANIFOLD. NEED TO REDRAW & CHANGE TO TYPE III.

1" = 50'

INITIAL SITE SKETCH

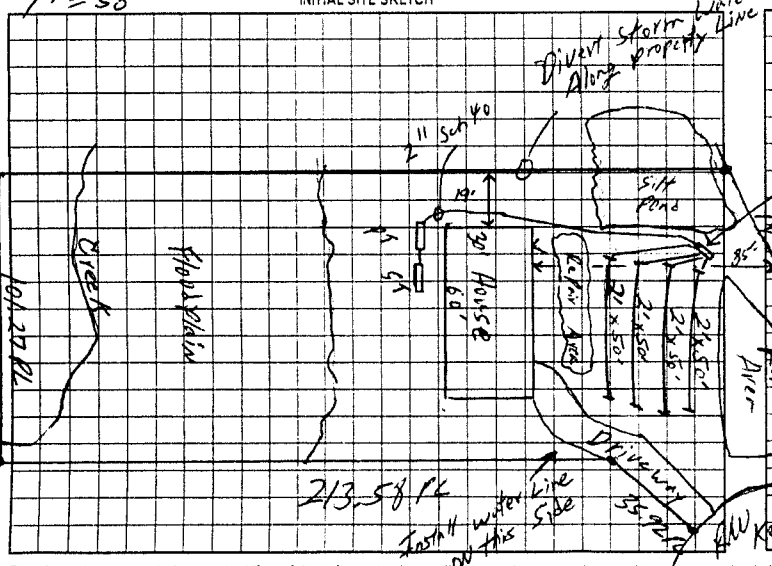

AS BUILT SKETCH

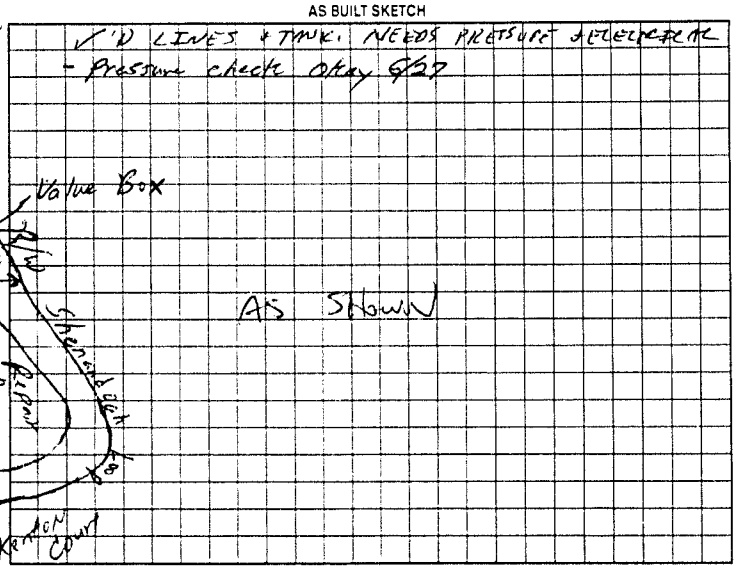

Permit can be suspended or revoked if any false information is supplied toward securing the permit/any unauthorized changes are made to the site any unauthorized changes are made in the installation of the system. Improvement Permit with plat valid without expiration. Improvement Permit with site plan valid for sixty months. Authorization to Construct is valid for a period equal to that of Improvement Permit - not to exceed sixty months

Signed: Kenneth R Cox date 4/22/02 Installed by ROWAN SEPTIC

Improvement Permit by: William G. Johnson date 5/15/02 Operation Permit by STEVE HEARICK date 7-23-02

Authorization to Construct by: William G. Johnson date 5/15/02 Existing System Inspection by: _____ date _____

HEALTH DEPT COPY WHITE OWNER COPY (FINAL) YELLOW OWNER COPY (INITIAL) PINK