Permit # 208888

IREDELL COUNTY HEALTH DEPARTMENT

STATESVILLE 704-878-5305 MOORESVILLE 704-664-5281

IMPROVEMENT PERMIT / AUTHORIZATION TO CONSTRUCT / OPERATION PERMIT / EXISTING SYSTEM INSPECTION

PERMIT# 09-P-03-08 PIN# ~~4730-48-0243~~ 4730-38-8326 DATE 3-31-08

OWNER OR APPLICANT DPG Properties LLC PHONE: Business 443-745-2222 Home

ADDRESS 916B Fair OAKS Drive Statesville Ford NC 28673

LOCATION PERTH RD (B) State Park (R) MEADOW GLEN (L) SHERMAN DRAFT ON LEFT

SUBDIVISION MEADOW GLEN BLOCK / SECTION LOT 94 LOT AREA .817 SITE CLASS. PS DESIGN FLOW 360 L.T.A.R. 125

Septic Tank: 1000 Gallons; STB 825-1000 Date 2-20-15
Pump Tank: 1000 Gallons; PT 302-1000 Date 3-4-15
Pump Make: Zoeller Model N152-B Serial No. 152-6010
Nitrification Field: No Fields ___ Square Feet ___ Linear Feet 360'
No Lines 5X72' Trench Width 36' Max Trench Bottom Depth 24' Gravel Depth N/K ☐ Gravity ☒ Pressure

☒ New System ☐ Repair ☐ Expansion System Type: I II (III) IV V VI
System Description: PUMP 25% REDUCTION
Repair System Description: LP 50% REDUCTION
Maintenance Agreement Required: ☐ Yes ☒ No

☒ House/Mod. Home ☐ Mobile Home ☐ Business ☐ Other
No. Bedrooms 3 No. Persons 6 No. Employees ___

Water Supply: ☐ Individual ☒ Public ☐ Community

☐ Slab ☐ Crawl Space ☒ Basement w/plumbing ☐ Basement wo/plumbing

Comments/Conditions:
(1) Note MAXIMUM TRENCH BOTTOM DEPTH
(2) MINIMUM SETBACKS, TANKS MUST BE 15' FROM BASEMENT (SIDESLOPE) & 50' from Creek
(3) ROOF DESIGN MANUAL BY SOME (4) SYSTEM

Comments/Conditions: MUST BE 25' UPSLOPE FROM BASEMENT DRAIN AND 15' OFF SIDESLOPE OF BASEMENT DRAIN
(5) KEEP HOUSE OUT OF GROUND & BACKFILL FOR Positive Drainage PERMITS.

INITIAL SITE SKETCH

SEE ATTACHED SYSTEM DESIGN BY SOME, INC CONSULTING

	Date	Initials
Drain Lines Checked	7-6-15	JH
Tanks Checked	7-6-15	JH
Pressure Manifold or Valve Box Checked	7-6-15	JH
Pressure Head Set	7-6-15	JH
Electrical Checked	7-22-15	JH
Floats Set	7-22-15	JH
Alarm Checked	7-22-15	JH
Maintenance Contract Y / N	N/A	

AS BUILT SKETCH

- Blue Tuf-Tite Units installed
- Black - W. Chambers installed


Permit can be suspended or revoked if any false information is supplied toward securing the permit/any unauthorized changes are made to the site/any unauthorized changes are made in the installation of the system. Improvement Permit with plat valid without expiration ☐ Improvement Permit with site plan valid for sixty months ☒ Authorization to Construct is valid for a period equal to that of Improvement Permit – not to exceed sixty months.

Signed: Gary M. Brown date 3/31/08 Installed by: Rowan Septic

Improvement Permit by: ___ date 3-31-08 Operation Permit by: Mitch Henderson date 7-22-15

Authorization to Construct by: ___ date 03/13/15 Existing System Inspection by: ___ date ___

HEALTH DEPT. COPY: WHITE OWNER COPY (FINAL): YELLOW OWNER COPY (INITIAL): PINK

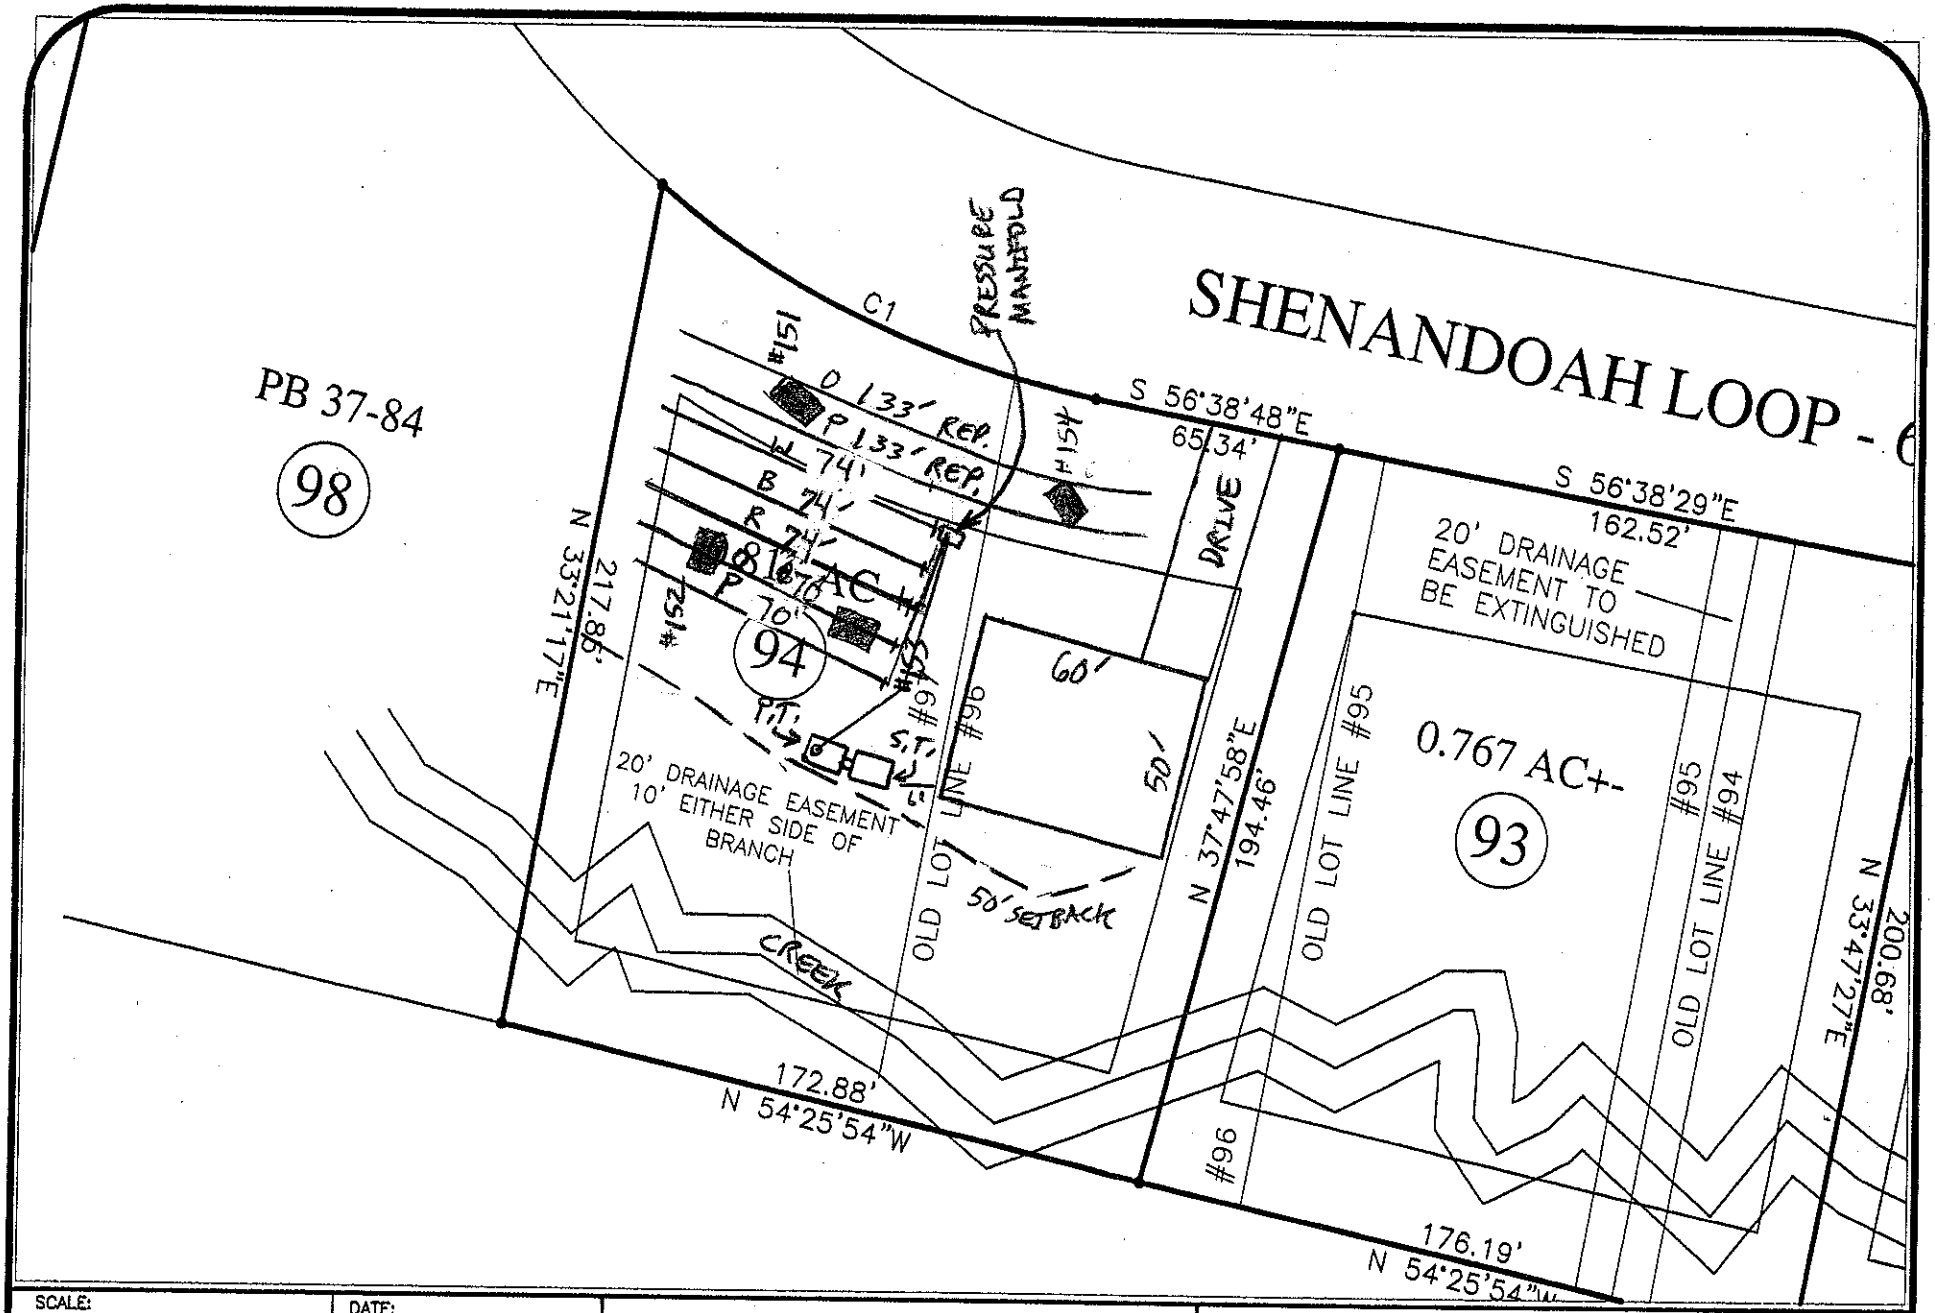

SCALE: 1" = 50'	DATE: 03/20/2008	S&ME	Lot 94	FIGURE NO. 1
PROJECT NO. 1588-08-015	DRAWN BY: PLM	3718 OLD BATTLEGROUND ROAD GREENSBORO, NC 27410 PH. 336-288-7180 FAX. 336-288-8980 WWW.SMEINC.COM	Meadow Glen Subdivision Iredell County, NC	
	CHECKED BY: PGP			