# 105911

# IREDELL COUNTY HEALTH DEPARTMENT

THIS PERMIT VOIDS PREVIOUS ISSUED 7-2-01

STATESVILLE 704-878-5305 / MOORESVILLE 704-664-5281

## IMPROVEMENT PERMIT / AUTHORIZATION TO CONSTRUCT / OPERATION PERMIT / EXISTING SYSTEM INSPECTION

PERMIT# TRADITION PIN# 4730-48-6343

OWNER OR CONTRACTOR C & S ASSOCIATES DATE 2-8-02

ADDRESS 4474 LAKE DR, SHERRILLS FORD NC 28673 PHONE: Business 704-202-4971 Home 704-876-6162

LOCATION STATE PARK ROAD, TR MEADOW GLEN DRIVE, TL SPRING LAKE DR, LOT AT END ON RIGHT

SUBDIVISION MEADOW GLEN BLOCK / SECTION IV LOT 74 LOT AREA 15,502 FT² SITE CLASS PS DESIGN FLOW 360 L.T.A.R. 0.30 GPD/FT²

Septic Tank: 1000 Gallons: STB 825 Date 4-2-02

Pump Tank: _____ Gallons, PT _____ Date _____

Pump Make: _____ Model _____ Serial No _____

Nitrification Field: No Fields 1 Square Feet EQ. TO 1200 Linear Feet 200

No Lines FOUR Trench Width 24" Max Trench Bottom Depth 36" Gravel Depth SAND 6"

✓ New System ☐ Repair System Type: I. II. III. IV. V.

System Description: 50% REDUCTION, SPAN

Repair System Description: 50% REDUCTION, LOW-PRESSURE

Maintenance Agreement Required: ☐ Yes ✓ No

✓ House/Mod. Home No. Bedrooms 3

☐ Mobile Home No. Bathrooms 2

☐ Business No. Employees _____

☐ Other _____

☐ Slab ☐ Crawl Space ☐ Basement w/plumbing ☐ Basement wo/plumbing

Water Supply: ☐ Individual ✓ Public ☐ Community


Comments/Conditions: INSTALL 50% REDUCTION SYSTEM AS SHOWN USING 44 PPBPS PANELS

FLOW DIVIDER


Comments/Conditions: Polylok Fifty Installed - Installed 44 PPBPS W/Flow Dividers

INITIAL SITE SKETCH

SCALE: 1" = 30'

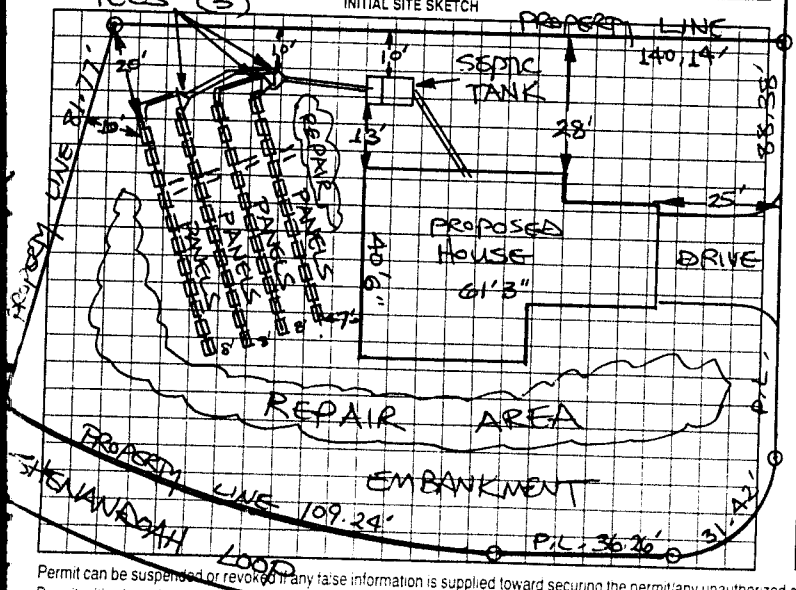


AS BUILT SKETCH

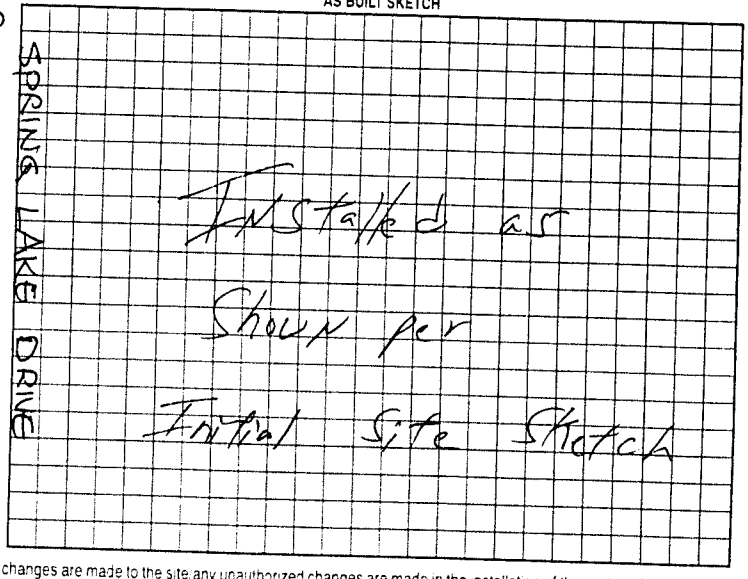


Permit can be suspended or revoked if any false information is supplied toward securing the permit; any unauthorized changes are made to the site; any unauthorized changes are made in the installation of the system. Improvement Permit with plat valid without expiration. Improvement Permit with site plan valid for sixty months. Authorization to Construct is valid for a period equal to that of Improvement Permit – not to exceed sixty months.

Signed: Eugene K Cecil date 2/14/02 Installed by: Rowan Septic

Improvement Permit by: STEVE HEDRICK date 2-8-02 Operation Permit by: William G Johnson date 7-2-02

Authorization to Construct by: STEVE HEDRICK date 2-8-02 Existing System Inspection by: _____ date _____

HEALTH DEPT COPY WHITE OWNER COPY (FINAL) YELLOW OWNER COPY (INITIAL) PINK