IREDELL COUNTY HEALTH DEPARTMENT

STATESVILLE 704-878-5305 300.00 Paid MOORESVILLE 704-664-5281

IMPROVEMENT PERMIT / AUTHORIZATION TO CONSTRUCT / OPERATION PERMIT / EXISTING SYSTEM INSPECTION

PERMIT# -2- Trantham #108156 PIN# ~~4930-48-6343~~ 473038-9638 DATE March 29, 01

OWNER OR CONTRACTOR C&S Associates PHONE: Business (704) 202-4971 Home

ADDRESS 4474 Lake Dr. Sherrills Ford, N.C. 28673

LOCATION State Park Rd. TR into Meadow Glen go to end bear left on Shenandoah on left

SUBDIVISION Meadow Glen BLOCK / SECTION 4 LOT 89 LOT AREA .42 Ac SITE CLASS. PS DESIGN FLOW 360gpd L.T.A.R. .3

Septic Tank: 1000 Gallons; STB 825 Date ~~08~~/05/02
Pump Tank: 1000 Gallons; PT 302 Date 06/05/02
Pump Make: ZEBEL Model N-98 Serial No. 98-060
Nitrification Field: No Fields 1 Square Feet 400 Linear Feet 200
No Lines 5@40' Trench Width 24", 8'oc Max Trench Bottom Depth 36" Gravel Depth N/A

☑ New System ☐ Repair System Type: I, II, III, IV, V, VI
System Description: pm PPBPS
Repair System Description: LP PPBPS
Maintenance Agreement Required: ☐ Yes ☑ No initially

☑ House/Mod. Home No. Bedrooms 3
☐ Mobile Home No. Bathrooms 2
☐ Business No. Employees
☐ Other
☐ Slab ☑ Crawl Space ☐ Basement w/plumbing ☐ Basement wo/plumbing


Water Supply: ☐ Individual ☐ Public ☐ Community

Comments:/Conditions: House Size 47'6" x 31"

Comments:/Conditions: SEPTIC TANK INSTALLED USING POLY-LOC FILTER & SEPTIC MARKER

INITIAL SITE SKETCH

1"=50'

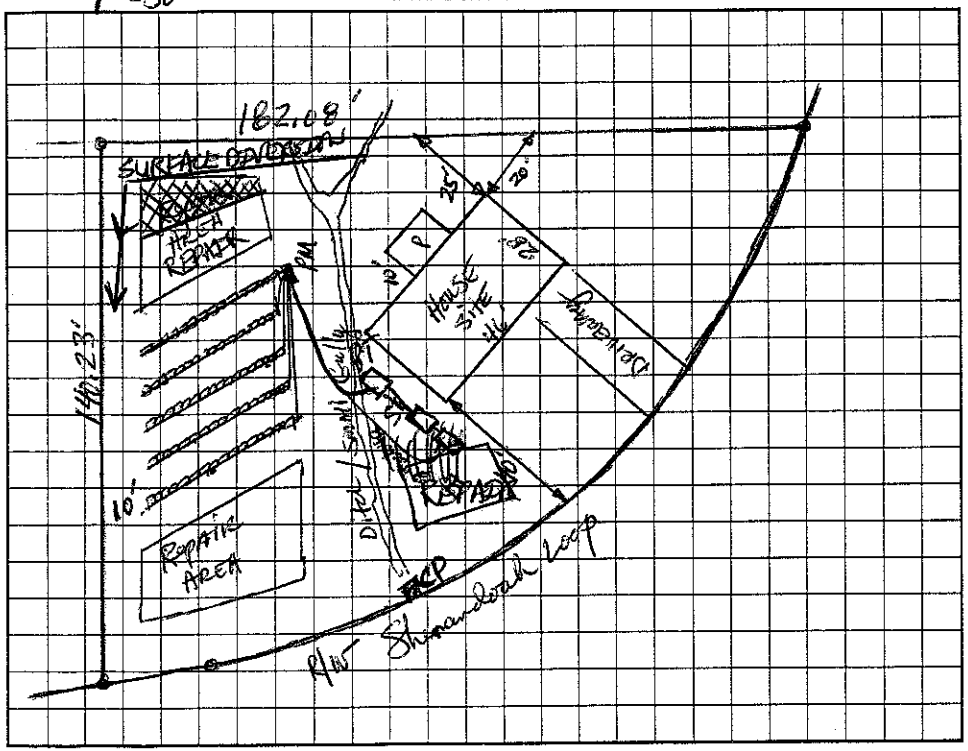

AS BUILT SKETCH

*UNAUTHORIZED SURFACE DIVERSION DITCH CUT IN REPAIR AREA, CHANGING SOME REPAIR TO BE MOVED.

SYSTEM INSTALLED AS SHOWN IN INITIAL SITE SKETCH

- Checked Lines
- SET PRESSURE
- PUMP INFO 9-25-02 PM

Permit can be suspended or revoked if any false information is supplied toward securing the permit/any unauthorized changes are made to the site/any unauthorized changes are made in the installation of the system. Improvement Permit with plat valid without expiration. Improvement Permit with site plan valid for sixty months. Authorization to Construct is valid for a period equal to that of Improvement Permit – not to exceed sixty months.

Signed: Virginia Cain date 4/2/01
Improvement Permit by: David Hartman IPS date 3-29-01
Authorization to Construct by: William C. Johnson date 7/24/02

Installed by: ROWAN SEPTIC - 09/25/02
Operation Permit by: Patrick Mitchell date 02/24/03
Existing System Inspection by: date

HEALTH DEPT. COPY: WHITE OWNER COPY (FINAL): YELLOW OWNER COPY (INITIAL): PINK