IREDELL COUNTY HEALTH DEPARTMENT

STATESVILLE 704-878-5305 300.00 Pd MOORESVILLE 704-664-5281

IMPROVEMENT PERMIT / AUTHORIZATION TO CONSTRUCT / OPERATION PERMIT / EXISTING SYSTEM INSPECTION

PERMIT# ? Trantman Zoning 106223 PIN# 4730-46-6343

OWNER OR CONTRACTOR C & S Associates PHONE: Business 202-4971 Home DATE Oct 30, 01

ADDRESS 4474 LAKE DR Shenandoah Ford N.C. 28673

LOCATION STATE PARK 12A TR Meadow Glen DR. to End TL Shenandoah Loop on left

SUBDIVISION Meadow Glen BLOCK / SECTION 4 LOT 88 LOT AREA .37Ac SITE CLASS PS DESIGN FLOW 360gpd L.T.A.R. .03

Septic Tank: 1000 Gallons, STB 825 Date 06/02/02

Pump Tank: 1000 Gallons, PT 302 Date 06/11/02

Pump Make: Zoeller Model N-98-003 Serial No

Nitrification Field: No Fields 1 Square Feet 432/600 Linear Feet 200

No Lines 4@50' Trench Width 24" MIN Std Max Trench Bottom Depth 36" Gravel Depth N/A

☑ New System ☐ Repair System Type: I. II (III) IV. V. VI

System Description 1in PPBPS

Repair System Description: LPPPBPS

Maintenance Agreement Required: ☐ Yes ☑ No initially

☐ House/Mod Home No. Bedrooms 3

☐ Mobile Home No. Bathrooms 2

☐ Business No. Employees

☐ Other

☐ Slab ☑ Crawl Space ☐ Basement w/plumbing ☐ Basement wo/plumbing

Water Supply: ☐ Individual ☐ Public ☐ Community


Comments/Conditions: OR 36" MAX 90c

26x32' House 4 Bed 10x12' - Okay


Comments/Conditions SEPTIC TANK INSTALLED USING MARKER & POLY-LOC FILTER.

- LINES CHECKED & PRESSURE SET 08/20/02 PM
- TANKS CHECKED - PM 08/20/02

INITIAL SITE SKETCH

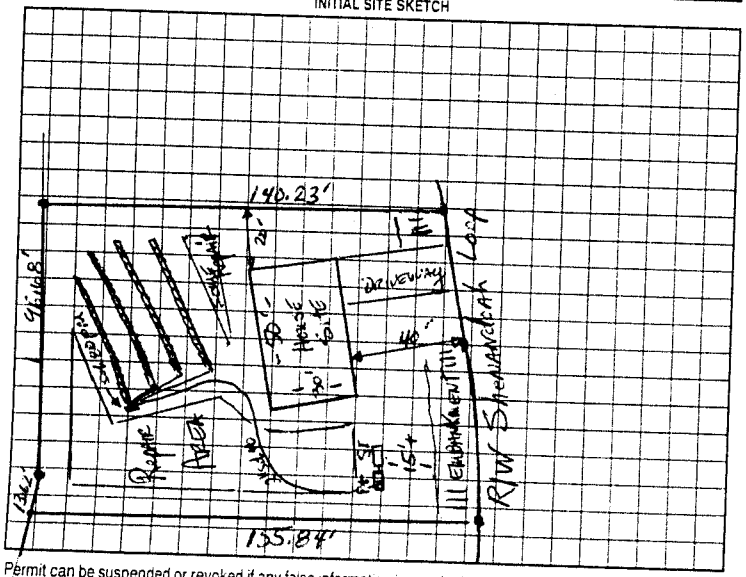

AS BUILT SKETCH

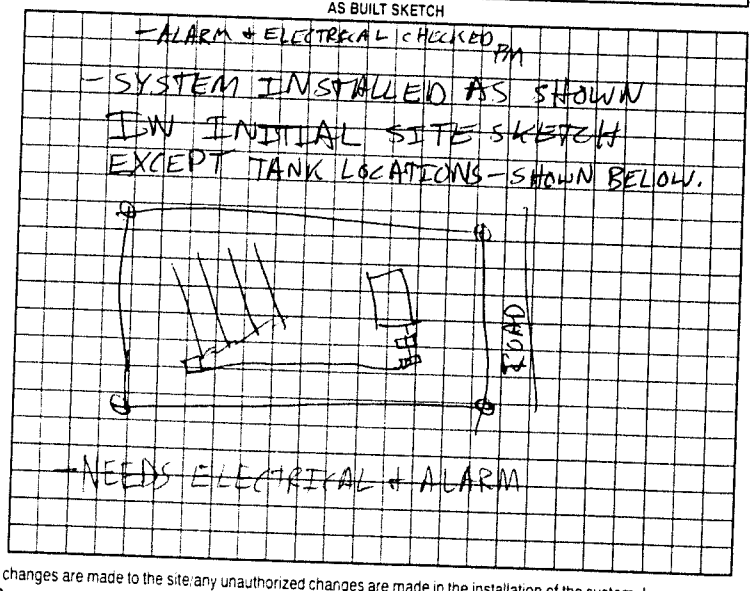

Permit can be suspended or revoked if any false information is supplied toward securing the permit; any unauthorized changes are made to the site; any unauthorized changes are made in the installation of the system. Improvement Permit with plat valid without expiration. Improvement Permit with site plan valid for sixty months. Authorization to Construct is valid for a period equal to that of Improvement Permit – not to exceed sixty months.

Signed LaVerne Stamey Jerry Hunt date 11-14-01

Improvement Permit by: [signature] date 10-30-01

Authorization to Construct by: [signature] date 4-16-02

Installed by: ROWAN SEPTIC

Operation Permit by: Patrick Mitchell date 08/29/02

Existing System Inspection by: date

HEALTH DEPT COPY WHITE OWNER COPY (FINAL) YELLOW OWNER COPY (INITIAL) PINK