# IREDELL COUNTY HEALTH DEPARTMENT

Not on Computer

STATESVILLE 704-878-5305 MOORESVILLE 704-664-5281

52055

## IMPROVEMENT PERMIT / CERTIFICATE OF COMPLETION / OPERATION PERMIT / EXISTING SYSTEM INSPECTION

PROPERTY DESCRIPTION NO. Town of Troutman DATE 6-27-94 TAX MAP NO. 3HA6 4730-39-0739 Watershed: ☐ Yes ☑ No

OWNER OR CONTRACTOR Terry Cloer PHONE: Business Home 872-3749

ADDRESS 133 Henderson Dr., Statesville, N.C. 28677

LOCATION From Troutman TR Talley Rd. TL Lytton Rd. Lot on L ± 1/4 mile after pavement turns to gravel

SUBDIVISION NA BLOCK / SECTION – LOT – LOT AREA 200' X 322' SITE CLASS. P.S. DESIGN FLOW 360 J L.T.A.R. - 3 gpd/ft²

Septic Tank: 1000 Gallons; STB 825 Date 5-20-94

Pump Tank: 1000 Gallons; PT 47-1087 Date 7-20-94

Pump Make: Zoeller Model 163 ½ hp Serial No. 163-0002

Nitrification Field: No Fields 1 Square Feet 400 Linear Feet 200' panels

No Lines 6 Trench Width 24" Max Trench Bottom Depth 30" Gravel Depth 24"

☑ New System ☐ Repair System Type: I, II, III, (IV) V, VI

System Description: Pressure dosed PPBPS

Repair System Description: LPP

Maintenance Agreement Required: ☑ Yes ☐ No

☐ House/Mod. Home ☑ Mobile Home ☐ Business ☐ Other

No. Bedrooms 3 No. Bathrooms 2 No. Employees


☐ Slab ☑ Crawl Space ☐ Basement w/plumbing ☐ Basement wo/plumbing

Water Supply: ☑ Individual ☐ Community ☐ Public

Comments: Permit issued 3-31-94 void due to disturbance of area where original system was to be installed. (cutting). Install 200' of pressure dosed PPBPS. Install PPBPS 8'O.C. and on contour. Keep system 15' from cut, 10' from property lines, and min. 50' from well. Install PPBPS no deeper than 30" to trench bottom. Install pump that will deliver 30 GPM at 20 TDH. (See Attached)

Comments: Checked PPBPS lines, pump, pump tank, septic tank, 2' pressure head, on 9-29-94. Checked floats, NEMA 4X Box, Alarm, conduit sealed valves in pump tank, and 6" above grade for riser and NEMA 4X Box on 10-19-94. Well located in different area than shown on permit (in field)

INITIAL SITE SKETCH

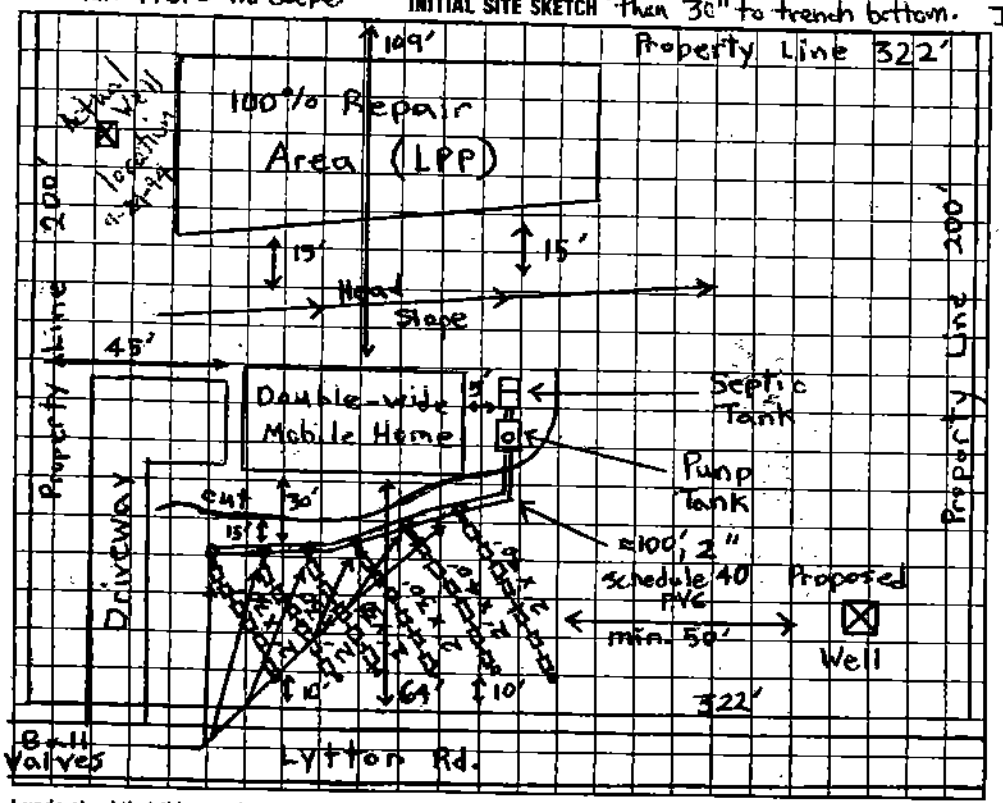


AS BUILT SKETCH

If system needs repair, 100% Repair Area behind home (LPP).

* Maintenance Agreement Required

Install 4" panels, 1 hole per panel. (3/11" holes)

* Joe Lynn reviewed this permit *

Area is too close to well site. Must have to abandon well at that time and relocate it.

pump tank had small leak, sure welled on 9-29-94

Maintenance agreement contract collected 10-19-94

SAME AS INITIAL SKETCH

* Actual well location shown on initial drawing *

I understand that this permit can be suspended or revoked if any false information is supplied toward securing the permit/any unauthorized changes are made to the site/any unauthorized changes are made in the installation of the system. Improvement Permit is valid for 60 months from date of issuance.

Signed: Terry Cloer

Improvement Permit by: Michael L. Dennis date 7-5-94

Existing System Inspection by: _____ date _____

Installed by: Rowan Septic Tank

Certificate of Completion by: _____ date _____

Operation Permit by: Michael L. Dennis date 10-19-94

HEALTH DEPT. COPY: WHITE INSPECTION COPY (FINAL): GREEN OWNER COPY (FINAL): YELLOW INSPECTION COPY (INITIAL): PINK OWNER COPY (INITIAL): GOLD