IREDELL COUNTY HEALTH DEPARTMENT

Quanita Sawyers

STATESVILLE 704-878-5305 MOORESVILLE 704-664-5281

46964

IMPROVEMENT PERMIT / CERTIFICATE OF COMPLETION / OPERATION PERMIT / EXISTING SYSTEM INSPECTION

PROPERTY DESCRIPTION NO. 16133 DATE 8-12-93

OWNER OR CONTRACTOR Shaw Const. PHONE: Business 528-4494 TAX MAP NO. 3F-13-A

ADDRESS Home

LOCATION From Troutman take Perth Rd TR State Park Rd TL Hunnexcutt Rd. TR Briar Fox TL into Capt. Cove Lot #15

SUBDIVISION Capt. Cove BLOCK / SECTION LOT 15 LOT AREA ±110' x 240' SITE CLASS. P.S. L.T.A.R. .35 gpd/ft²

Water Supply: ☑ Individual ☐ Community ☐ Public Well

Septic Tank: 1000 Gallons; STB 794 Date 7-1-93

Pump Tank: — Gallons; PT — Date —

Nitrification Field: No Fields 1 Square Feet 1035 Linear Feet 345'

☑ No Lines 4 Trench Width 36" Trench Depth 24"-30" Gravel Depth 12"

☑ New System ☐ Repair System Type: I. (II.) III. IV. V. VI

System Description: Conventional, gravity

Repair System Description: PPBPS, gravity

Maintenance Agreement Required: ☐ Yes ☑ No

☑ House/Mod. Home No. Bedrooms 3

☐ Mobile Home No. Bathrooms 3.5

☐ Business No. Employees —

☐ Other

Garbage Disposal: ☐ Yes ☑ No

Auto. Dishwasher: ☑ Yes ☐ No

Auto. Washing Machine: ☑ Yes ☐ No


Other

☐ Slab ☐ Crawl Space ☑ Basement w/plumbing ☐ Basement wo/plumbing

Comments Retaining walls were not taken into consideration when system was permitted. This caused 100% Repair to be PPBPS, gravity fed. Only corners of home were staked off and not the ends of wall.

INITIAL SITE SKETCH

AS BUILT SKETCH

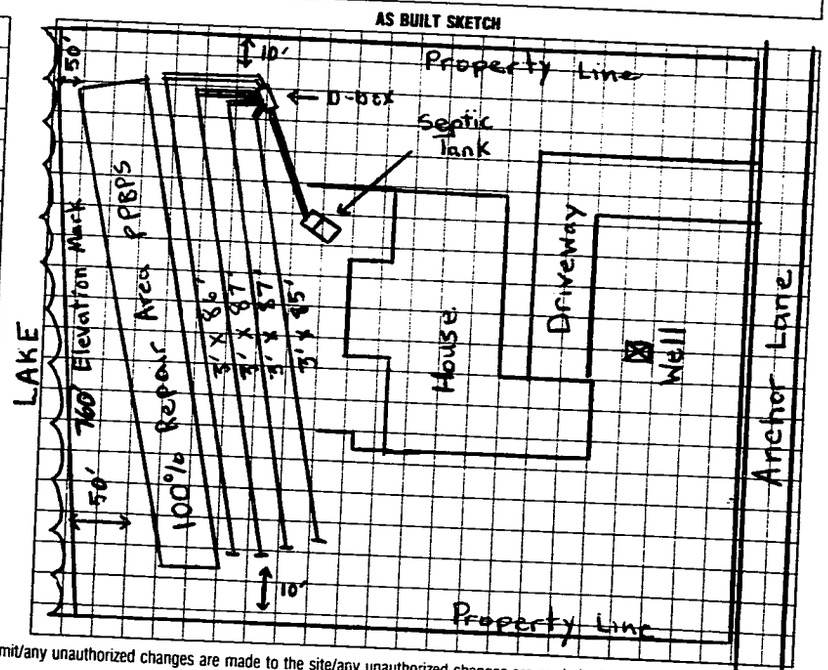

I understand that this permit can be suspended or revoked if any false information is supplied toward securing the permit/any unauthorized changes are made to the site/any unauthorized changes are made in the installation of the system. Improvement Permit is valid for 60 months from date of issuance.

Signed:

Improvement Permit by: Michael J. Dennis date 4-16-93

Existing System Inspection by: date

Installed by: Wes Lytton

Certificate of Completion by: Michael J. Dennis date 8-12-93

Operation Permit by: date

HEALTH DEPT. COPY: WHITE INSPECTION COPY (FINAL): GREEN OWNER COPY (FINAL): YELLOW INSPECTION COPY (INITIAL): PINK OWNER COPY (INITIAL): GOLD