PLAT# 4730-40-8651

50753

IREDELL COUNTY HEALTH DEPARTMENT
STATESVILLE 704-878-5305 MOORESVILLE 704-664-5281

IMPROVEMENT PERMIT / CERTIFICATE OF COMPLETION / OPERATION PERMIT / EXISTING SYSTEM INSPECTION

PROPERTY DESCRIPTION NO. 7783 DATE 1-13-95 TAX MAP NO. 3F-13-A-17 Watershed: ☐ Yes ☑ No

OWNER OR CONTRACTOR Richard A. Stankwytch PHONE: Business 872-9566 Home (910) 766-3079

ADDRESS 5487 Morgans Lane Clemmons, N.C. 27012

LOCATION From Troutman take Perth Rd. TR State Park Rd. TL Honeycutt Rd. TR Briar Fox TL Capt. Way TL Anchor Lane Lot on R.

SUBDIVISION Capt. Cove. BLOCK / SECTION LOT 17 LOT AREA 105' X 230' SITE CLASS. P.S. DESIGN FLOW 360 L.T.A.R. .3 gpd/ft²

Septic Tank: 1000 Gallons; STB 1012 Date 5-2-95
Pump Tank: 1000 Gallons; PT 17 Date 5-16-95
Pump Make: Model Serial No.
Nitrification Field: No Fields 1 Square Feet 630 Linear Feet 210
No Lines 3 Trench Width 24" Max Trench Bottom Depth 30" Gravel Depth 24"

☑ New System ☐ Repair System Type: I, II, III, IV, V, VI
System Description: pump to PPBPS
Repair System Description: " "
Maintenance Agreement Required: ☑ Yes ☐ No
☐ Slab ☐ Crawl Space ☑ Basement w/plumbing ☐ Basement wo/plumbing


☑ House/Mod. Home No. Bedrooms 3
☐ Mobile Home No. Bathrooms 3
☐ Business No. Employees
☐ Other

Water Supply:
☐ Individual
☐ Community
☐ Public

Comments: This Permit voids permit issued on 3-1-94. Pump to PPBPS. Install Pump that will deliver 30 GPM at 35 TDH. See attached for pump diagram and panel diagram. Keep system on contour. Keep System 25' from foundation of home, 10' from all property lines, and 50' min. from any well. 100% Repair below

Comments: Checked septic Tank, pump tank, Upper two lines and trench bottom of 3ed or lower line. I will probe panels in 3ed line on next visit. Reason; because installation took place on a friday and we did not want trench left open over weekend

INITIAL SITE SKETCH

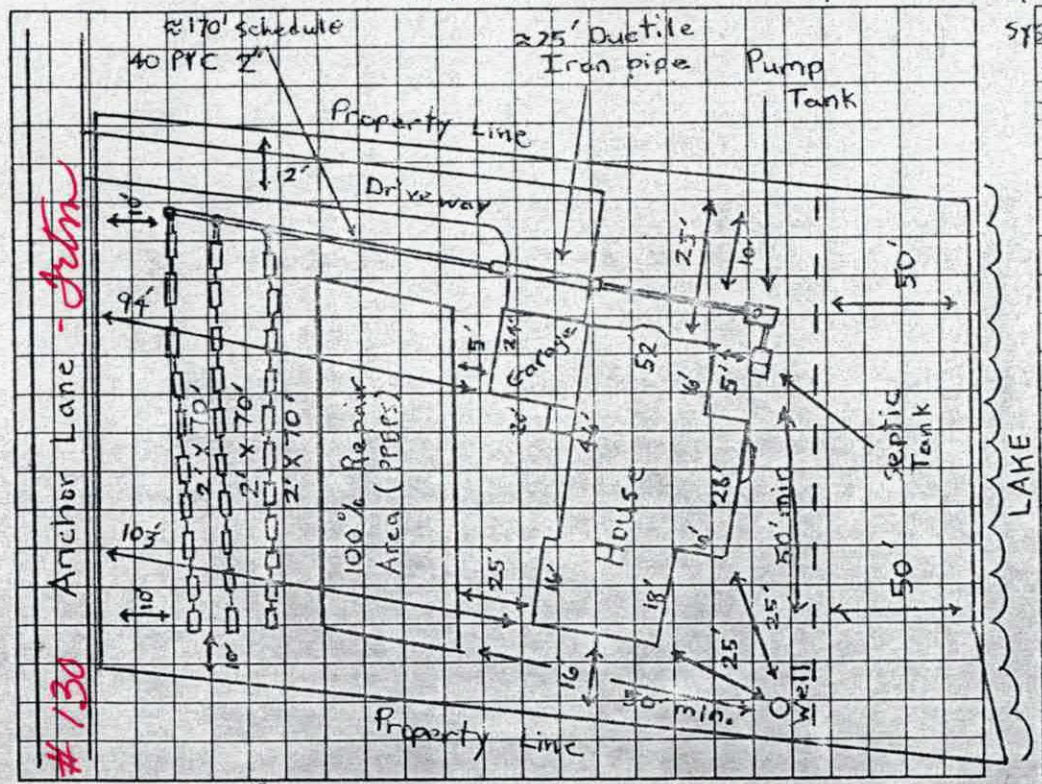

AS BUILT SKETCH Inspected on 8-9-95.

System, pump to PPBPS.
*Maintenance agreement required before O.P. can be issued *
~~Install wall mix variable distance form septic system.~~
48 panels, 1 (3/16" hole per panel)

Inspected pump, pressure head, NEMA 4X Box, Alarm, and floats on 8-25-95

Maintenance agreement received on 8-10-95

Well located at time of inspection, is 50'± to any part of septic system

SAME AS INITIAL SKETCH

I understand that this permit can be suspended or revoked if any false information is supplied toward securing the permit/any unauthorized changes are made to the site/any unauthorized changes are made in the installation of the system. Improvement Permit is valid for 60 months from date of issuance.

Signed: Richard A. Stankwytch

Improvement Permit by: Michael L. Dennis date 1-13-95

Existing System Inspection by: date

Installed by: Eddie Younts and Sons Backhoe

Certificate of Completion by: date

Operation Permit by: Michael L. Dennis date 8-25

HEALTH DEPT. COPY: WHITE INSPECTION COPY (FINAL): GREEN OWNER COPY (FINAL): YELLOW INSPECTION COPY (INITIAL): PINK OWNER COPY (INITIAL): GOLD