50753

IREDELL COUN[TY] HEALTH DEPARTMENT STATESVILLE 704-878-5305 MOORESVILLE 704-664-5281

IMPROVEMENT [PE]RMIT / CERTIFICATE OF COMPLETION / OPERATION PERMIT / EXISTING SYSTEM INSPECTION

PROPERTY DESCRIPTION NO: 7?B2 DATE 1-13-95 TAX MAP NO. 3F-13-A-17 4730-40-8651 Watershed: ☐ Yes ☑ No

OWNER OR CONTRACTOR Ri[ch]ard A. Stankwytch PHONE: Business 872-9566 Home (910) 766-3079

ADDRESS 5487 More[...]ights Lane Clemmons, N.C. 27012

LOCATION From Troutman take Perth Rd. TR State Park Rd. TL Honeycutt Rd. TR Brer Fox TL Capt. Way TL Anchor Lane Lot on R.

SUBDIVISION Capt. Cove. BLOCK / SECTION ____ LOT 17 LOT AREA 105' x 230' SITE CLASS. P.S. DESIGN FLOW 360 L.T.A.R. .3 gpd/ft²

Septic Tank: 1000 Gallons; STB 1012 Date 5-2-95
Pump Tank: 1000 Gallons; PT 17 Date 5-16-95
Pump Make: ____ Model ____ Serial No. ____
Nitrification Field: No Fields 1 Square Feet 630 Linear Feet 210
No Lines 3 Trench Width 24" Max Trench Bottom Depth 30" Gravel (sand) Depth 24"

☑ New System ☐ Repair System Type: I, II, III, (IV), V, VI
System Description: pump to PPBPS
Repair System Description: " "
Maintenance Agreement Required: ☑ Yes ☐ No
☐ Slab ☐ Crawl Space ☑ Basement w/plumbing ☐ Basement wo/plumbing


☑ House/Mod. Home ☐ Mobile Home ☐ Business ☐ Other ____
No. Bedrooms 3 No. Bathrooms 3 No. Employees ____

Water Supply: ☐ Individual ☐ Community ☐ Public

Comments: This Permit voids permit issued on 3-1-94. Pump to PPBPS. Install Pump that will deliver 30 GPM at 35 TDH. See attached for pump diagram and panel diagram. Keep system on contour. Keep System 25' from foundation of home, 10' from all property lines, and 50' min from any well. 100% Repair below

Comments: Checked septic Tank, pump tank, Upper two lines and trench bottom of 3rd or lower line. I will probe panels in 3rd line on next visit. Reason; because istallation took place on a friday and we did not want trench left open over weekend.

INITIAL SITE SKETCH

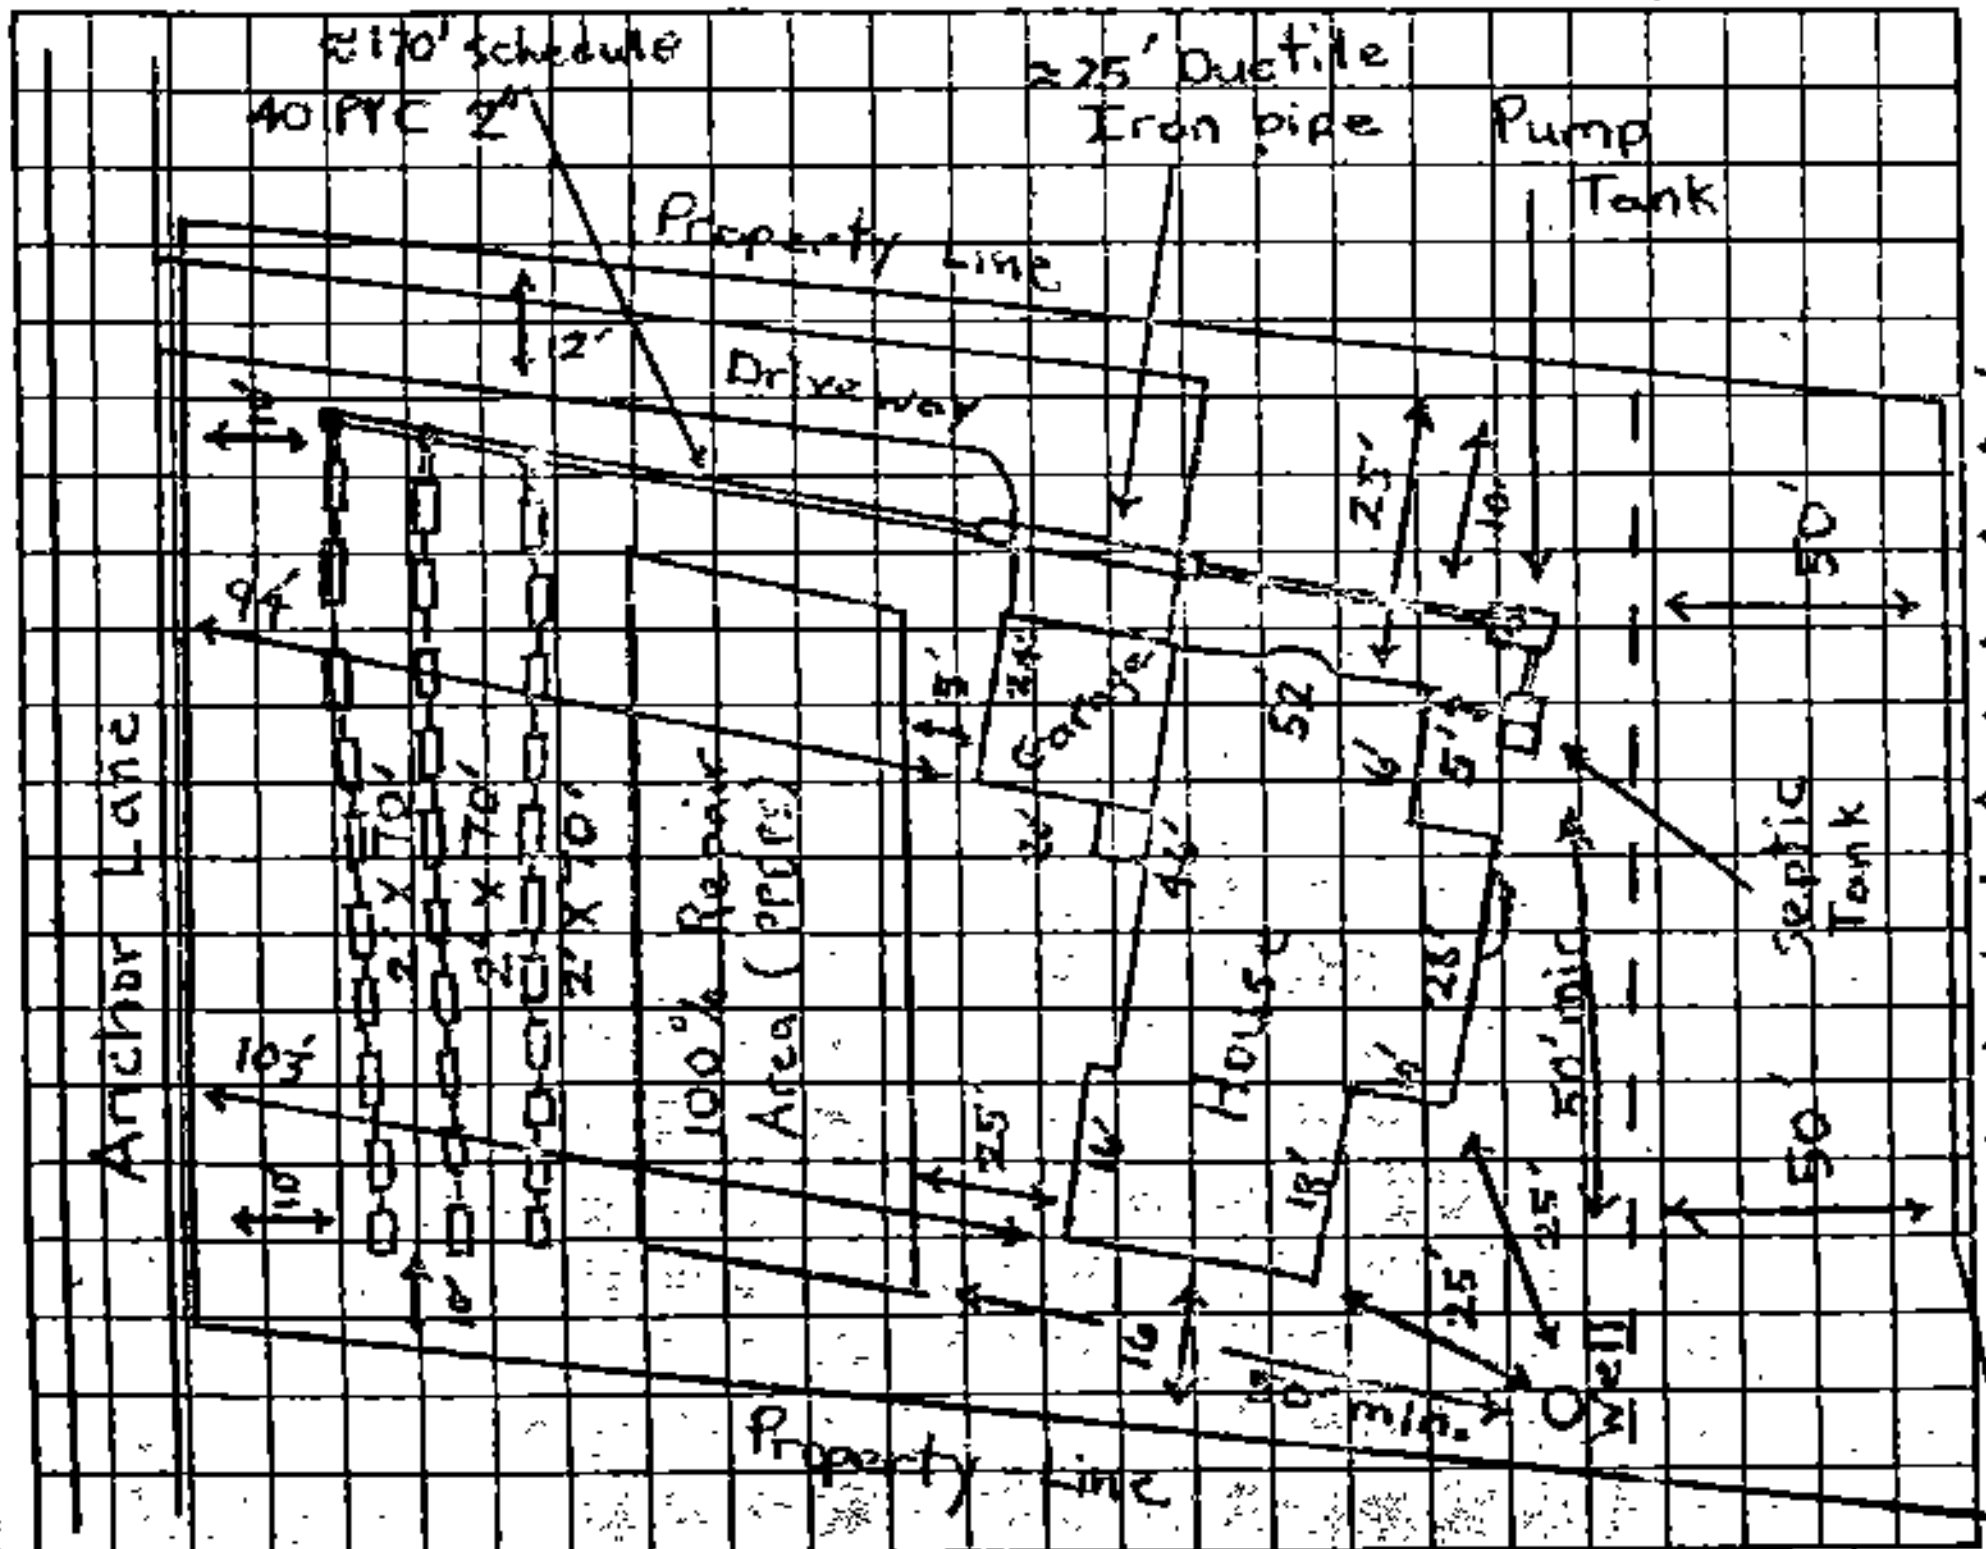

AS BUILT SKETCH Inspected on 8-4-95.

System, pump to PPBPS.

*Maintenance agreement required before O.P. can be issued *

Install well max verable distance form septic system.

48 panels 1 (3/16" hole per panel)

Inspected pump, pressure head, NEMA 4X Box, Alarm, and floats on 8-25-95

Maintenance agreement received on 8-10-95

Well located at time of inspection is 50' + to any part of septic system

SAME AS INITIAL SKETCH

I understand that this permit can be suspended or revoked if any false information is supplied toward securing the permit/any unauthorized changes are made to the site/any unauthorized changes are made in the installation of the system. Improvement Permit is valid for 60 months from date of issuance.

Signed: Richard A. Stankwytch

Installed by: Eddie Yountz and Sons Backhoe

Improvement Permit by: Michael J. Dennis date 1-13-95

Certificate of Completion by: ____ date ____

Existing System Inspection by: ____ date ____

Operation Permit by: Michael J. Dennis date 8-25-95

INSPECTION COPY (FINAL): GREEN OWNER COPY (FINAL): YELLOW INSPECTION COPY (INITIAL): PINK OWNER COPY (INITIAL): GOLD