IREDELL COUNTY HEALTH DEPARTMENT

11:30

STATESVILLE 704-878-5305 MOORESVILLE 704-664-5281

IMPROVEMENT PERMIT / AUTHORIZATION TO CONSTRUCT / OPERATION PERMIT / EXISTING SYSTEM INSPECTION

PERMIT# 83774 PIN# 4730408958 DATE 10-12-99

OWNER OR CONTRACTOR Joel Patterson PHONE. Business 662-0100 Home

ADDRESS 139 Anchor Ln Trautman N.C.

LOCATION Perth Rd TR State PK Rd TL Honeycutt TR Brer Fox TL Captians Way TL Anchor at end 6

SUBDIVISION Captians Cove BLOCK / SECTION LOT 1 LOT AREA .63 SITE CLASS PS DESIGN FLOW L.T.A.R. .35

Septic Tank: 1000 Gallons. STB 794 Date 7-30-99
Pump Tank: Gallons, PT Date
Pump Make: Model Serial No
Nitrification Field: No Fields 1 Square Feet 150 Linear Feet 50
No Lines 1 Trench Width 36" Max Trench Bottom Depth 36" Gravel Depth 12"


☑ New System ☐ Repair System Type: I (II) III. IV. V. VI
System Description: Conv. Gravity
Repair System Description: Gravity 25% Reduction
Maintenance Agreement Required: ☐ Yes ☑ No

☑ House/Mod Home No. Bedrooms 3
☐ Mobile Home No. Bathrooms 2½
☐ Business No. Employees
☐ Other
☐ Slab ☐ Crawl Space ☐ Basement w/plumbing ☐ Basement wo/plumbing

Water Supply: ☐ Individual ☐ Public ☐ Community


Comments /Conditions:
Adding Detached Garage which will be over Septic Tank & part of drain lines Will require moving Septic Tank & adding

INITIAL SITE SKETCH

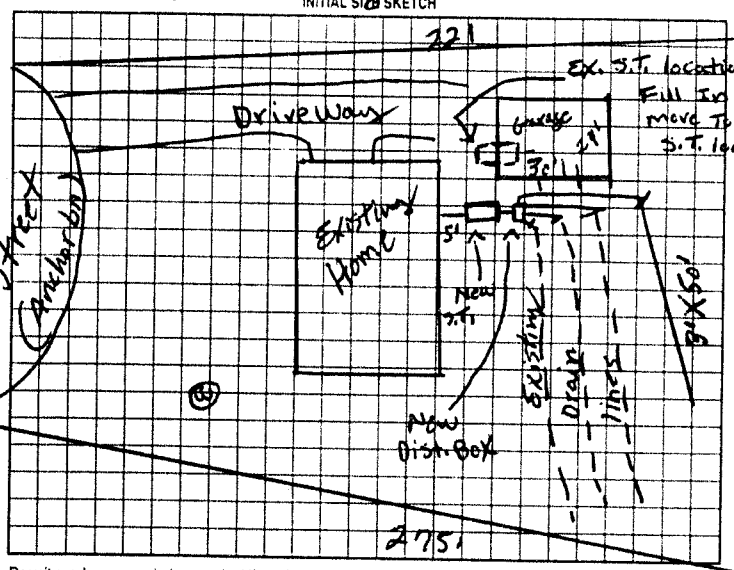

Comments /Conditions:
original system installed 9-6-95 under OZer AKRA Name appear 50' of Drain line

AS BUILT SKETCH

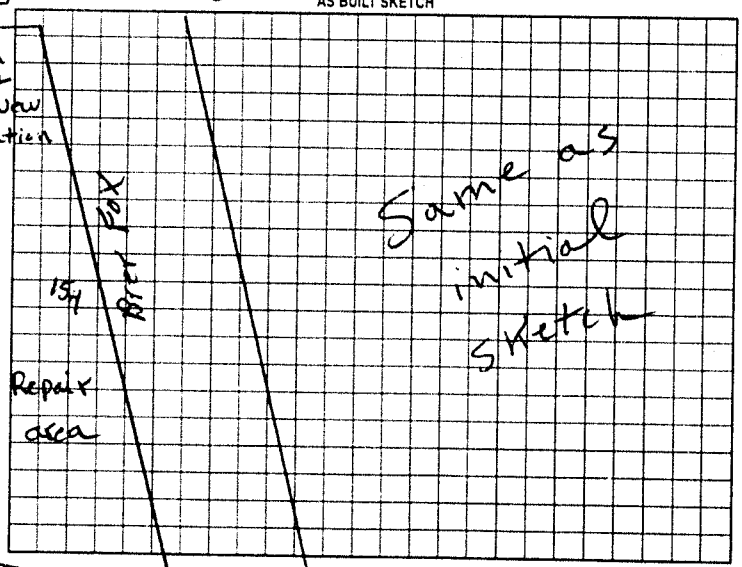

Permit can be suspended or revoked if any false information is supplied toward securing the permit/any unauthorized changes are made to the site/any unauthorized changes are made in the installation of the system. Improvement Permit with plat valid without expiration. Improvement Permit with site plan valid for sixty months. Authorization to Construct is valid for a period equal to that of Improvement Permit - not to exceed sixty months.

Signed: Lawrence Patterson date 10-18-99 Installed by: Wes Eytton

Improvement Permit by: P.C. Moore date 10-12-99 Operation Permit by: P. C. Moore date 11-4-99

Authorization to Construct by: P. C. Moore date 10-12-99 Existing System Inspection by: date

HEALTH DEPT. COPY WHITE OWNER COPY (FINAL) YELLOW OWNER COPY (INITIAL) PINK