2F-13-A-1 on Computer

55528

IREDELL COUNTY HEALTH DEPARTMENT

STATESVILLE 704-878-5305 MOORESVILLE 704-664-5281

IMPROVEMENT PERMIT / CERTIFICATE OF COMPLETION / OPERATION PERMIT / EXISTING SYSTEM INSPECTION

PROPERTY DESCRIPTION NO. 19900 DATE 12-29-94 TAX MAP NO. 3F-13-A-1 Watershed: ☑ Yes ☐ No

OWNER OR CONTRACTOR OZER AKRA PHONE: Business Home 704 892 5528 ☒-CA

ADDRESS 18595 Vineyard PTLN Huntersville N.C.

LOCATION Perth Rd TR State Park Rd Tb Honeycutt Rd TR Bare Fox/left capt cove

SUBDIVISION Captians Cove BLOCK / SECTION LOT I LOT AREA 1.67 SITE CLASS PS DESIGN FLOW 31 L.T.A.R. .35

Tb Fox & Ez

Septic Tank: 1000 Gallons; STB 794 Date 7-8-95

Pump Tank: — Gallons; PT — Date —

Pump Make: — Model — Serial No. —

Nitrification Field: No Fields 1 Square Feet 1035 Linear Feet 345

No Lines 3 Trench Width 36" Max Trench Bottom Depth 24" Gravel Depth 12"

☑ New System ☐ Repair System Type: I ☒ III, IV, V, VI

System Description: Conv. Gravity

Repair System Description: "

Maintenance Agreement Required: ☐ Yes ☑ No

☑ House/Mod. Home No. Bedrooms 3

☐ Mobile Home No. Bathrooms 2½

☐ Business No. Employees —

☐ Other —


☐ Slab ☑ Crawl Space ☐ Basement w/plumbing ☐ Basement wo/plumbing

Water Supply: ☑ Individual ☐ Community ☐ Public

Comments:

Comments: Well installed, it is 50'± from septic system. Well and drive installed on opposite sides than as shown on initial sketch, [redacted] Actual locations shown on intial sketch and labled.

INITIAL SITE SKETCH

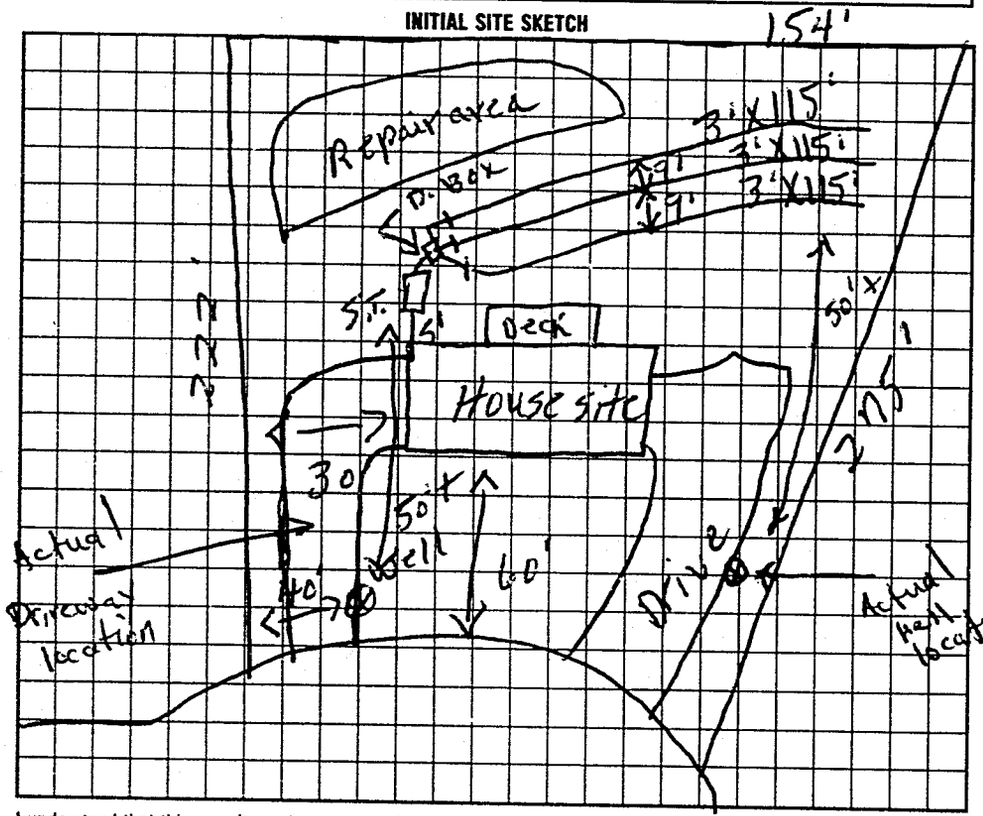

AS BUILT SKETCH

SAME AS INITIAL SKETCH

I understand that this permit can be suspended or revoked if any false information is supplied toward securing the permit/any unauthorized changes are made to the site/any unauthorized changes are made in the installation of the system. Improvement Permit is valid for 60 months from date of issuance.

Signed: X O. Ozer.

Improvement Permit by: L.C. Moore date —

Existing System Inspection by: — date —

Installed by: Wes Lytton

Certificate of Completion by: Michael J. Dennis/Brady Freeman date 9-6-95

Operation Permit by: — date —

HEALTH DEPT. COPY: WHITE INSPECTION COPY (FINAL): GREEN OWNER COPY (FINAL): YELLOW INSPECTION COPY (INITIAL): PINK OWNER COPY (INITIAL): GOLD

5 8 2 0 0