IREDELL COUNTY HEALTH DEPARTMENT

STATESVILLE 704-878-5305 MOORESVILLE 704-664-5281

See attached pool addition.

IMPROVEMENT PERMIT / AUTHORIZATION TO CONSTRUCT / OPERATION PERMIT / EXISTING SYSTEM INSPECTION

PERMIT# 125404 PIN# 4730-42-4478 DATE 1-18-05

OWNER OR CONTRACTOR DUPONT GROUP, INC Cell Phone PHONE: Business 704-975-8484 Home 704-660-0402

ADDRESS 862 BRAWLEY SCHOOL ROAD SUITE 201 MOORESVILLE, NC 28117 Site address: 257 Honeysuckle Rd - Trim.

LOCATION STATE RTE 120 © HONEYCUTT 2ND LOT ON LEFT PAST TREEMONT LOT # 13

SUBDIVISION TREEMONT BLOCK / SECTION ____ LOT 13 LOT AREA 1.7092 AC SITE CLASS PS DESIGN FLOW 480 L.T.A.R. .3

Septic Tank: 1000 Gallons; STB 1667 Date 9-11-05

Pump Tank: ____ Gallons; PT ____ Date ____

Pump Make: ____ Model ____ Serial No. ____

Nitrification Field: No Fields 1 Square Feet EQ=1600 Linear Feet 400'

No Lines 4 Trench Width 36" Max Trench Bottom Depth 24"

☒ New System ☐ Repair System Type: I, II, ⓘ IV, V, VI

System Description: GRAV 2560 RED

Repair System Description: LP 50% RED.

Maintenance Agreement Required: ☐ Yes ☐ No

Gravel Depth N/A

☒ House/Mod. Home ☐ Mobile Home ☐ Business ☐ Other

No. Bedrooms 4 No. Bathrooms 2½ No. Employees ____

☐ Slab ☒ Crawl Space ☐ Basement w/plumbing ☐ Basement wo/plumbing

Water Supply: ☒ Individual ☐ Public ☐ Community

Comments:/Conditions: ① SYSTEM FLAGGED OUT, SURVEYOR LOCATED FLAGGS AND HOUSE SITE ON PLAT ② INSTALL LINES ON LOW TOPO & MAINTAIN SETBACKS, ③ APPROVED 3 BEDROOM PLANS OWNER WANTS TO SIZE IT FOR A 4 BEDROOM. 276.46


Comments:/Conditions: ④ NOTE MAXIMUM TRENCH BOTTOM DEPTH 24"

BOWLO FILTER BROWN P/NEF 235 WELL IS 100' FROM TANKS BED

Kitchen Area

1"=60'

INITIAL SITE SKETCH

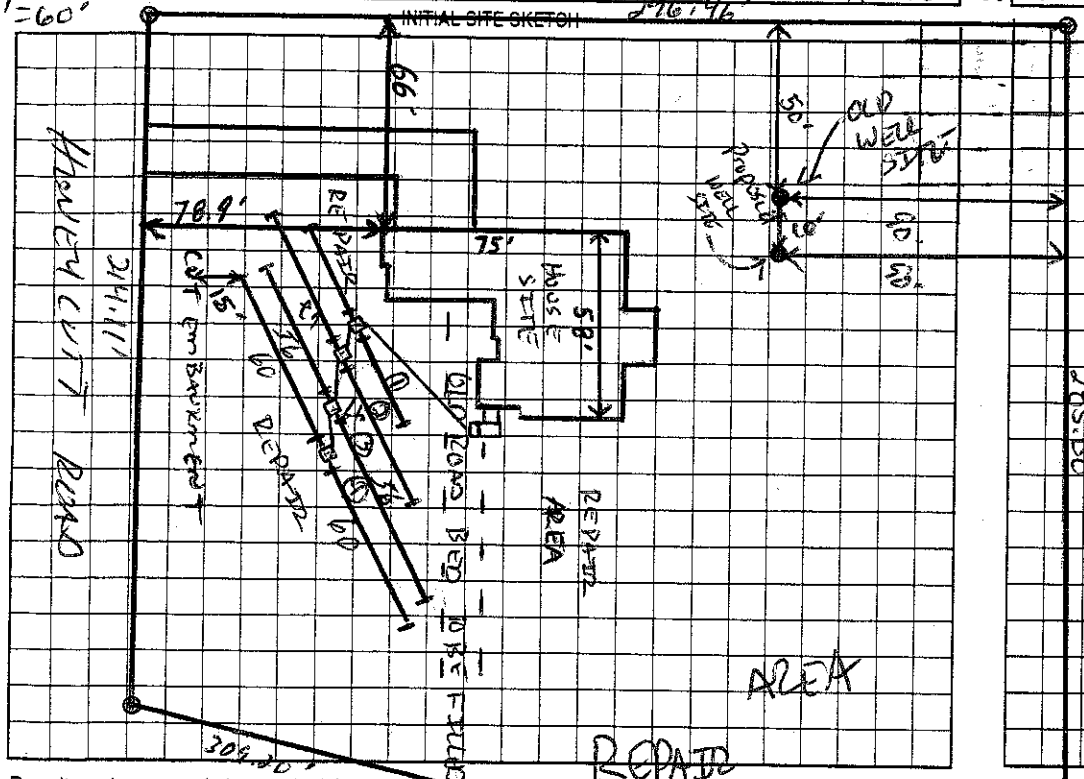

AS BUILT SKETCH

LINES ①	3' x 70'	SPLIT	70
②	3' x 100'	SPLIT	109
③	3' x 110'	SPLIT	112
④	3' x 100'	SPLIT	120

9-16-05 MET BLDR. OK'D MOVING WELL 10' AS DRAWN. LC.

John H Dupont Jr

V Filter For Approval

Permit can be suspended or revoked if any false information is supplied toward securing the permit/any unauthorized changes are made to the site/any unauthorized changes are made in the installation of the system. Improvement Permit with plat valid without expiration. Improvement Permit with site plan valid for sixty months. Authorization to Construct is valid for a period equal to that of Improvement Permit – not to exceed sixty months.

Signed: John H. Dupont Jr date 1/24/05 Installed by: Richard ASBURY

Improvement Permit by: [signature] date 1-18-05 Operation Permit by: [signature] date 3-28-06

Authorization to Construct by: [signature] date 1-18-05 Existing System Inspection by: ____ date ____

HEALTH DEPT. COPY: WHITE OWNER COPY (FINAL): YELLOW OWNER COPY (INITIAL): PINK