IREDELL COUNTY HEALTH DEPARTMENT

STATESVILLE 704-878-5305 MOORESVILLE 704-664-5281

IMPROVEMENT PERMIT / AUTHORIZATION TO CONSTRUCT / OPERATION PERMIT / EXISTING SYSTEM INSPECTION

PERMIT# 125404 PIN# 4730-42-4478 DATE 1-18-05

OWNER OR CONTRACTOR DUPONT GROUP, INC PHONE: Business 704-975-8484 (CELL PHONE) Home 704-660-0402

ADDRESS 862 BRAWLEY SCHOOL ROAD SUITE 201 MOORESVILLE, NC 28117

LOCATION STATE RTE 120 (E) HEATHCOTT 2ND LOT ON LEFT PAST TREEMONT LOT # 13

SUBDIVISION TREMONT BLOCK / SECTION ____ LOT 13 LOT AREA 1.7092 AC SITE CLASS. PS DESIGN FLOW 480 L.T.A.R. .3

Septic Tank: 1000 Gallons; ST# 1667 Date 7-11-05

Pump Tank: ____ Gallons; PT ____ Date ____

Pump Make: ____ Model ____ Serial No. ____

Nitrification Field: No Fields 1 Square Feet EDA=1600 Linear Feet 400'

No Lines 4 Trench Width 36" Max Trench Bottom Depth 24" Gravel Depth N/A

☒ New System ☐ Repair System Type: I, II, (III) IV, V, VI

System Description: 6 GAL 25% RED

Repair System Description: LP 50% RED.

Maintenance Agreement Required: ☐ Yes ☐ No

☒ House/Mod. Home ☐ Mobile Home ☐ Business ☐ Other

No. Bedrooms 4 No. Bathrooms 2½ No. Employees ____

Water Supply: ☒ Individual ☐ Public ☐ Community


☐ Slab ☒ Crawl Space ☐ Basement w/plumbing ☐ Basement wo/plumbing

Comments/Conditions: (1) SYSTEM FLAGGED OUT, SURVEYOR LOCATED FLAGGS AND HOUSE SITE ON PLAT (2) INSTALL LINES ON LOW TOPO & MAINTAIN SETBACKS, (3) APPROVED 3 BEDROOM PLAN & OWNER WANTS TO SIZE IT FOR A 4 BEDROOM.

Comments/Conditions: (4) NOTE MAXIMUM TRENCH BOTTOM DEPTH 24" BOWLD FILTER BROWN PINE 235 WELL IS 100' from DRILLED WELL

1"=60'

INITIAL SITE SKETCH

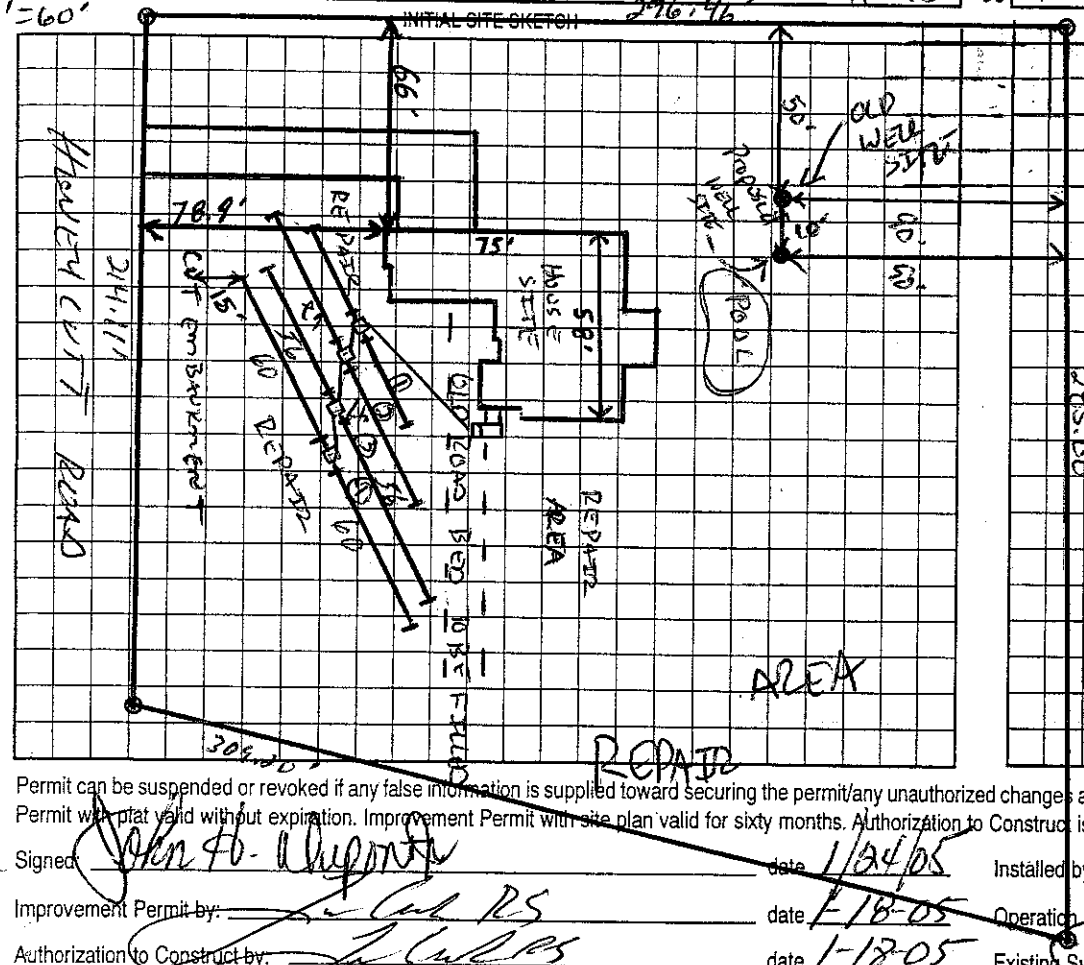

AS BUILT SKETCH

LINES				
(1)	3'	x 70'	SPLIT	70
(2)	3'	x 100'	SPLIT	109
(3)	3'	x 110'	SPLIT	112
(4)	3'	x 100'	SPLIT	120

9-16-05 MET BLDR. OK'D MOVING WELL 10' AS DRAWN. LC.

X John H. Dupont Jr

√ Filter For Approval

The proposed POOL addition does not appear to impact the existing septic system.

**NOTE: ____

STEVE HENDRICK R.S.

Date: MARCH 23, 2016

ICHD-Environmental Health Division

Permit can be suspended or revoked if any false information is supplied toward securing the permit/any unauthorized changes are made to the site/any unauthorized changes are made in the installation of the system. Improvement Permit with plat valid without expiration. Improvement Permit with site plan valid for sixty months. Authorization to Construct is valid for a period equal to that of Improvement Permit – not to exceed sixty months.

Signed: John H. Dupont date 1/24/05 Installed by: Richard ABERNATHY

Improvement Permit by: [signature] date 1-18-05 Operation Permit by: [signature] date 3-28-06

Authorization to Construct by: [signature] date 1-18-05 Existing System Inspection by: ____ date ____

HEALTH DEPT. COPY: WHITE OWNER COPY (FINAL): YELLOW OWNER COPY (INITIAL): PINK