IREDELL COUNTY HEALTH DEPARTMENT

STATESVILLE 704-878-5305 MOORESVILLE 704-664-5281

IMPROVEMENT PERMIT / CERTIFICATE OF COMPLETION / OPERATION PERMIT / EXISTING SYSTEM INSPECTION

PROPERTY DESCRIPTION NO. 24066 D6916035 DATE 7-2-96 TAX MAP NO. 3E-7-A-14 Watershed: ☑ Yes ☐ No

OWNER OR CONTRACTOR Reginald Hooker PHONE: Business 663 3012 Home

ADDRESS 225 Jonnthan Ln Statesville

LOCATION State Park Rd Turn Honeycutt Rd 1st lot on left Past Tremount

SUBDIVISION Tre Mount BLOCK / SECTION LOT 14 LOT AREA 1.53 SITE CLASS. PS DESIGN FLOW 360 L.T.A.R. .3 ~~.4~~ 1/5 1/8 Key

Septic Tank: 1000 Gallons; STB 1012 Date 7-23-98

Pump Tank: Gallons; PT Date

Pump Make: Model Serial No.

Nitrification Field: No Fields 1 Square Feet 1200 Linear Feet 400

No Lines 3 Trench Width 36" Max Trench Bottom Depth 36" Gravel Depth 12"

☑ New System ☐ Repair System Type: I ☑ II. III. IV. V. VI

System Description: Conv. Gravity

Repair System Description: " "

Maintenance Agreement Required: ☐ Yes ☑ No

☐ House/Mod. Home No. Bedrooms 3

☐ Mobile Home No. Bathrooms 2

☐ Business No. Employees

☐ Other

☐ Slab ☑ Crawl Space ☐ Basement w/plumbing ☐ Basement wo/plumbing


Water Supply: ☑ Individual ☐ Community ☐ Public

Comments:


Comments:

* Note Tank & piping changed to opposite side of House

INITIAL SITE SKETCH

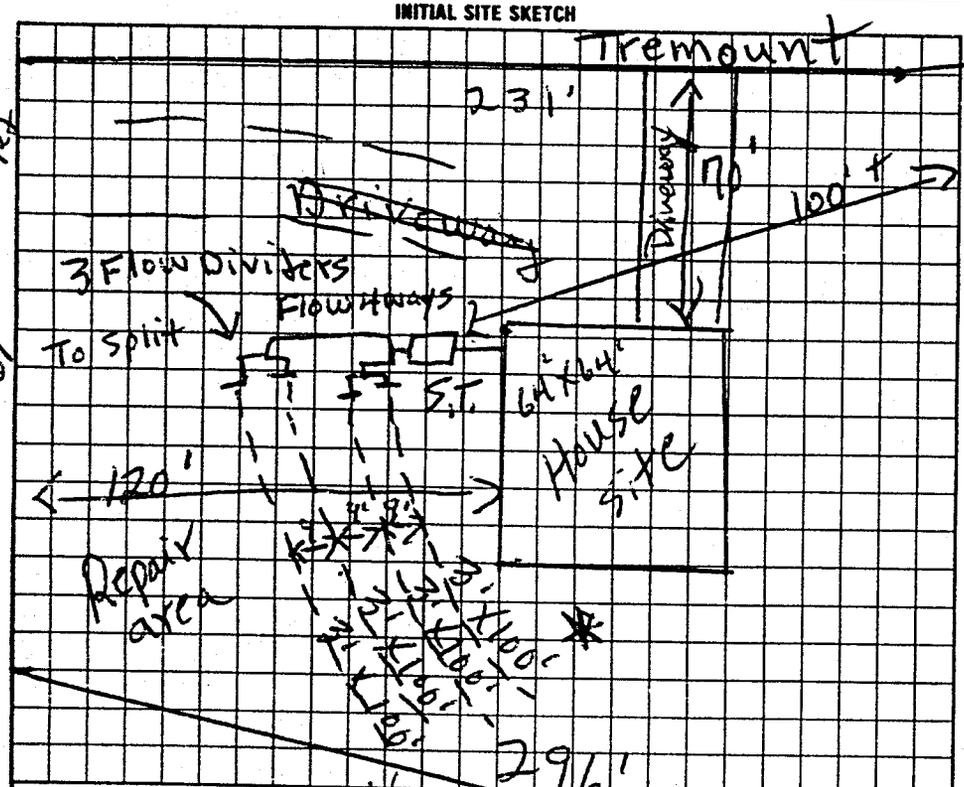

AS BUILT SKETCH

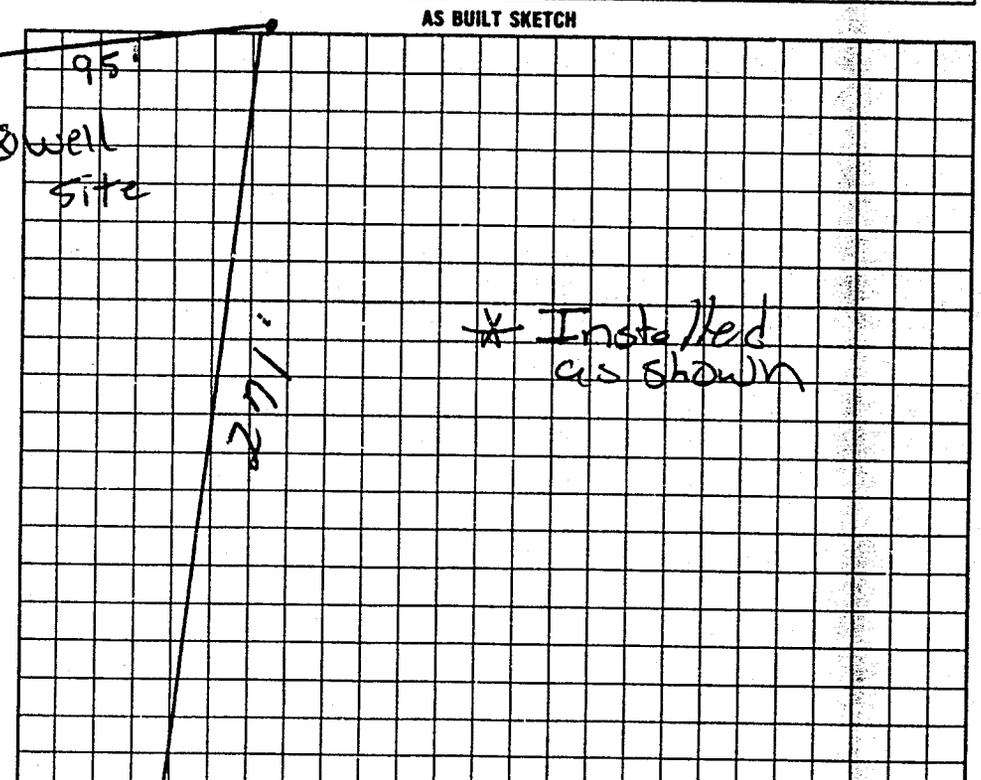

I understand that this permit can be suspended or revoked if any false information is supplied toward securing the permit/any unauthorized changes are made to the site/any unauthorized changes are made in the installation of the system.

Signed: x Jackie Hamon

Improvement Permit by: R. C. Moore date 7-2-96

Existing System Inspection by R. C. Moore date 7-2-96

Installed by: Tommy Frye

Certificate of Completion by: date

Operation Permit by Mark Cox RS date 4-21-98

HEALTH DEPT. COPY: WHITE INSPECTION COPY (FINAL): GREEN OWNER COPY (FINAL): YELLOW INSPECTION COPY (INITIAL): PINK OWNER COPY (INITIAL): GOLD

to court

Authorization to court Expires 60 mos from issue