IREDELL COUNTY HEALTH DEPARTMENT

STATESVILLE 704-878-5305 MOORESVILLE 704-664-5281

IMPROVEMENT PERMIT / AUTHORIZATION TO CONSTRUCT / OPERATION PERMIT / EXISTING SYSTEM INSPECTION

DATE 1-25-99

PERMIT# 78943 PIN# 4730427532

OWNER OR CONTRACTOR Victor Radisi PHONE: Business 704 799 2410 Home

ADDRESS 16211 Clay Rd Houston Texas

LOCATION State Pk Rd & TL Honeycutt TL Tremount 2nt lot Rt.

SUBDIVISION Tremont BLOCK / SECTION LOT 12 LOT AREA 2.2 acres SITE CLASS PS DESIGN FLOW 360 L.T.A.R. .33

Septic Tank: 1000 Gallons; STB 1994 Date 3-12-99
Pump Tank: 1000 Gallons, PT 27 Date 4-5-99
Pump Make: Crowles Model 3885 Serial No WE05114
Nitrification Field: No Fields 1 Square Feet 1080 Linear Feet 360
No Lines 4 Trench Width 36" Max Trench Bottom Depth 36" Gravel Depth 12"

☑ New System ☐ Repair System Type: I, II, III, IV, V, VI
System Description: Pump To Conv.
Repair System Description: " " "
Maintenance Agreement Required: ☐ Yes ☑ No

☑ House/Mod. Home No. Bedrooms 3
☐ Mobile Home No. Bathrooms 3
☐ Business No. Employees
☐ Other
☐ Slab ☐ Crawl Space ☐ Basement w/plumbing ☐ Basement wo/plumbing


Water Supply: ☐ Individual ☐ Public ☐ Community

Comments/Conditions: See Attached Sheets for P.T. & Pressure manifold requirements. 595'


Comments/Conditions: Inspected S.T. P.T. Pump Drain lines Pressure manifold & Air Drawn down Test 6-2-99

- Wiring Inspected 1-3-2000
- Connected Cut off Valve 1-4-2000

INITIAL SITE SKETCH

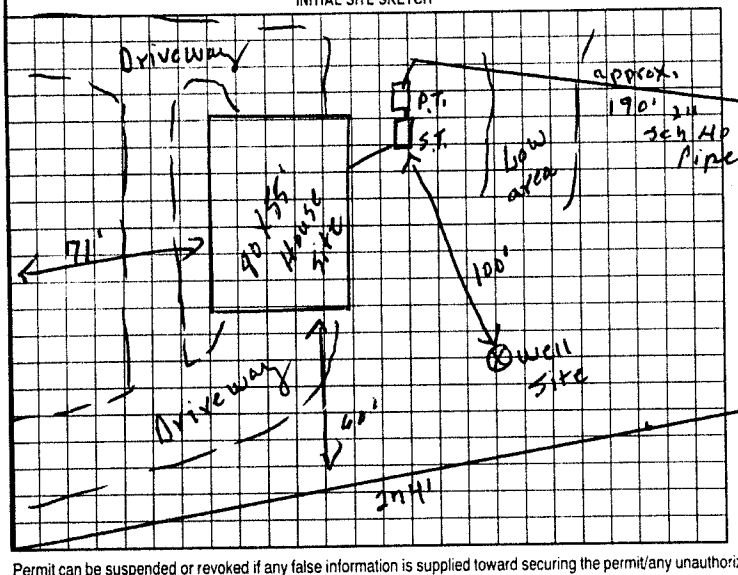

AS-BUILT SKETCH

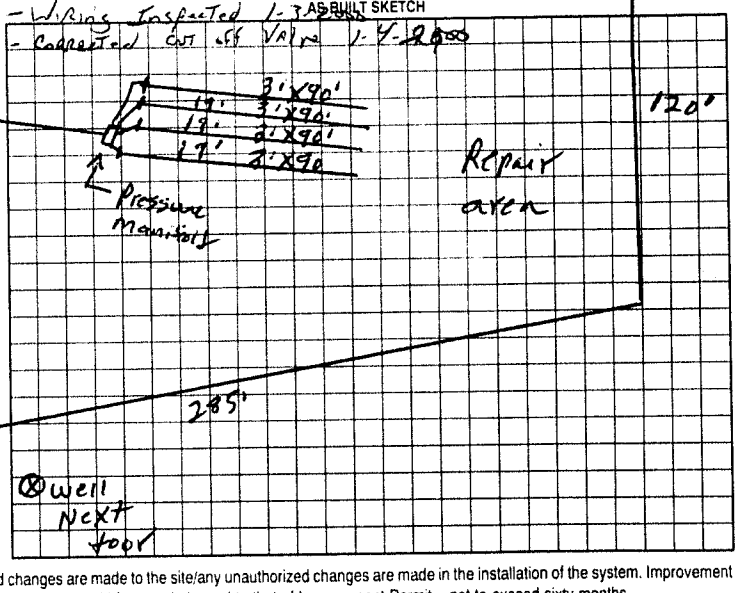

Permit can be suspended or revoked if any false information is supplied toward securing the permit/any unauthorized changes are made to the site/any unauthorized changes are made in the installation of the system. Improvement Permit with plat valid without expiration. Improvement Permit with site plan valid for sixty months. Authorization to Construct is valid for a period equal to that of Improvement Permit – not to exceed sixty months.

Signed: [signature] date 1-5-99 Installed by: A. Cornelius S.T. + Grading

Improvement Permit by: P.C. Moore date 1-25-99 Operation Permit by: JC Potter date Jan 4, 2000

Authorization to Construct by: P.C. Moore date 1-25-99 Existing System Inspection by: date

HEALTH DEPT COPY WHITE OWNER COPY (FINAL) YELLOW OWNER COPY (INITIAL) PINK