IREDELL COUNTY HEALTH DEPARTMENT

STATESVILLE 704-878-5305 MOORESVILLE 704-664-5281

IMPROVEMENT PERMIT / AUTHORIZATION TO CONSTRUCT / OPERATION PERMIT / EXISTING SYSTEM INSPECTION

PERMIT # 155529 PIN # 4730431083 DATE 4-1-09

OWNER or APPLICANT (Graceful LIVING INC) Christopher + Tina Lynch PHONE: Business 704-634-4776 Home:

OWNER or APPLICANT ADDRESS 3937 Granite St. Terrell NC 28682

LOCATION / DIRECTIONS State Park Rd @ Honeycutt on Rt past Hollybranch LANE BOX # 232

SUBDIVISION Tremont BLOCK / SECTION LOT # 22C LOT AREA 1.5 DESIGN FLOW 360 L.T.A.R. .3

Septic Tank 1000 Gallons: STB 1000 Date 5-15-09

Pump Tank Gallons: P T Date

Pump Make Model Serial #

Nitrification Field No Fields 1 No Lines 4 Linear Feet 200'

Trench Width 24" Max. Trench Bottom Depth 36" Gravel Depth N/A

☒ New System ☐ Repair ☐ Expansion System Type I II (III) IV V VI

System Description: GRAVITY 50 % REDUCT

Repair System Description: LP 50 % REDUCT

Maintenance Agreement Required ☐ YES ☒ NO

☒ GRAVITY ☐ PRESSURE

☒ Residence No. Bedrooms 3 ☐ Business No. Persons ☐ Other No. Employees ☐ Slab ☐ Crawl Space ☐ Basement w/plumbing ☐ Basement w/o plumbing

Water Supply: ☒ Private ☐ Public ☐ Community

Comments / Conditions (1) OLD SYSTEM FOR BURNED House HAS TO BE ABANDONED. (2) SEE ALL COMMENTS ON Permit * (3) Install Lines on Contours & maintain set backs. (4) ABANDON OLD System. (5) Keep proper fill from stubout to first

INITIAL SITE SKETCH

SEE ATTACHED SYSTEM DESIGN BY LORNE COOK, R.S.

Comments / Conditions Line, Builder is aware.

BOWLD Filter & MANIFOLD & RISERS

TANK IS 15' OFF POOL

SPEED LEVELERS SET GRADE / TANK & D/L 75' From P/L

AS BUILT SKETCH

✓ D LINE 1 & 2 & TANK 7-16-09 LC

✓ D LINE 3 & 4 LC 7-20-09

✓ D D/L Drop Lines 7-21-09

Michaels Well is 100' From TANK

✓ D ABANDONED TANK 7-22-09

Permit can be suspended or revoked if any false information is supplied toward securing the permit / any unauthorized changes are made to the site / any unauthorized changes are made in the installation of the system.

☐ IMPROVEMENT PERMIT w / plat valid without expiration. ☐ IMPROVEMENT PERMIT w / site plan valid for 60 mos. ☒ AUTHORIZATION TO CONSTRUCT valid for period equal to IMPROVEMENT PERMIT-not to exceed 60 mo.

Owner / Applicant Signature: Date 4-1-09

Improvement Permit by: Date 4-1-09

Authorization to Construct by: Date 4-1-09

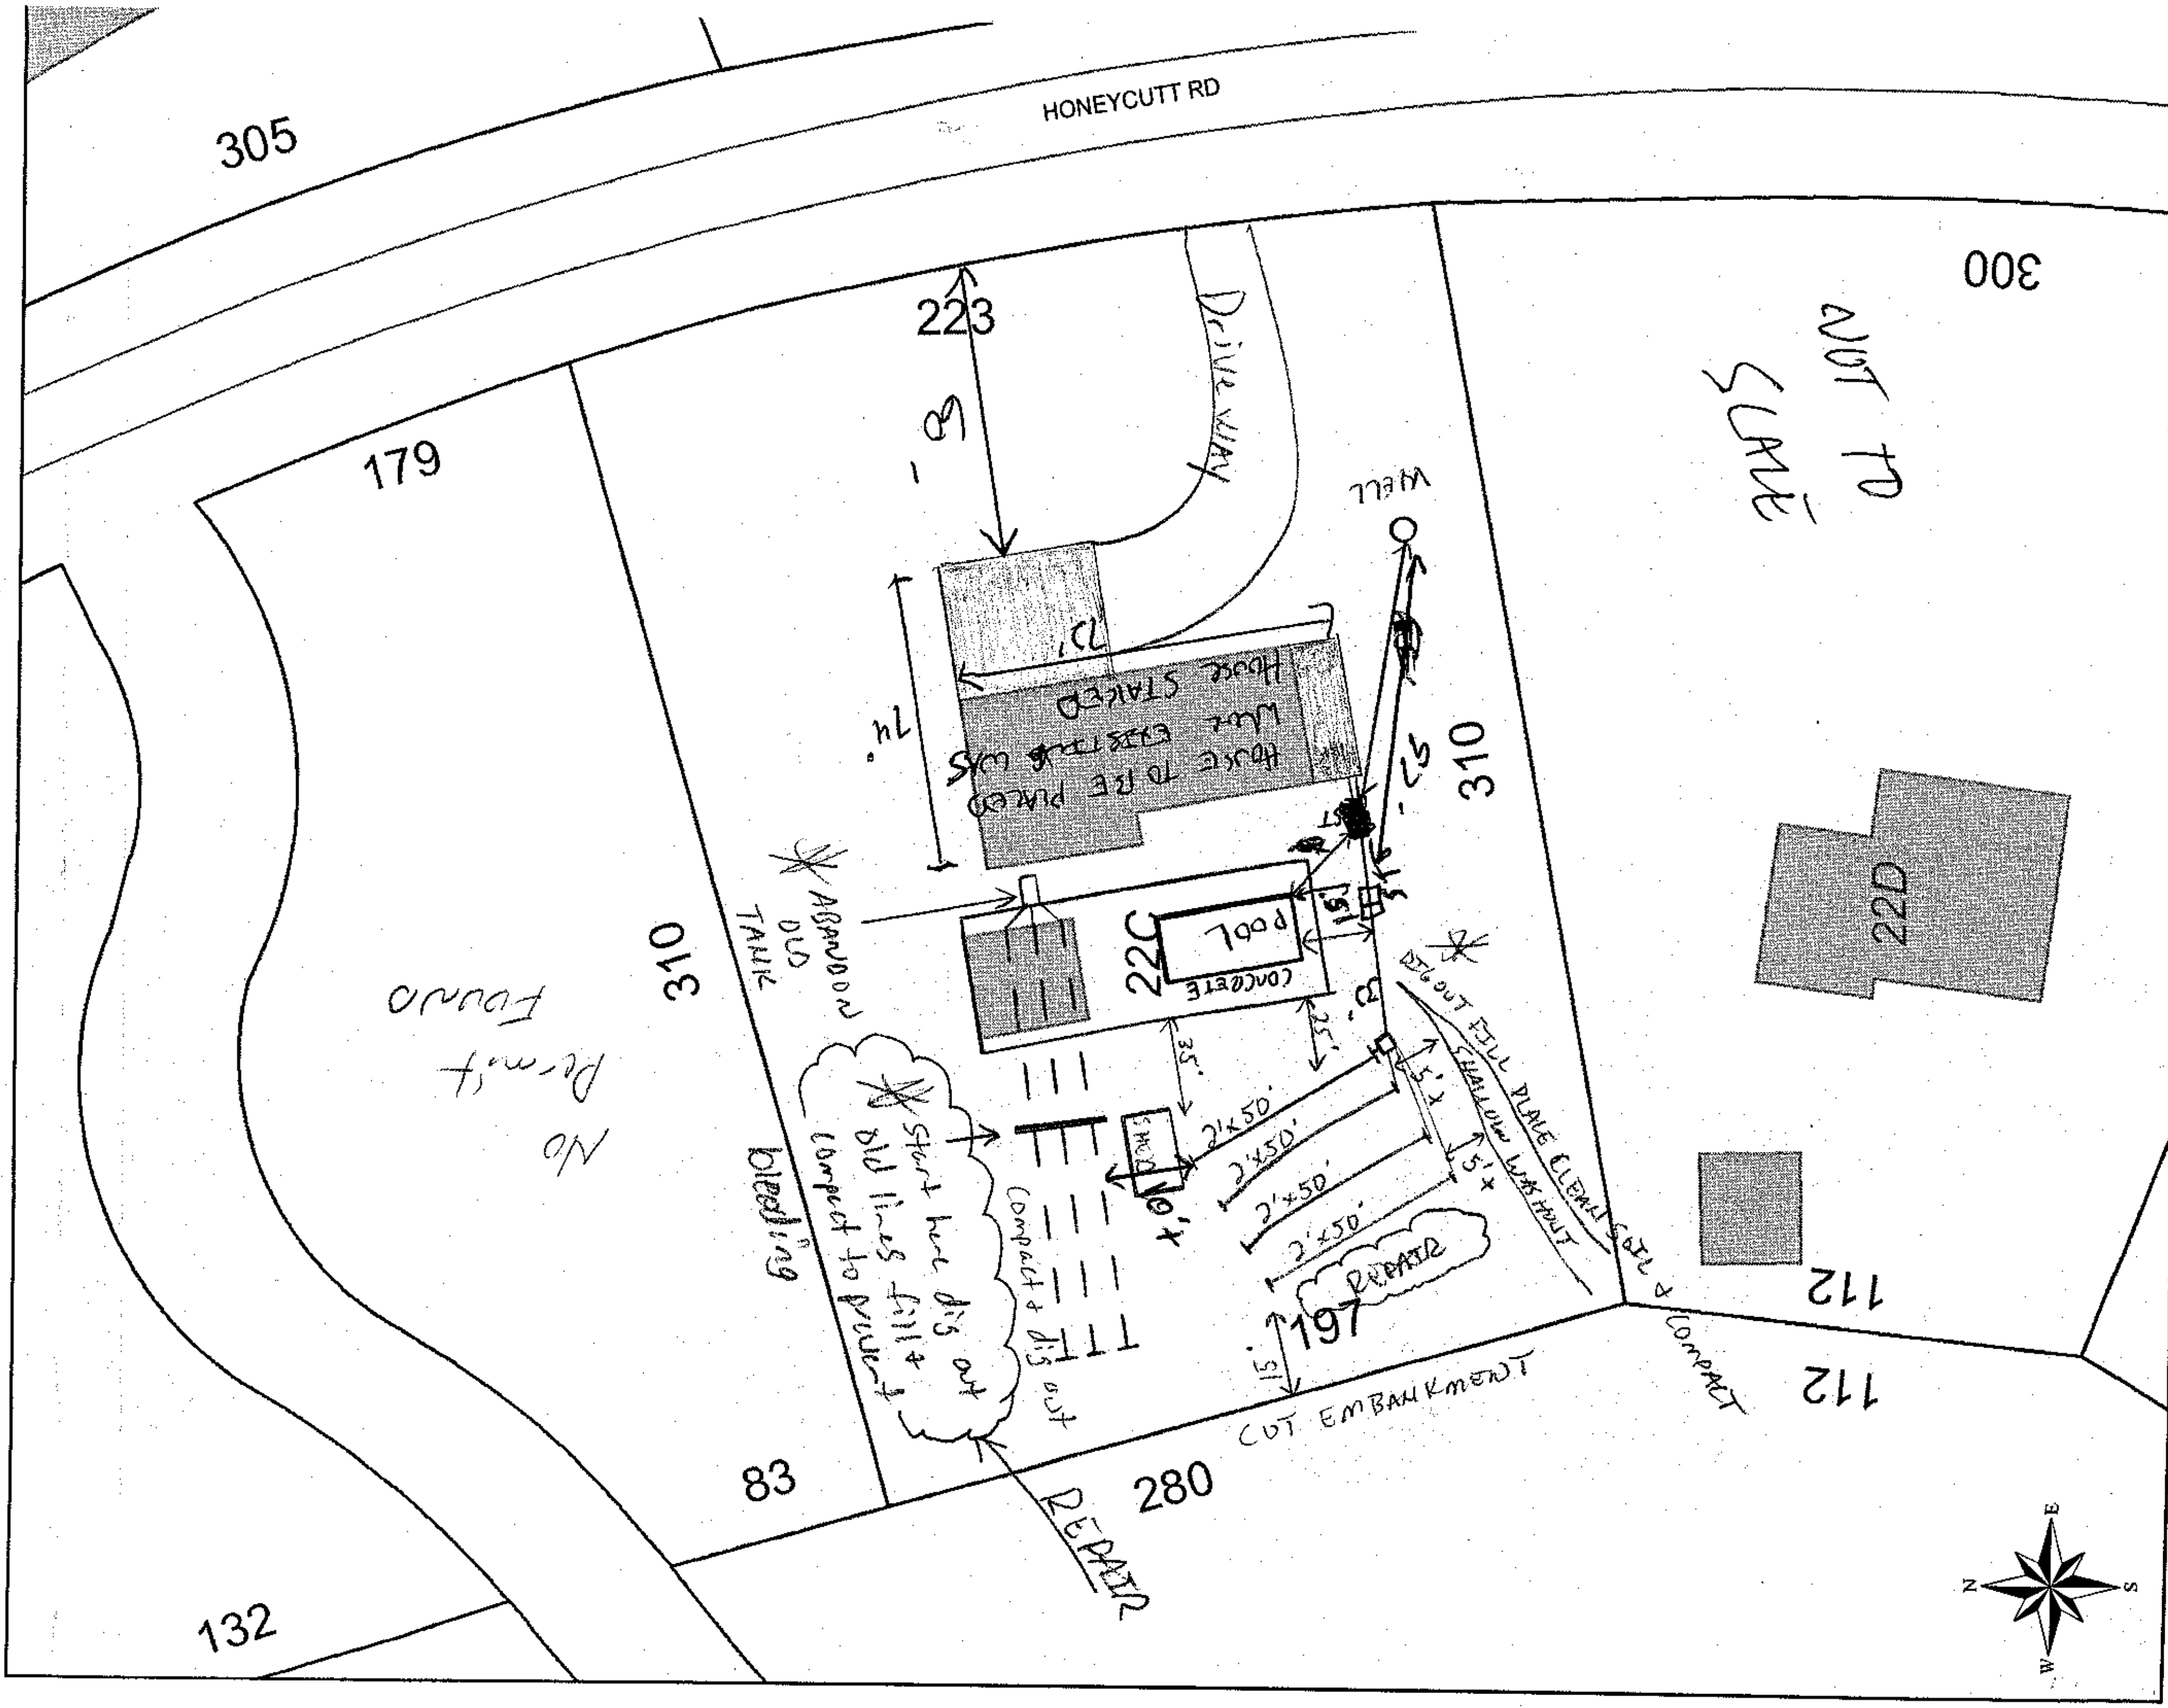
YOU SHOULD CONTACT A LOCATOR SERVICE PRIOR TO ANY EXCAVATION.

Installed by: WES LYTTON CONST

Operation Permit by: Date: 7-22-09

Existing System Inspected by: Date:

WHITE COPY Environmental Health YELLOW COPY (Final) Owner / Applicant PINK COPY (Initial) Owner / Applicant


HONEYCUTT RD
305
300
223
179
310
310
22C
22D
112
112
197
83
280
132
NOT TO SCALE
WELL
Drive way
60'
74'
72'
57'
HOUSE TO BE PLACED WHERE EXISTING WAS HOUSE STAKED
CONCRETE
POOL
15'
25'
35'
8'
ABANDON OLD TANK
No Permit FOUND
bleeding
Start here dig out old lines fill + compact to prevent
Compact + dig out
SHED
10'
2'x50'
2'x50'
2'x50'
2'x50'
2'x50'
5'
5'
5'
REPAIR
REPAIR
CUT EMBANKMENT
Dig out fill place clean soil + compact
shallow washout
N
S
E
W