IREDELL COUNTY HEALTH DEPARTMENT

STATESVILLE 704-878-5305 — MOORESVILLE 704-664-5281

IMPROVEMENT PERMIT / AUTHORIZATION TO CONSTRUCT / OPERATION PERMIT / EXISTING SYSTEM INSPECTION

PERMIT# 111721 PIN# 4730-43-7073 DATE 04-15-03

OWNER OR CONTRACTOR William & DONNA Pfeufer PHONE: Business _____ Home 704-528-0881

ADDRESS 170 BUTTERNUT RD TROUTMAN, NC 28166

LOCATION 21 SOUTH, (R) PERTH, (R) STATE PARK, (L) HONEYCUTT (L) TREEMONT, 2ND LOT ON LEFT

SUBDIVISION TREMONT BLOCK / SECTION _____ LOT 17 LOT AREA 2.47 AC SITE CLASS. _____ DESIGN FLOW _____ L.T.A.R. _____

Septic Tank: 1000 Gallons; STB 1007 Date 12-5-03
Pump Tank: _____ Gallons; PT _____ Date _____
Pump Make: _____ Model _____ Serial No. _____
Nitrification Field: No Fields 1 Square Feet 1200' Linear Feet 400'
No Lines 3x133' Trench Width 36" Max Trench Bottom Depth 36" Gravel Depth 12"

[X] New System [ ] Repair System Type: I, (II) III, IV, V, VI
System Description: GRAV CONV
Repair System Description: PUMP/GRAV 25% RED
Maintenance Agreement Required: [ ] Yes [X] No


[X] House/Mod. Home No. Bedrooms 3
[ ] Mobile Home No. Bathrooms 2½
[ ] Business No. Employees ____
[ ] Other _____
[ ] Slab [ ] Crawl Space [X] Basement w/plumbing [ ] Basement wo/plumbing

Water Supply: [X] Individual [X] Public [ ] Community WELL


Comments/Conditions: (1) BASEMENT PLUMBING STUBOUT MUST BE MAINTAINED AT NATURAL GRADE. DO NOT CUT AT THAT POINT OR PERMIT WILL BE VOID. (2) MAINTAIN SETBACKS (3) INSTALL LINES ON CONTOURS. (4) MAINTAIN BASEMENT

Comments/Conditions: FOUNDATION DRAIN SETBACKS AROUND SYSTEM & TANK. (5) HOME OWNER HAS P/L MARKED BY YELLOW RIBBON (6) KEEP WELL 100' FROM ANY PART OF SYSTEM. (7) HOUSE PLANS ATTACHED BUT NOT APPROVED. IP ONLY

"NOT TO SCALE" INITIAL SITE SKETCH

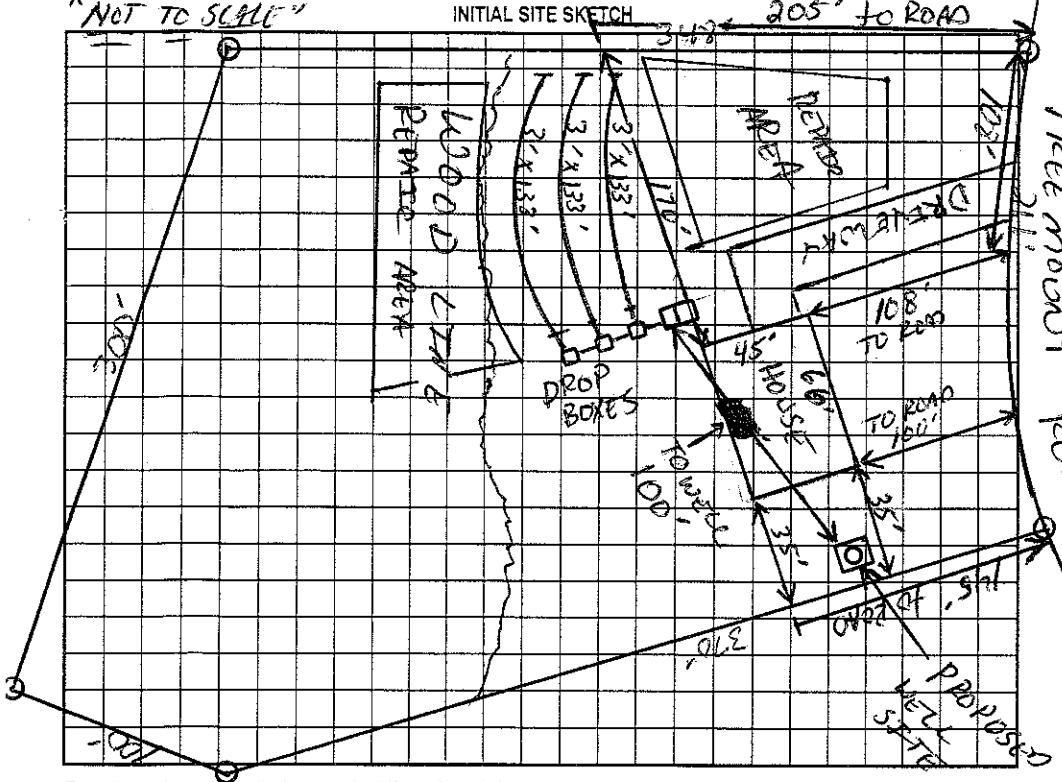

AS BUILT SKETCH ON 4-15-03.

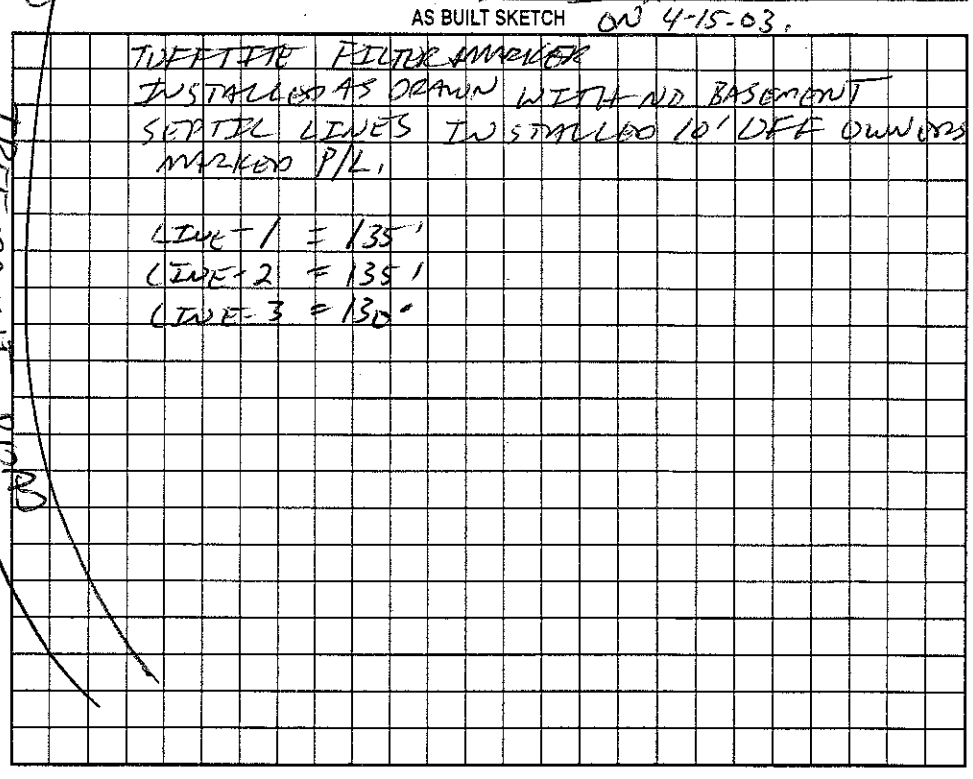

Permit can be suspended or revoked if any false information is supplied toward securing the permit/any unauthorized changes are made to the site/any unauthorized changes are made in the installation of the system. Improvement Permit with plat valid without expiration. Improvement Permit with site plan valid for sixty months. Authorization to Construct is valid for a period equal to that of Improvement Permit – not to exceed sixty months.

Signed: Donna D Pfeufer date 4-2-03 Installed by: WELBORN'S GRADING & EXCAVATING

Improvement Permit by: RS date 4-15-03 Operation Permit by: RS date 3-10-04

Authorization to Construct by: RS date 8-22-03 Existing System Inspection by: _____ date _____

HEALTH DEPT. COPY: WHITE OWNER COPY (FINAL): YELLOW OWNER COPY (INITIAL): PINK