CI

IREDELL COUNTY HEALTH DEPARTMENT

STATESVILLE 704-878-5305 MOORESVILLE 704-664-5281

IMPROVEMENT PERMIT / AUTHORIZATION TO CONSTRUCT / OPERATION PERMIT / EXISTING SYSTEM INSPECTION

PERMIT# 148659 PIN# 4730-44-8798 DATE 2-26-08

OWNER OR APPLICANT NEW AMERICAN BUILDERS, INC PHONE: Business % 704-662-8625 Home

ADDRESS c/o S & ME. INC. ENGINEERING, 1058 DENVER BUSINESS PARK, MOORESVILLE NC 28115

LOCATION STATE PARK ROAD TO TWIN CREEKS DR, TL WINDING CREEK DR, TR BLUE STREAM WAY, LOT AT END

SUBDIVISION TWIN CREEKS BLOCK / SECTION II LOT 42 LOT AREA 2.81 ACRES SITE CLASS. PS DESIGN FLOW 480 L.T.A.R. 0.25 GPD/FT²

Septic Tank: 1000 Gallons: STB 704 Date 3-23-08

Pump Tank: 1000 Gallons: PT 285 Date 5-18-08

Pump Make: Zoeller Model EQ TO N165 Serial No. ~

Nitrification Field: No Fields 1 Square Feet 1920 Linear Feet 480

No Lines FOUR Trench Width 36" Max Trench Bottom Depth 30"

☑ New System ☐ Repair ☐ Expansion System Type: I II III IV V VI

System Description: 25% REDUCTION, PRES. MANIFOLD

Repair System Description: 25% REDUCTION, PUMP

Maintenance Agreement Required: ☐ Yes ☑ No

☑ House/Mod. Home ☐ Mobile Home ☐ Business ☐ Other

No. Bedrooms 4 No. Persons ___ No. Employees ___

Water Supply: ☐ Individual ☑ Public ☐ Community

Gravel Depth N/A ☐ Gravity ☑ Pressure ☐ Slab ☑ Crawl Space ☐ Basement w/plumbing ☐ Basement wo/plumbing

Comments:/Conditions: SCOUR TRENCH SIDEWALLS & APPLY A LIGHT DUSTING OF LIME PRIOR TO INSTALLING CHAMBERS WHERE SMEARING OCCURS.

Comments:/Conditions: 2" Supply Sleeved Under Creek, 36" + Cover under Creek Crossing HOUSE SITS WAY DOWN HILL, TANKS ARE 50' ± TO CREEK

INITIAL SITE SKETCH

SEE ATTACHED "FAST TRACK" SITE PLAN PREPARED BY S & ME, INC

AS BUILT SKETCH

NEED BUILDER'S CONCESSION TO MOVE TANKS W/ the Flow


Permit can be suspended or revoked if any false information is supplied toward securing the permit/any unauthorized changes are made to the site/any unauthorized changes are made in the installation of the system. Improvement Permit with plat valid without expiration ☐ Improvement Permit with site plan valid for sixty months ☑ Authorization to Construct is valid for a period equal to that of Improvement Permit – not to exceed sixty months.

Signed: [signature] date 3/14/08 Installed by: Commercial Services of Statesville

Improvement Permit by: STEVE HEDRICK date 2-26-08 Operation Permit by: [signature] RS date 9-4-08

Authorization to Construct by: [signature] RS date 14 March 08 Existing System Inspection by: ___ date ___

HEALTH DEPT. COPY: WHITE OWNER COPY (FINAL): YELLOW OWNER COPY (INITIAL): PINK

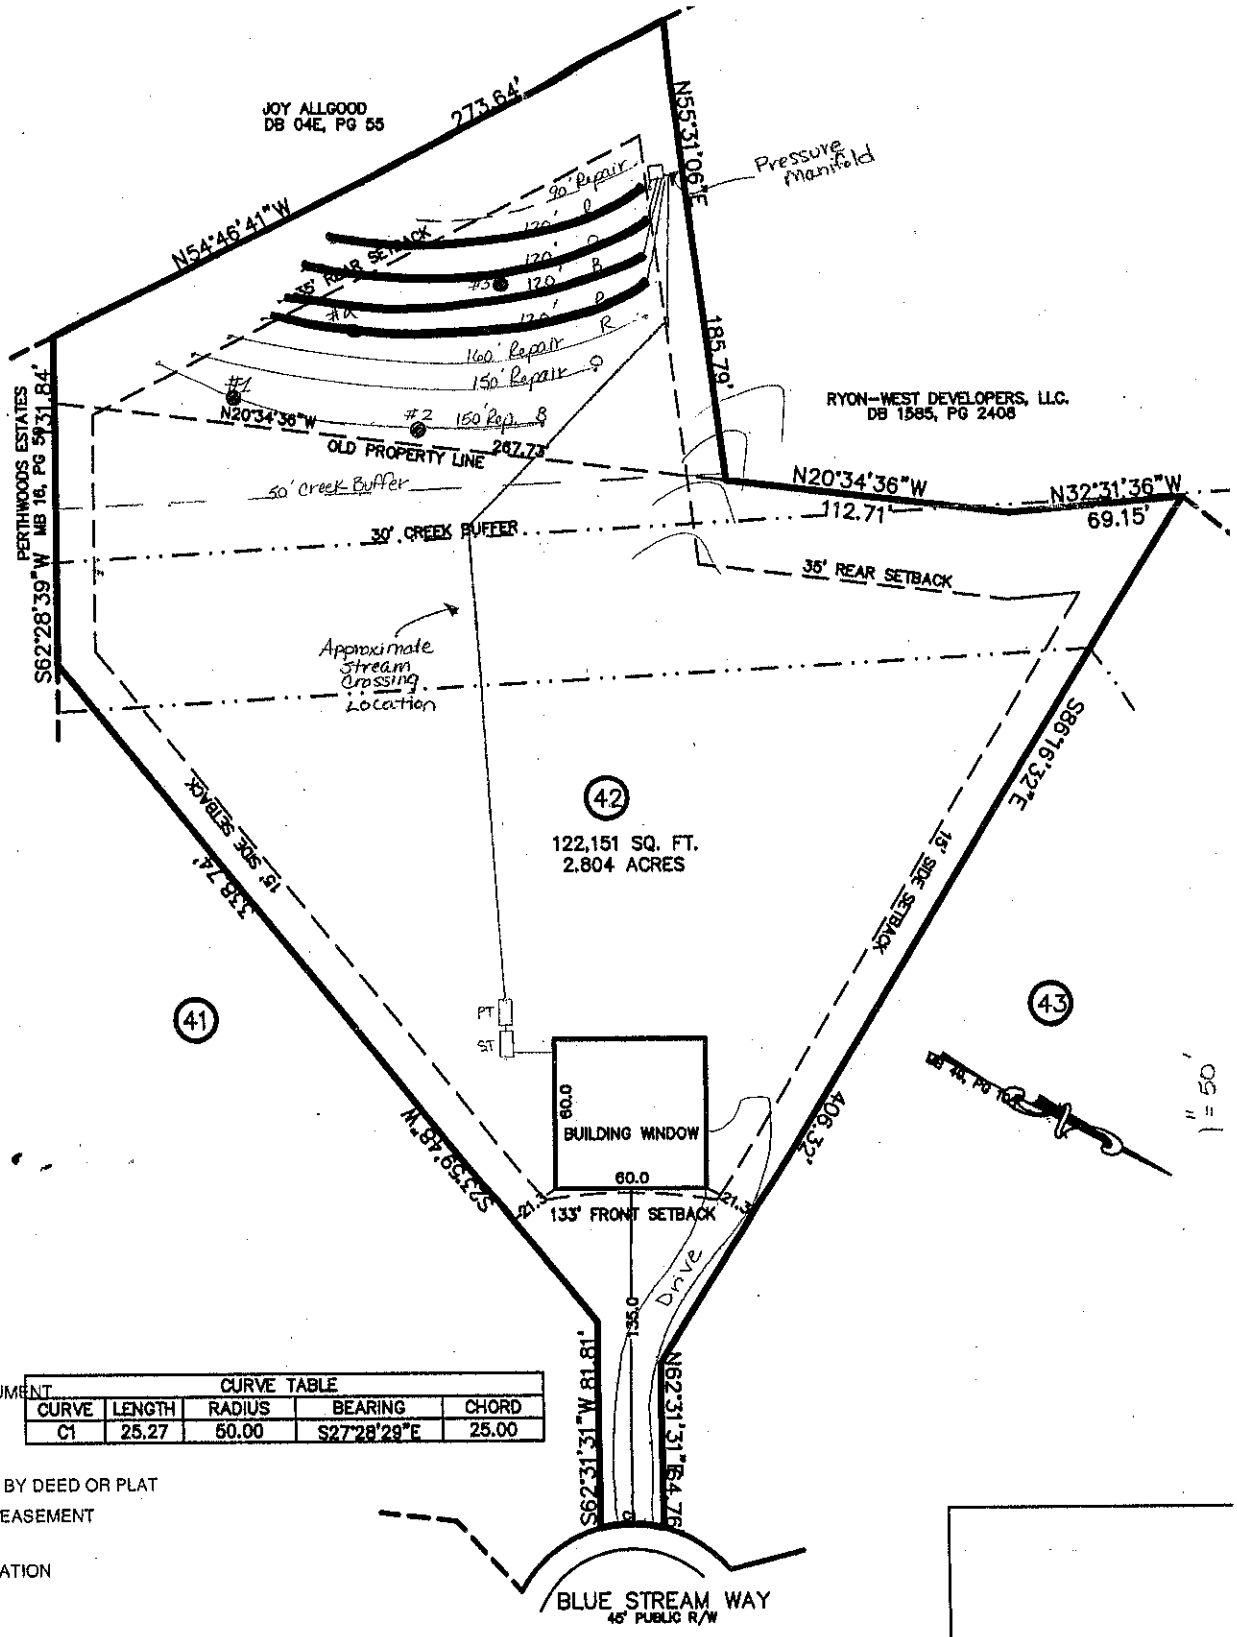

N PIN

NCRETE MONUMENT

PIN

NE

OPERTY LINE BY DEED OR PLAT

M DRAINAGE EASEMENT

1 10,000'

ECTION ELEVATION

:

CURVE TABLE				
CURVE	LENGTH	RADIUS	BEARING	CHORD
C1	25.27	50.00	S27°28'29"E	25.00