CI

IREDELL COUNTY HEALTH DEPARTMENT

STATESVILLE 704-878-5305 MOORESVILLE 704-664-5281

IMPROVEMENT PERMIT / AUTHORIZATION TO CONSTRUCT / OPERATION PERMIT / EXISTING SYSTEM INSPECTION

PERMIT# 132527 PIN# 4730450358 DATE 2-22-06

OWNER OR APPLICANT S&L HOMES PHONE: Business 704-662-8467 Home 704-622-7499

ADDRESS 110 CHARLESTON DR SUITE 108 MOORESVILLE NC 28117

LOCATION PORTH RD SOUTH (R) Stoke PARK (L) RUSHWICK WATER LOT # 11 ATEOS IN EUL-DE-SAC

SUBDIVISION TWIN CREEKS BLOCK / SECTION I LOT 11 LOT AREA 3.04 SEE SITE CLASS. PS DESIGN FLOW 480 L.T.A.R. .25

Septic Tank: 1000 Gallons; STB 1000 Date 6-8-06

Pump Tank: 1000 Gallons; PT 574 Date 10-11-06

Pump Make: ZOELLER Model N-157 Serial No. —

Nitrification Field: No Fields 1 Square Feet Eq=1920 Linear Feet 420

No Lines 4X120 Trench Width 36" Max Trench Bottom Depth 36"

☒ New System ☐ Repair ☐ Expansion System Type: I II (III) IV V VI

System Description: PUMP 25% REDUCT

Repair System Description: LOW PRESS 50% REDUCT

Maintenance Agreement Required: ☐ Yes ☒ No

☒ House/Mod. Home ☐ Mobile Home ☐ Business ☐ Other

No. Bedrooms 4 No. Persons 8 No. Employees —

Water Supply: ☐ Individual ☒ Public ☐ Community

Gravel Depth N/A ☐ Gravity ☒ Pressure ☐ Slab ☒ Crawl Space ☐ Basement w/plumbing ☐ Basement wo/plumbing

Comments:/Conditions:

Comments:/Conditions: BOWLO FILL & MARKER / PERIODS
BUILDER NEEDS TO OK TANK CHANGES OK Mark Loy

INITIAL SITE SKETCH

SEE ATTACHED FAST TRACK PLAN SUBMITTED BY "ROLLINS SOIL AND ENVIRONMENTAL SERVICES"

AS BUILT SKETCH

Permit can be suspended or revoked if any false information is supplied toward securing the permit/any unauthorized changes are made to the site/any unauthorized changes are made in the installation of the system. Improvement Permit with plat valid without expiration ☐ Improvement Permit with site plan valid for sixty months ☒ Authorization to Construct is valid for a period equal to that of Improvement Permit – not to exceed sixty months.

Signed: Mark S. Loy date 3-3-06

Improvement Permit by: [illegible] RS date 2-22-06


Authorization to Construct by: [illegible] date 3-3-06

Installed by: WAYNE CLONTZ

Operation Permit by: [illegible] date 1-25-07

Existing System Inspection by: — date —

HEALTH DEPT. COPY: WHITE OWNER COPY (FINAL): YELLOW OWNER COPY (INITIAL): PINK

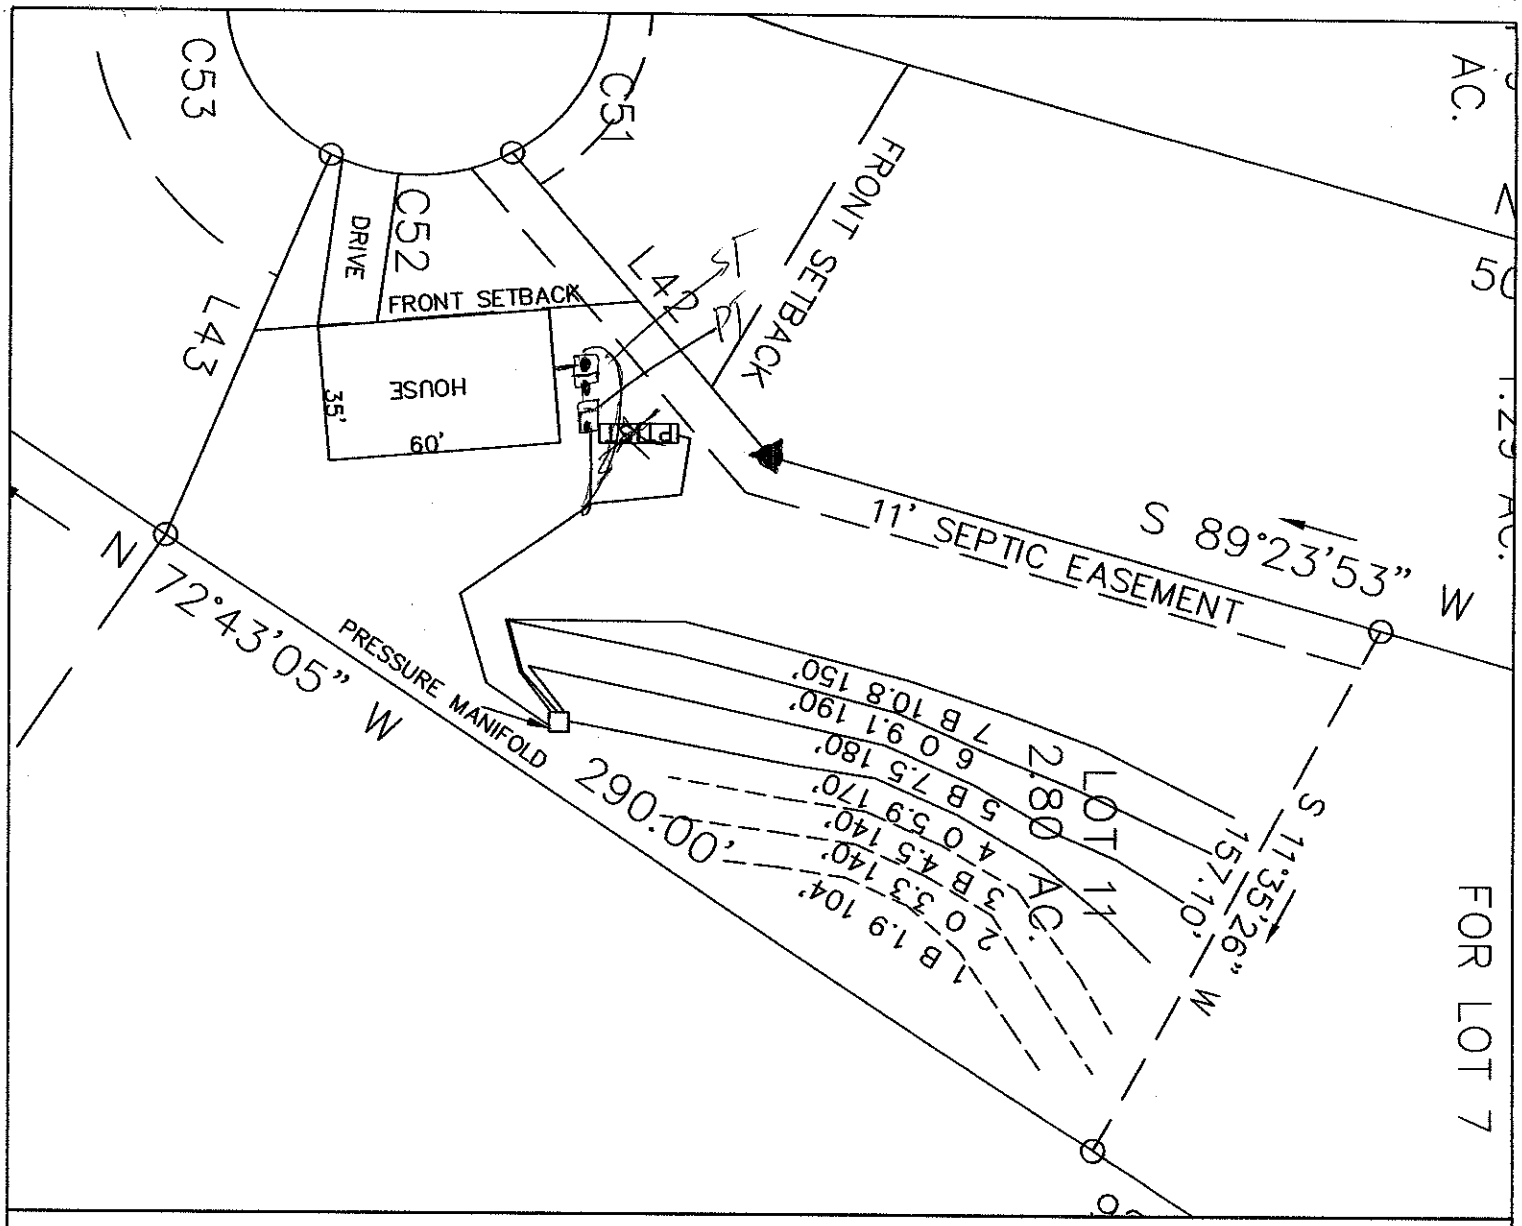

LEGEND

- Areas contain soils with 24 inches or more of useable material and have potential for conventional, modified conventional and low-pressure pipe (lpp) septic systems.
- Unsuitable areas.
- System lines.
- Repair lines.
- Temporary Bench Mark (TBM)
- Well Location.

NORTH

GRAPHIC SCALE
1" = 50'

50 0 50 100

FOR PRELIMINARY PLANNING PURPOSES ONLY. ALL LOTS WILL REQUIRE FINAL APPROVAL BY THE COUNTY HEALTH DEPARTMENT ON A LOT BY LOT BASIS. THIS MAP SHOULD BY USED AS A GENERAL GUIDE, SOME ADJUSTMENTS WILL BE NECESSARY IN THE FIELD DUE TO SOIL VARIABILITY AND COMPLEX TOPOGRAPHIC FEATURES. THIS MAP ONLY REFLECTS EXISTING SOIL SUITABILITY FOR ON-SITE SEPTIC TANK SYSTEMS.

PLEASE REFER TO ATTACHED SOIL REPORT FOR ADDITIONAL SITE SPECIFIC INFORMATION

ROLLANS SOIL & ENVIRONMENTAL SERVICES
2120 GRAHAM ROAD
MOUNT ULLA, NC 28125
PHONE/FAX: (704) 278 - 0989
ASHLEY ROLLANS, NC LICENSED SOIL SCIENTIST
MOBILE: (704) 746 - 5046
EMAIL: ROLLANSFORTCJ@AOL.COM

MAP TITLE: SITE PLAN & DRAINFIELD AREAS

PROJECT NAME: TWIN CREEKS PHASE 1

LOCATION/DATE: STATE PARK ROAD, IREDELL COUNTY, NORTH CAROLINA, JANUARY 2008

JOB # : 01-1042
FILE: C:\JOBS\01-1042
PROJECT MGR.: CBF
FIELD WORK: CBF AND ALP
DRAWN BY: CBF