C

IREDELL COUNTY HEALTH DEPARTMENT

STATESVILLE 704-878-5305 MOORESVILLE 704-664-5281

IMPROVEMENT PERMIT / AUTHORIZATION TO CONSTRUCT / OPERATION PERMIT / EXISTING SYSTEM INSPECTION

PERMIT# 36407 PIN# 4750 45 6302 DATE 1-23-07

OWNER OR APPLICANT Summerwood Homes LLC PHONE: Business 799-8045 Home 704-507-1245

ADDRESS 173 West Main St Rd Mooresville NC 28117

LOCATION State Rd 1151 (2) Twin Creeks at end in Cul-de-sac

SUBDIVISION Twin Creeks BLOCK / SECTION 2 LOT 54 LOT AREA 3.547 AC SITE CLASS. PS DESIGN FLOW 480 L.T.A.R. .13

Septic Tank: 1000 Gallons; STB 1000 Date 2-28-06
Pump Tank: 1000 Gallons; PT 17 Date 3-2-07
Pump Make: Goulds Model WE 1512HH Serial No. P05112556
Nitrification Field: No Fields 1 Square Feet EQ=1600 Linear Feet 270'
No Lines 4 Trench Width 24" Max Trench Bottom Depth 36" Gravel Depth N/A ☐ Gravity ☒ Pressure

☒ New System ☐ Repair ☐ Expansion System Type: I II III (IV) V VI
System Description: Low Pressure 50%
Repair System Description: Low Pressure Pipe
Maintenance Agreement Required: ☒ Yes ☐ No

☒ House/Mod. Home ☐ Mobile Home ☐ Business ☐ Other
No. Bedrooms 4 No. Persons 8 No. Employees

Water Supply: ☒ Individual ☐ Public ☒ Community

☐ Slab ☒ Crawl Space ☐ Basement w/plumbing ☐ Basement wo/plumbing

Comments:/Conditions: (1) Install Lines on Contours (2) Maintain Setbacks (3) System #three is Completely Flagged Out (4) Call Rick to Installation for System Specs if Needed.

INITIAL SITE SKETCH

Refer to Included Site Sketch by Lorne Cook, R.S.

Comments:/Conditions:
Septic Tank Marker
Yellow tag tie
Pump tank lid seen

AS BUILT SKETCH

Permit can be suspended or revoked if any false information is supplied toward securing the permit/any unauthorized changes are made to the site/any unauthorized changes are made in the installation of the system. Improvement Permit with plat valid without expiration ☐ Improvement Permit with site plan valid for sixty months ☒ Authorization to Construct is valid for a period equal to that of Improvement Permit – not to exceed sixty months.

Signed: [signature] date 1-25-07
Improvement Permit by: [signature] date 1-23-07
Authorization to Construct by: [signature] date 1-23-07

Installed by: Steve Jordan
Operation Permit by: [signature] date 8-16-07
Existing System Inspection by: date

HEALTH DEPT. COPY: WHITE OWNER COPY (FINAL): YELLOW OWNER COPY (INITIAL): PINK


Permit # 136407

Pin # 4730456302

PERMIT SKETCH

* House Staked By Surveyor *

* System FLAGGED OUT *

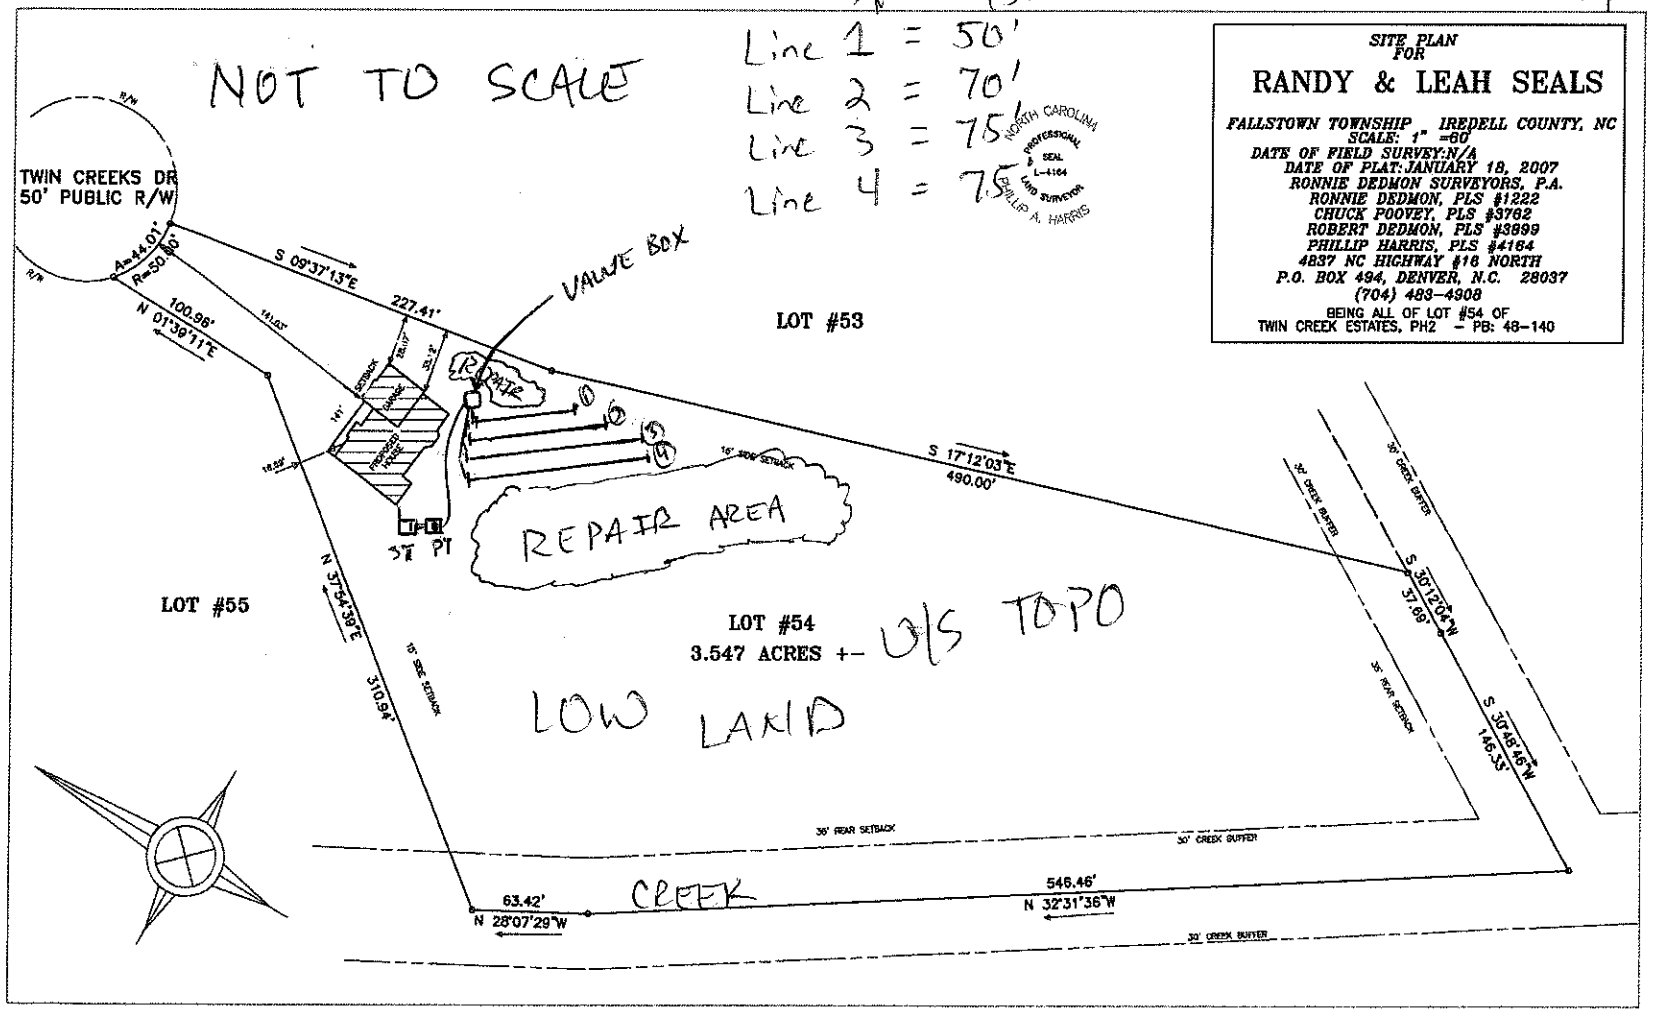

PDF Created with deskPDF TS PDF Writer - DEMO :: http://www.docudesk.com