IREDELL COUNTY HEALTH DEPARTMENT

STATESVILLE 704-878-5305 CF MOORESVILLE 704-664-5281

IMPROVEMENT PERMIT / AUTHORIZATION TO CONSTRUCT / OPERATION PERMIT / EXISTING SYSTEM INSPECTION

PERMIT# 135334 PIN# 4730 45 7722 DATE 1-5-07

OWNER OR APPLICANT MATT BUFFKINS PHONE: Business 704-361-1085 Home

ADDRESS 1063 CAPEL CT GASTONIA, NC 28056

LOCATION SIX MILE RD (L) TWIN CREEKS AT END OF LEFT

SUBDIVISION TWIN CREEKS 03 BLOCK / SECTION 02 LOT 52 LOT AREA .97AC SITE CLASS. PS DESIGN FLOW 480 L.T.A.R. 13

Septic Tank: 1000 Gallons; STB 1007 Date 11-20-06
Pump Tank: Gallons; PT Date
Pump Make: Model Serial No.
Nitrification Field: No Fields 1 Square Feet EB=1600 Linear Feet 400'
No Lines 5 @ 80' Trench Width 36" Max Trench Bottom Depth 36"

☒ New System ☐ Repair ☐ Expansion System Type: I (II) III IV V VI
System Description: CONV W/ 25% REDUCTION
Repair System Description: LP 50'/-
Maintenance Agreement Required: ☐ Yes ☒ No

☒ House/Mod. Home ☐ Mobile Home ☐ Business ☐ Other
No. Bedrooms 4/6 No. Persons 6 No. Employees


Water Supply: ☐ Individual ☒ Public ☐ Community

Gravel Depth N/A ☒ Gravity ☐ Pressure ☐ Slab ☒ Crawl Space ☐ Basement w/plumbing ☐ Basement wo/plumbing

Comments:/Conditions: ① HOUSE BUILT & SYSTEM FLAGGED COMPLETELY. ② START GRADE AT SHALLOWEST POINT WITH 5" OF COVER & DIG FROM THERE. ③ MAINTAIN SETBACKS ④ FILL & PACK SMALL


INITIAL SITE SKETCH

1" = 50'

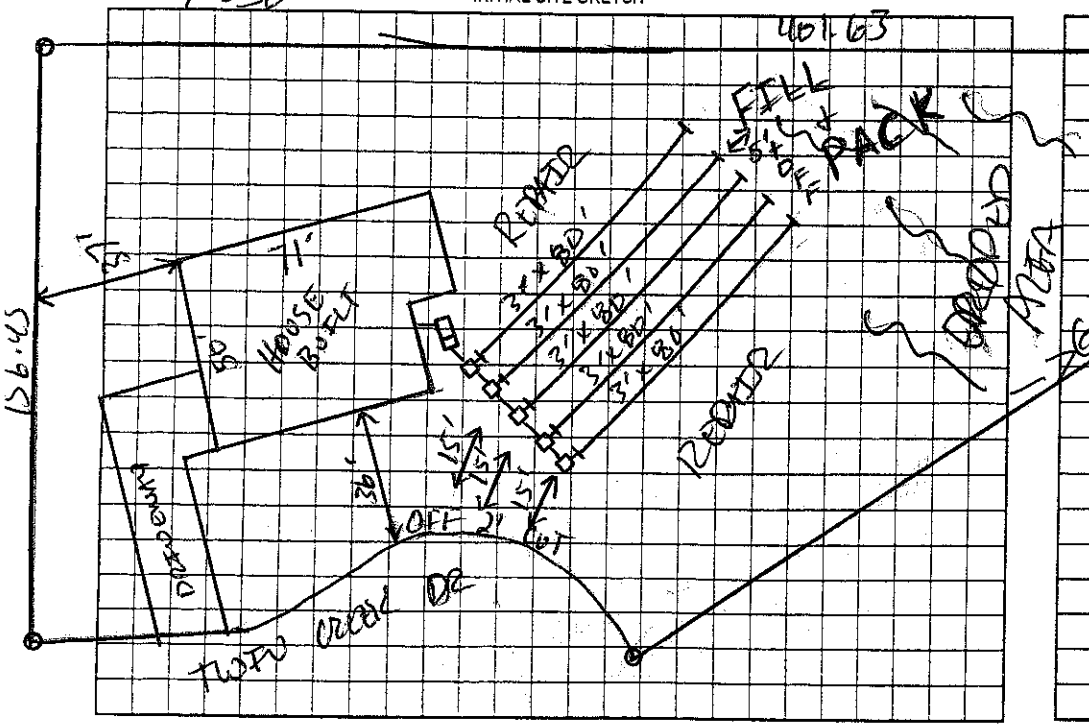

Comments:/Conditions: WASHOUTS STARTED AT END OF LINES 5' OFF AS DRAWN & FLAGGED ⑤ THIS IS A REDRAW & SOIL WORK WAS PREVIOUSLY DONE BY DAVID HINSON, R.S

AS BUILT SKETCH

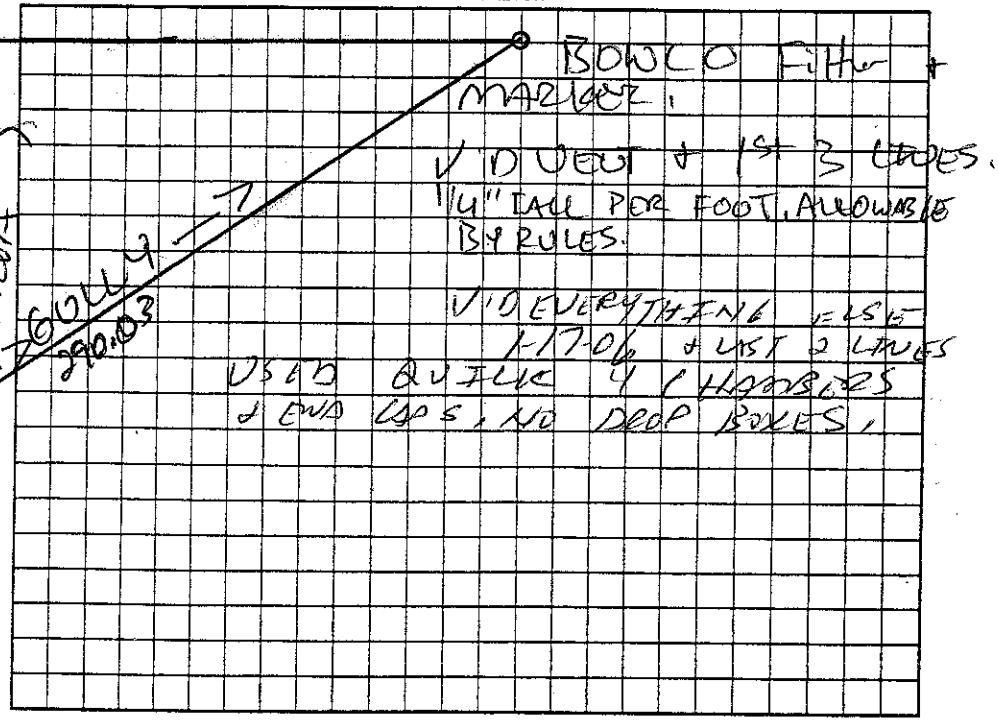

Permit can be suspended or revoked if any false information is supplied toward securing the permit/any unauthorized changes are made to the site/any unauthorized changes are made in the installation of the system. Improvement Permit with plat valid without expiration ☐ Improvement Permit with site plan valid for sixty months ☒ Authorization to Construct is valid for a period equal to that of Improvement Permit – not to exceed sixty months.

Signed: date 1/8/07

Improvement Permit by: date 1-5-07

Authorization to Construct by: date 1-5-07

Installed by: WAYNE CONTZ

Operation Permit by: PS date 1-17-06

Existing System Inspection by: date

HEALTH DEPT. COPY: WHITE OWNER COPY (FINAL): YELLOW OWNER COPY (INITIAL): PINK