IREDELL COUNTY HEALTH DEPARTMENT

STATESVILLE 704-878-5305 CF MOORESVILLE 704-664-5281

IMPROVEMENT PERMIT / AUTHORIZATION TO CONSTRUCT / OPERATION PERMIT / EXISTING SYSTEM INSPECTION

PERMIT# 148883 PIN# 4730-46-2033 DATE 3-17-08

OWNER OR APPLICANT NEW AMERICAN BUILDERS PHONE: Business 704-201-8855 Home 704-843-2006

ADDRESS C/O S & ME INC, 385 TIMBER RD, SUITE 104, MOORESVILLE, NC 28115-7899

LOCATION PERTH ROAD TO STATE PARK ROAD, TL TWIN CREEKS DRIVE, LOT ON RIGHT AT WINDING CREEK DR

SUBDIVISION TWIN CREEKS BLOCK / SECTION II LOT 58/58A LOT AREA 0.96 ACRE ± SITE CLASS. PS DESIGN FLOW 360 L.T.A.R. 0.30 GPD/FT²

Septic Tank: 1000 Gallons; STB 794 Date 4-9-08
Pump Tank: 1000 Gallons; PT 283 Date 5-17-08
Pump Make: ZOELLER Model N296 Serial No. E406-C
Nitrification Field: No Fields 1 Square Feet 1200 Linear Feet 300
No Lines FIVE Trench Width 36" Max Trench Bottom Depth 30"

☑ New System ☐ Repair ☐ Expansion System Type: I II III IV V VI
System Description: 25% REDUCTION, PUMP
Repair System Description: 50% REDUCTION, LOW-PRESSURE
Maintenance Agreement Required: ☐ Yes ☑ No
Gravel Depth N/A ☐ Gravity ☑ Pressure ☐ Slab ☑ Crawl Space ☐ Basement w/plumbing ☐ Basement wo/plumbing

☑ House/Mod. Home No. Bedrooms 3
☐ Mobile Home No. Persons ___
☐ Business No. Employees ___
☐ Other ___

Water Supply: ☐ Individual ☑ Public ☐ Community

Comments:/Conditions: ① INSTALL 25% REDUCTION SYSTEM ON CONTOUR AS SHOWN IN PLAN, NO DEEPER THAN 30" ② SEE ATTACHED SHEETS FOR PUMP & PRESSURE MANIFOLD REQUIREMENTS.

INITIAL SITE SKETCH

SEE ATTACHED "FAST TRACK" SITE PLAN PREPARED BY S & ME, INC

Comments:/Conditions: POLYLOK Filter & MARKER
* BUILDER OK'S TANK CHANGES
Allen Stancill
REVISION Received 7/21/08 & Attached

AS BUILT SKETCH

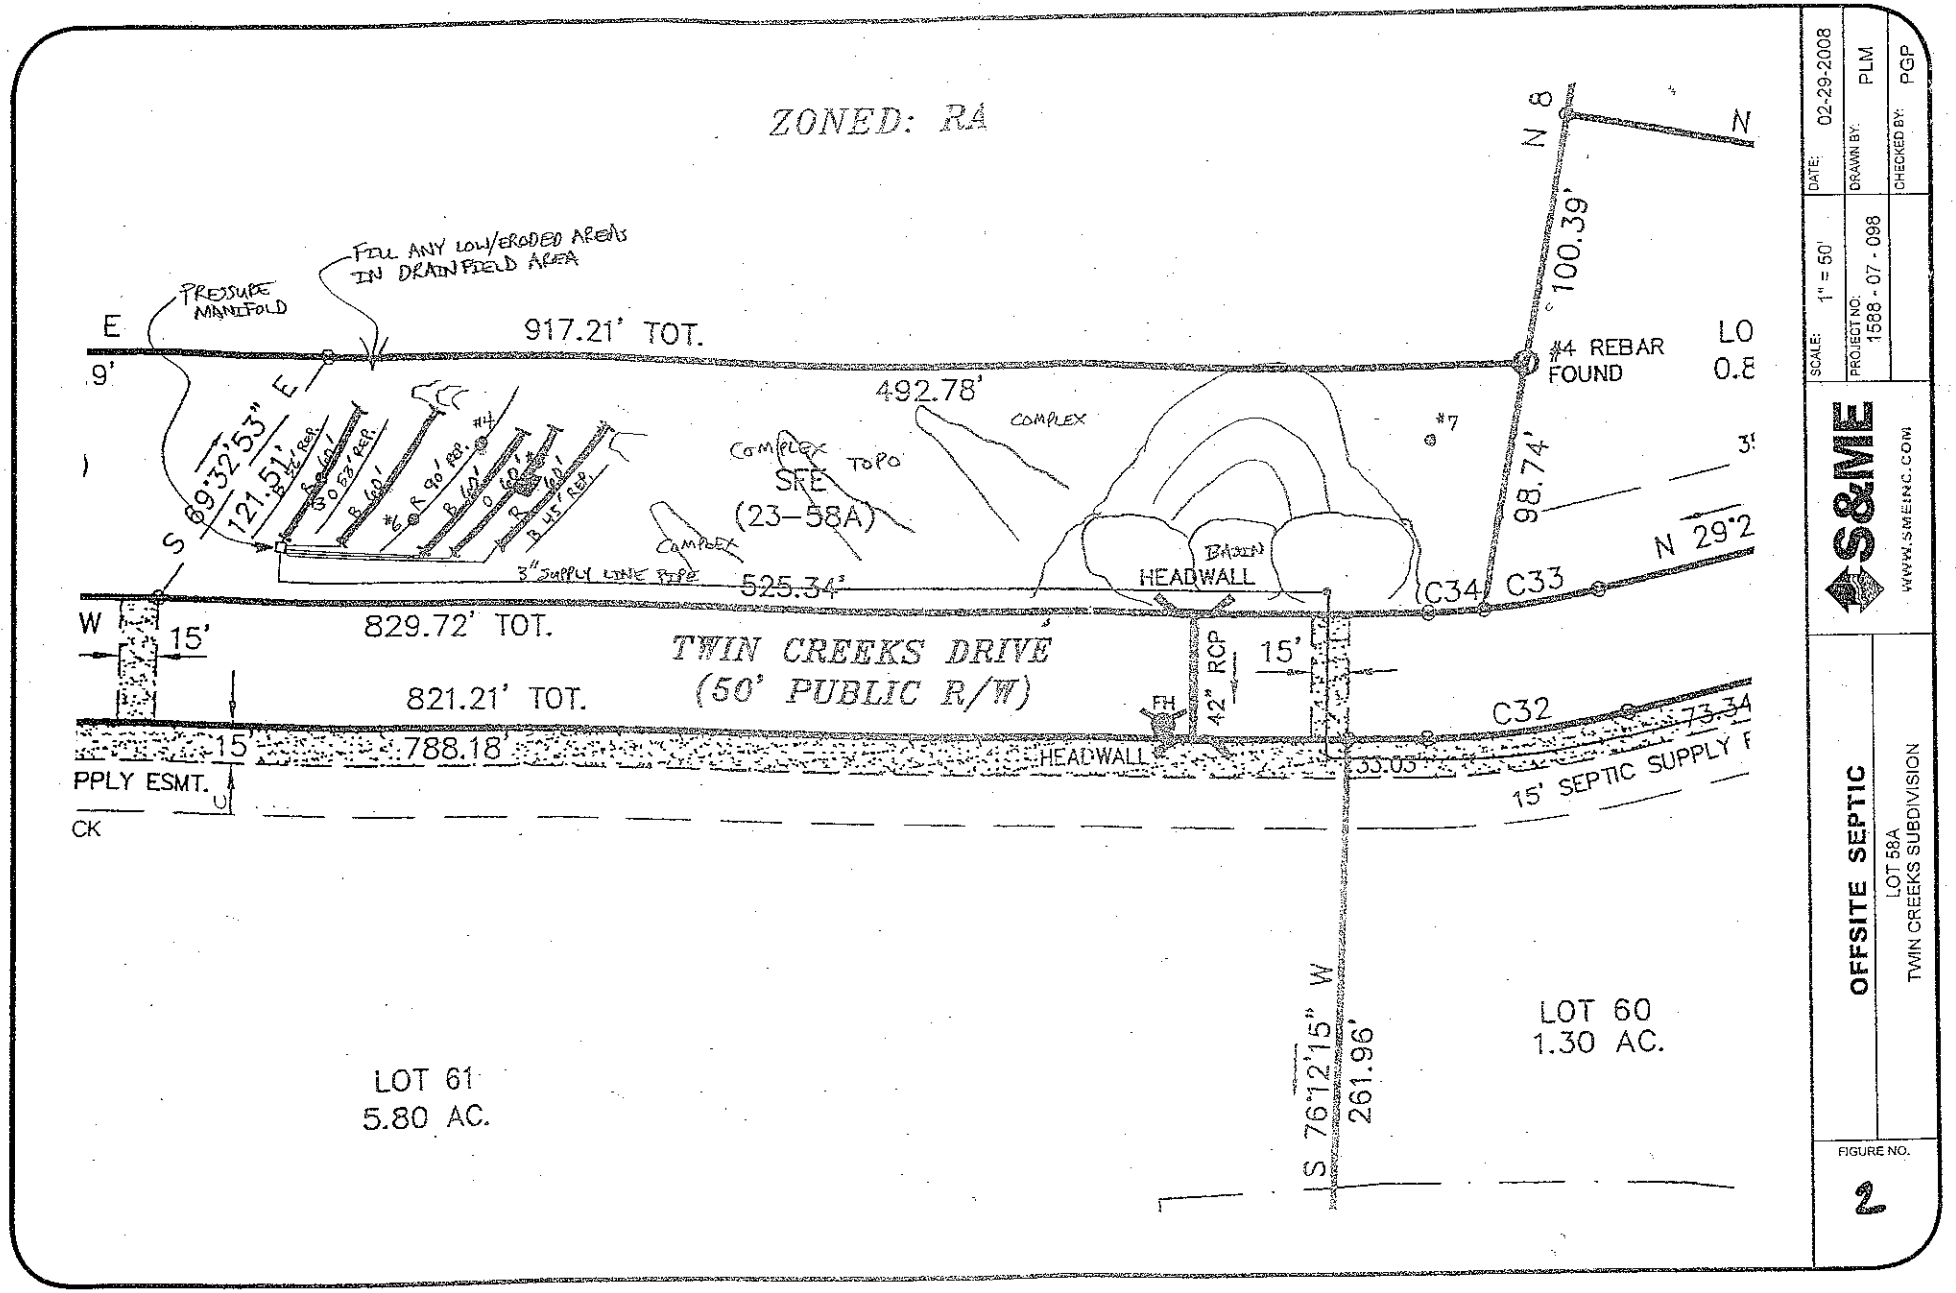
Permit can be suspended or revoked if any false information is supplied toward securing the permit/any unauthorized changes are made to the site/any unauthorized changes are made in the installation of the system. Improvement Permit with plat valid without expiration ☐ Improvement Permit with site plan valid for sixty months ☑ Authorization to Construct is valid for a period equal to that of Improvement Permit – not to exceed sixty months.

Signed: [signature] date 4/4/08 Installed by: Commercial Services of Stanfield

Improvement Permit by: STEVE HENDRICK date 3-17-08 Operation Permit by: [signature] date 9-11-08

Authorization to Construct by: STEVE HENDRICK date 4-4-08 Existing System Inspection by: ___ date ___

HEALTH DEPT. COPY: WHITE OWNER COPY (FINAL): YELLOW OWNER COPY (INITIAL): PINK


ZONED: RA
FILL ANY LOW/ERODED AREAS IN DRAINFIELD AREA
PRESSURE MANIFOLD
917.21' TOT.
#4 REBAR FOUND
100.39'
98.74'
492.78'
COMPLEX
SRE (23-58A)
#7
3" SUPPLY LINE PIPE
525.34'
HEADWALL
BASIN
C34
C33
N 29°2
829.72' TOT.
TWIN CREEKS DRIVE
(50' PUBLIC R/W)
15'
821.21' TOT.
42" RCP
FH
C32
788.18'
HEADWALL
15' SEPTIC SUPPLY F
PPLY ESMT.
CK
LOT 61
5.80 AC.
LOT 60
1.30 AC.
261.96'
LOT 58A
TWIN CREEKS SUBDIVISION
OFFSITE SEPTIC
FIGURE NO.
2
SCALE: 1" = 50'
PROJECT NO: 1588 - 07 - 098
DATE: 02-29-2008
DRAWN BY: PLM
CHECKED BY: PGP
S&ME
WWW.SMEINC.COM