IREDELL COUNTY HEALTH DEPARTMENT

c/ Scott Graves

STATESVILLE 704-878-5305 MOORESVILLE 704-664-5281

IMPROVEMENT PERMIT / AUTHORIZATION TO CONSTRUCT / OPERATION PERMIT / EXISTING SYSTEM INSPECTION

PERMIT# 139659 PIN# 4723046436 DATE 1-4-07

OWNER OR CONTRACTOR S & L Homes, Inc PHONE: Business 704-662-8467 Home

ADDRESS 110 Charlotte Drive Suite 108 Mooresville NC 28117

LOCATION State Park Rd to Twin Creeks Dr to Winding Creek on left

SUBDIVISION Twin Creeks BLOCK / SECTION LOT 20 LOT AREA 5.8 SITE CLASS. PS DESIGN FLOW 450 L.T.A.R. .25

Septic Tank: 1000 Gallons; STB 1000 Date 12-7-07
Pump Tank: 1000 Gallons; PT 271 Date 5-7-07
Pump Make: Zoeller Model V-163 Serial No.
Nitrification Field: No Fields Square Feet 1920 Linear Feet 320
No Lines 4 Trench Width 24" Max Trench Bottom Depth 36" Gravel Depth

☐ New System ☐ Repair System Type: I, II, III, IV, V, VI
System Description: 50% Low Pressure
Repair System Description: 50% Low Pressure
Maintenance Agreement Required: ☐ Yes ☐ No

☑ House/Mod. Home No. Bedrooms 4
☐ Mobile Home No. Bathrooms
☐ Business No. Employees
☐ Other


☐ Slab ☑ Crawl Space ☐ Basement w/plumbing ☐ Basement wo/plumbing

Water Supply: ☐ Individual ☑ Public ☐ Community


Comments:/Conditions: Fill for possible drainage Install on contour Maintain all setbacks

Comments:/Conditions: ④ @ 80' each Range Banco Life

INITIAL SITE SKETCH

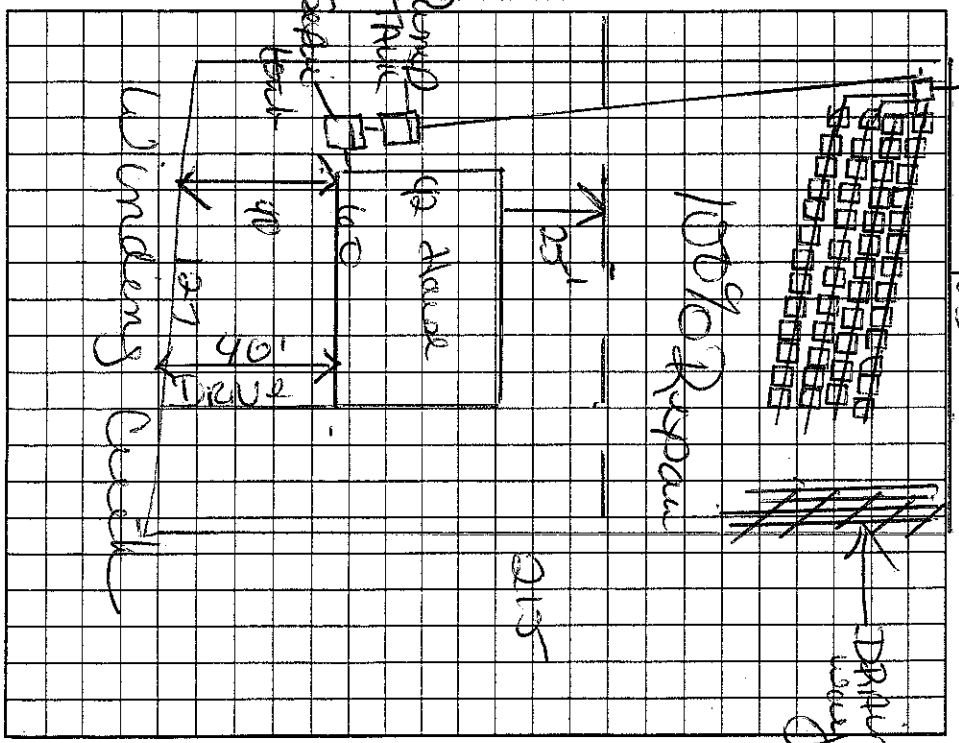

AS BUILT SKETCH

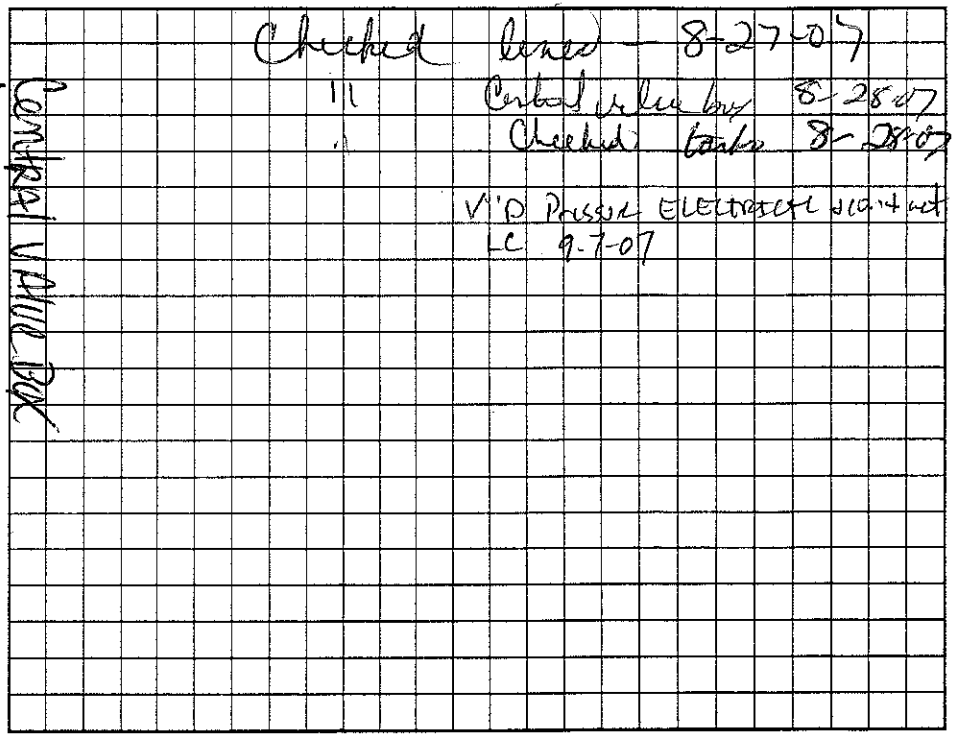

Permit can be suspended or revoked if any false information is supplied toward securing the permit/any unauthorized changes are made to the site/any unauthorized changes are made in the installation of the system. Improvement Permit with plat valid without expiration. Improvement Permit with site plan valid for sixty months. Authorization to Construct is valid for a period equal to that of Improvement Permit – not to exceed sixty months.

Signed: Mark L. Kay date 1-8-07 Installed by: Wayne Clontz

Improvement Permit by: Kerry Cook date 1-4-07 Operation Permit by: date 9-7-07

Authorization to Construct by: Kerry Cook date 1-4-07 Existing System Inspection by: date

HEALTH DEPT. COPY: WHITE OWNER COPY (FINAL): YELLOW OWNER COPY (INITIAL): PINK