IREDELL COUNTY HEALTH DEPARTMENT

Scott Graves

STATESVILLE 704-878-5305 MOORESVILLE 704-664-5281

IMPROVEMENT PERMIT / AUTHORIZATION TO CONSTRUCT / OPERATION PERMIT / EXISTING SYSTEM INSPECTION

PERMIT# 139659 PIN# 4730466363

OWNER OR CONTRACTOR S&L Homes Inc DATE 1-4-07

ADDRESS 110 Charleston Drive Suite 108 Mooresville NC 28117 PHONE: Business 704-662-8467 Home

LOCATION Statepark Rd to Twin Creek Dr. to Winding Creek on left

SUBDIVISION Twin Creek BLOCK / SECTION ____ LOT 26 LOT AREA .58 SITE CLASS. PS DESIGN FLOW 480 L.T.A.R. .125

Septic Tank: 1000 Gallons; STB 1007 Date 6-7-07

Pump Tank: 1000 Gallons; PT 271 Date 5-7-07

Pump Make: Zoeller Model N-163 Serial No.

Nitrification Field: No Fields ____ Square Feet 1920 Linear Feet 320

No Lines 4 Trench Width 24" Max Trench Bottom Depth 36" Gravel Depth

☑ New System ☐ Repair System Type: I, II, III, (IV), V, VI

System Description: 50% low Pres

Repair System Description: 50% low Pres

Maintenance Agreement Required: ☑ Yes ☐ No

☐ Slab ☑ Crawl Space ☐ Basement w/plumbing ☐ Basement wo/plumbing

☑ House/Mod. Home No. Bedrooms 4

☐ Mobile Home No. Bathrooms ____

☐ Business No. Employees ____


☐ Other

Water Supply: ☐ Individual ☑ Public ☐ Community

Comments:/Conditions: Fill for positive drainage. Install on contour. Maintain all setbacks

Comments:/Conditions: (4) @ 80' each. Range Bosco Lite

INITIAL SITE SKETCH

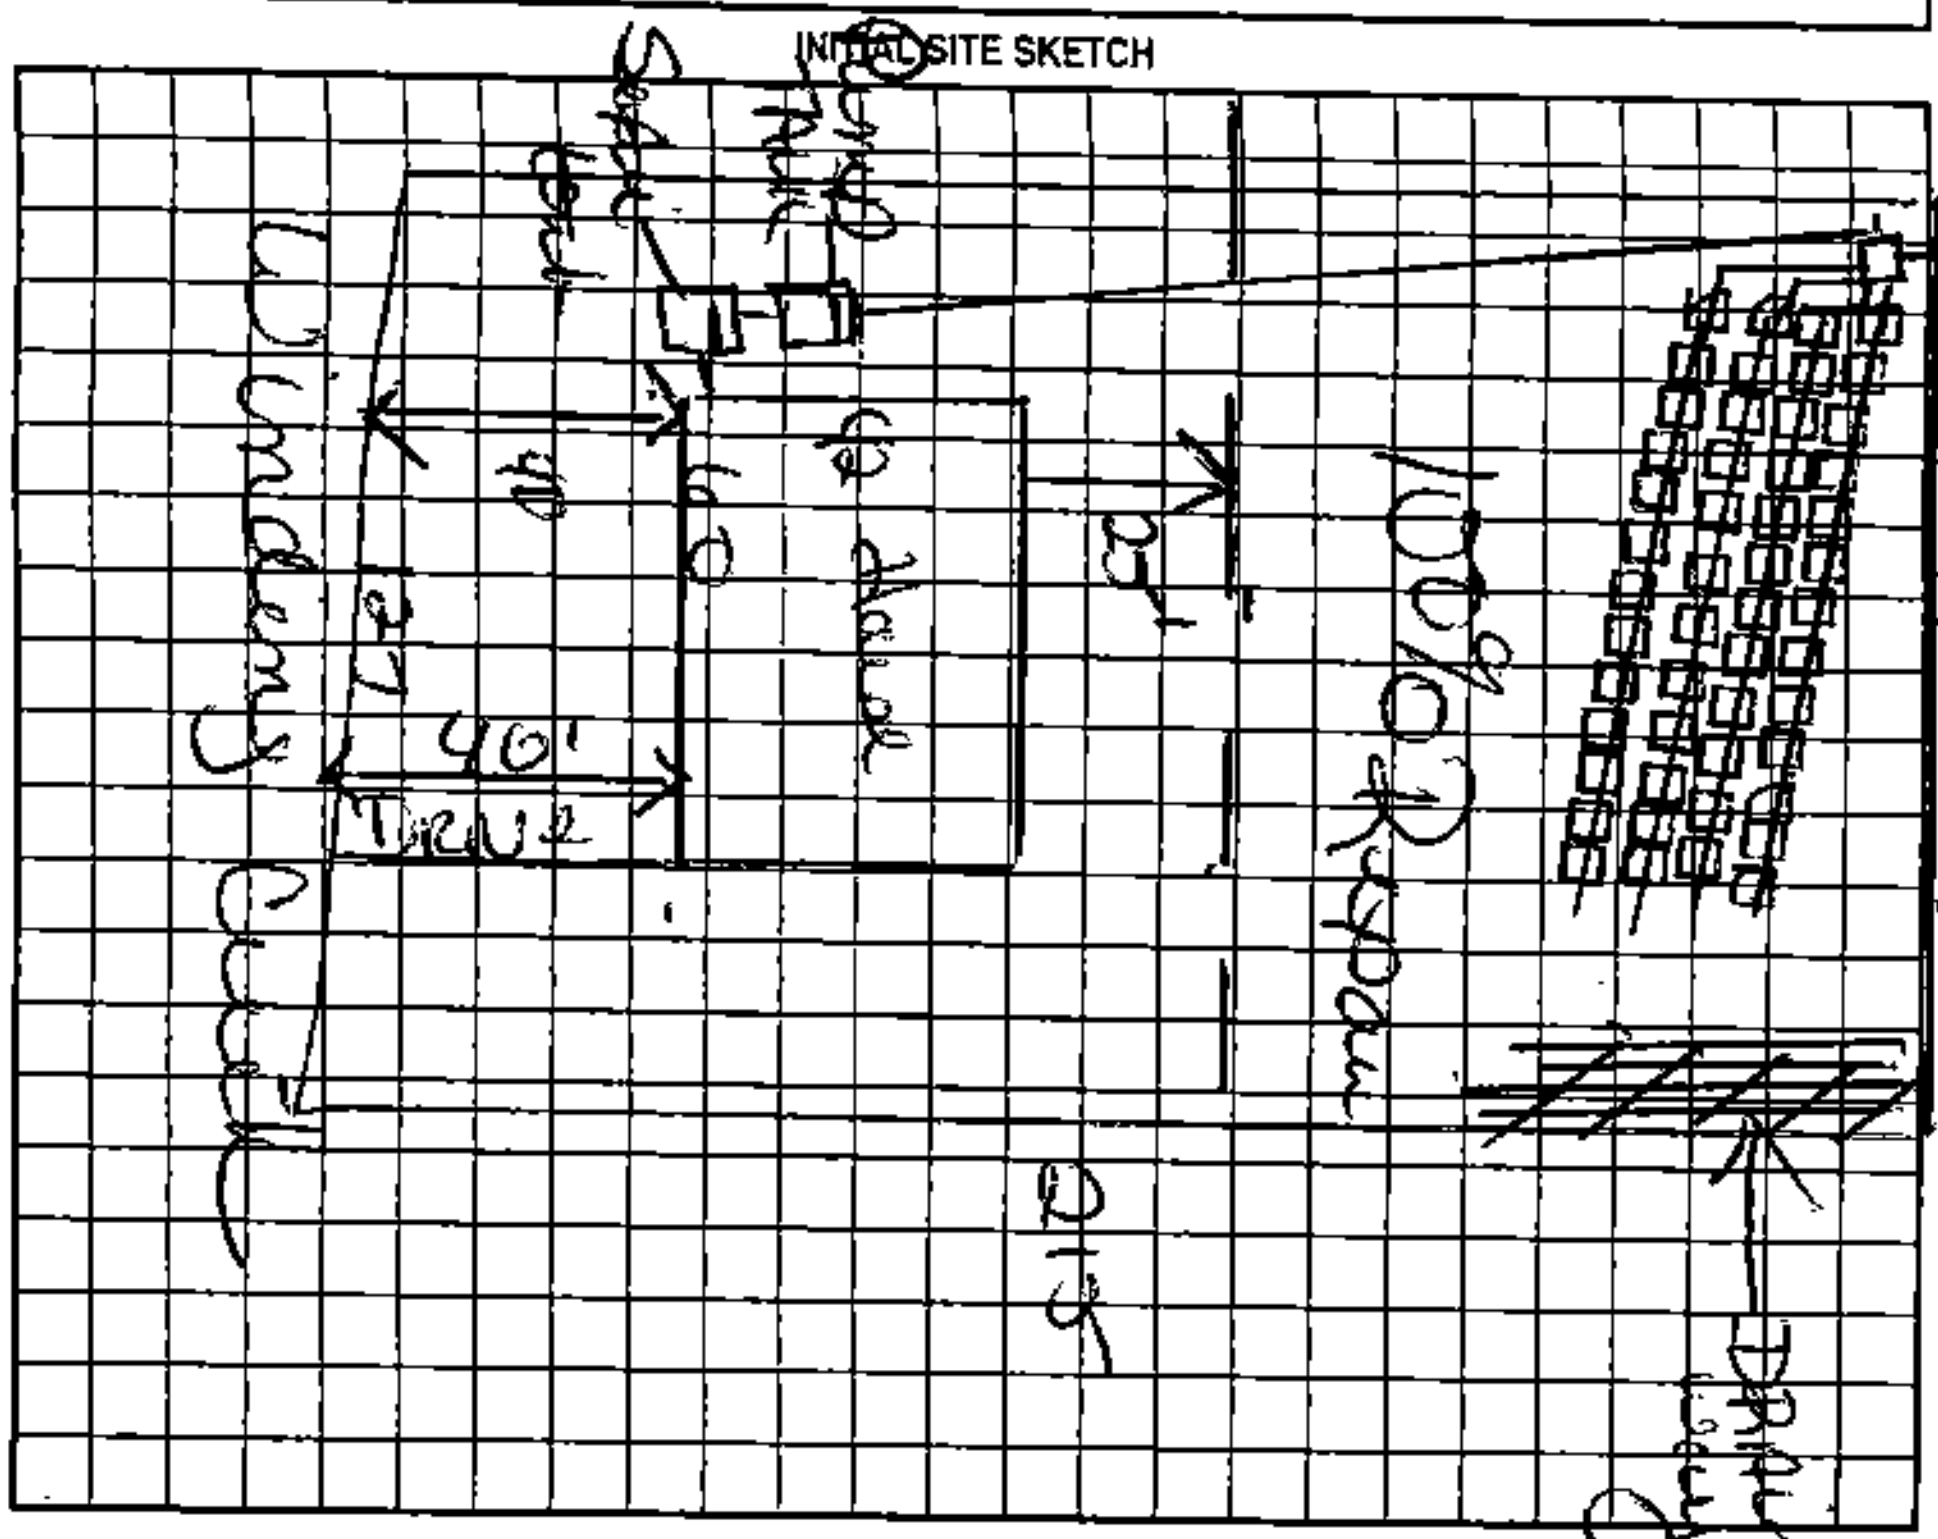

AS BUILT SKETCH

Checked lines 8-27-07

Checked control valve box 8-28-07

Checked tanks 8-28-07

V'D Passive ELECTRICAL 4/9-07 LC 9-7-07

Permit can be suspended or revoked if any false information is supplied toward securing the permit/any unauthorized changes are made to the site/any unauthorized changes are made in the installation of the system. Improvement Permit with plat valid without expiration. Improvement Permit with site plan valid for sixty months. Authorization to Construct is valid for a period equal to that of Improvement Permit – not to exceed sixty months.

Signed: Mark S. Kay date 1-8-07

Improvement Permit by: Kerry Cook date 1-4-07

Authorization to Construct by: Kerry Cook date 1-4-07

Installed by: Wayne Cantz

Operation Permit by: [signature] RS date 9-7-07

Existing System Inspection by: ____ date ____

HEALTH DEPT. COPY: WHITE OWNER COPY (FINAL): YELLOW OWNER COPY (INITIAL): PINK