Lee Pilney

IREDELL COUNTY HEALTH DEPARTMENT

STATESVILLE 704-878-5305 MOORESVILLE 704-664-5281

IMPROVEMENT PERMIT / AUTHORIZATION TO CONSTRUCT / OPERATION PERMIT / EXISTING SYSTEM INSPECTION

PERMIT# 134730 PIN# 4730467385 DATE 5-22-06

OWNER OR APPLICANT Summerwood Homes PHONE: Business 704-799-8085 Home

ADDRESS 173 West Marantha RD Mooresville NC

LOCATION State Park RD (R) on Twin Creek (R) Winding Creek 4th lot on left

SUBDIVISION Twin Creek BLOCK / SECTION LOT 27 LOT AREA .77 SITE CLASS PS DESIGN FLOW 360 L.T.A.R. .3

Septic Tank: 1000 Gallons; STB 1072 Date 11-7-06

Pump Tank: 1000 Gallons; PT 1 Date 8-27-06

Pump Make: Model WE0312M Serial No. 6auL8013

Nitrification Field: No Fields Square Feet 1200 Linear Feet 300

No Lines 3 Trench Width 24" Max Trench Bottom Depth 36"

☑ New System ☐ Repair ☐ Expansion System Type: I II III ⓘⓥ V VI

System Description: 50% pump low bed

Repair System Description: 50 pump lowbed

Maintenance Agreement Required: ☑ Yes ☐ No

Gravel Depth NA ☐ Gravity ☐ Pressure ☐ Slab ☑ Crawl Space ☐ Basement w/plumbing ☐ Basement wo/plumbing


☑ House/Mod. Home No. Bedrooms 3
☐ Mobile Home No. Persons
☐ Business No. Employees
☐ Other

Water Supply: ☐ Individual ☑ Public ☐ Community

Comments/Conditions: Maintain all setbacks. Maintain 15' away from pool. 5' off house foundation. SHMOE1357

Comments/Conditions: 3 @ 70' each - Panel Block pump to central Valve Box

INITIAL SITE SKETCH

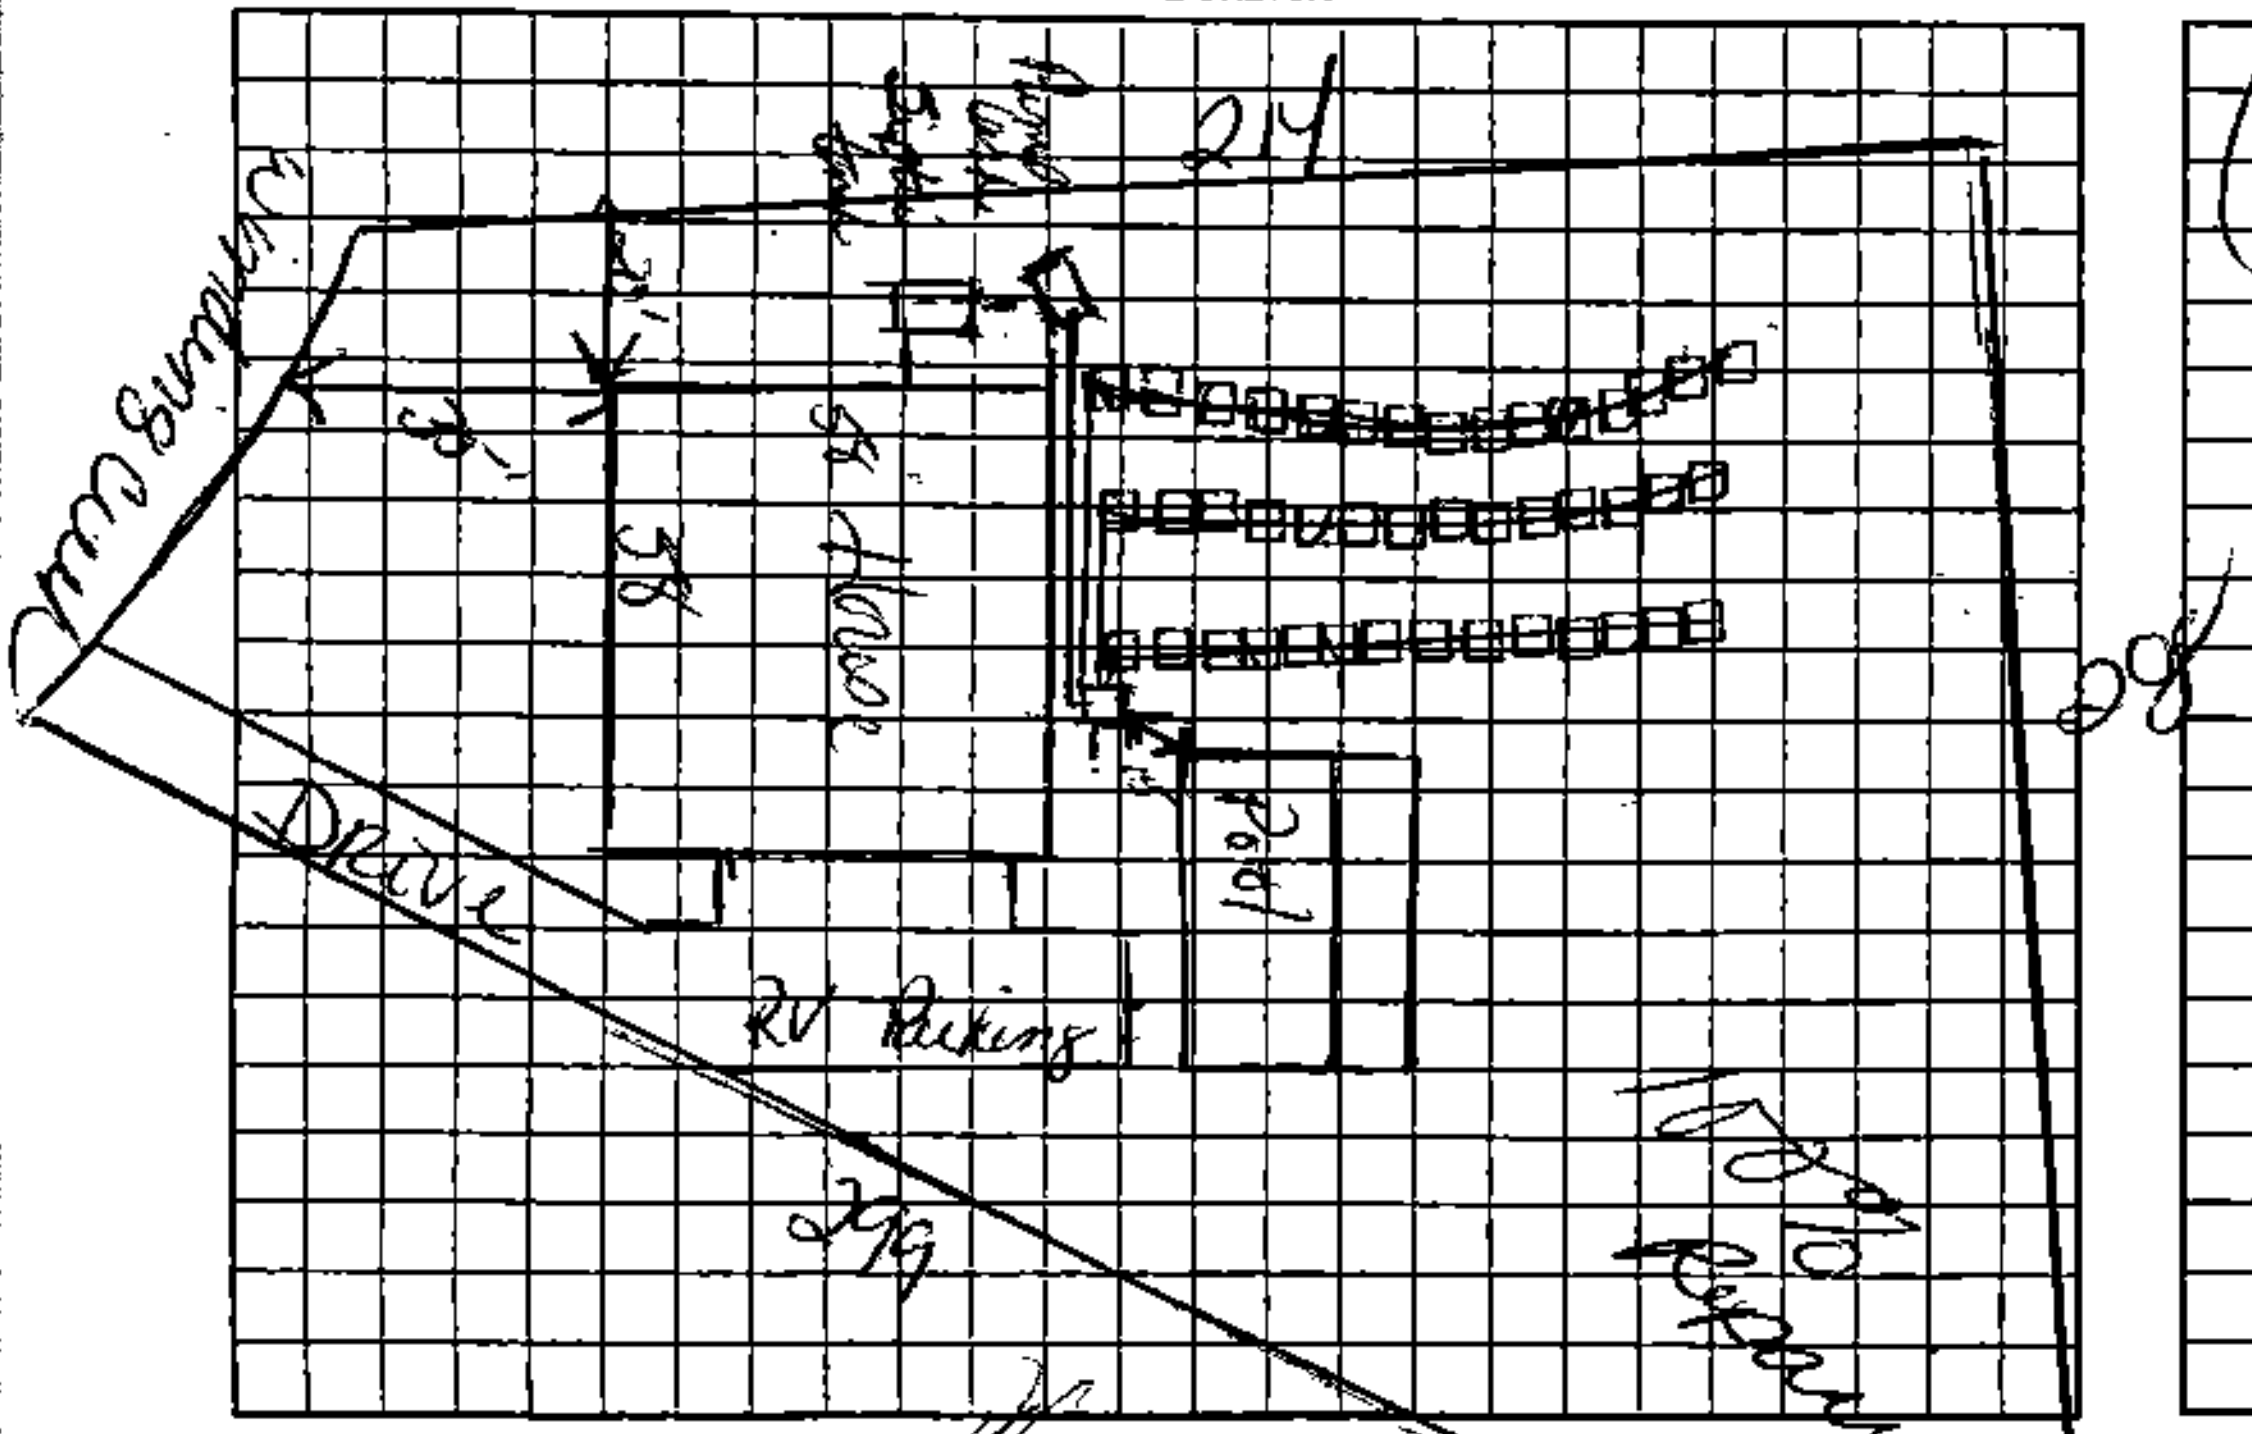

AS BUILT SKETCH

(1"=50')

Permit can be suspended or revoked if any false information is supplied toward securing the permit/any unauthorized changes are made to the site/any unauthorized changes are made in the installation of the system. Improvement Permit with plat valid without expiration ☐ Improvement Permit with site plan valid for sixty months ☐ Authorization to Construct is valid for a period equal to that of Improvement Permit – not to exceed sixty months.

Signed: date 5/24/06

Improvement Permit by: Keith Cook date 5-22-06

Authorization to Construct by: Keith Cook date 5-23-06

Installed by: Steve Jordan

Operation Permit by: Keith Cook date 2-12-07

Existing System Inspection by: date

HEALTH DEPT. COPY: WHITE OWNER COPY (FINAL): YELLOW OWNER COPY (INITIAL): PINK