(CI)

# IREDELL COUNTY HEALTH DEPARTMENT

STATESVILLE 704-878-5305 MOORESVILLE 704-664-5281

## IMPROVEMENT PERMIT / AUTHORIZATION TO CONSTRUCT / OPERATION PERMIT / EXISTING SYSTEM INSPECTION

PERMIT# 139060 PIN# 4730469173 DATE 1-5-07

OWNER OR APPLICANT J & L Homes, LLC PHONE: Business 704-662-8467 Home

ADDRESS 110 Charleston Blvd Suite 1 Mooresville NC 28117

LOCATION Sifers Park RD to intersection Twin Creeks to Indian Creek to lot on left

SUBDIVISION Twin Creeks BLOCK / SECTION LOT 29 LOT AREA 1.57 SITE CLASS. 03 DESIGN FLOW 480 L.T.A.R. .13

Septic Tank: 1000 Gallons: STB 1807 Date 4-9-07

Pump Tank: 1000 Gallons: PT 274 Date 4-18-07

Pump Make: Zoeller Model N-152 Serial No.

Nitrification Field: No Fields Square Feet 1600 Linear Feet 267

No Lines 4 Trench Width Max Trench Bottom Depth Gravel Depth ☐ Gravity ☐ Pressure

☐ New System ☐ Repair ☐ Expansion System Type: I II III IV V VI

System Description: 50% Low Pressure

Repair System Description: 50% Low Pressure

Maintenance Agreement Required: ☐ Yes ☐ No

☑ House/Mod. Home ☐ Mobile Home ☐ Business ☐ Other


No. Bedrooms 4 No. Persons No. Employees

Water Supply: ☐ Individual ☑ Public ☐ Community

☐ Slab ☑ Crawl Space ☐ Basement w/plumbing ☐ Basement wo/plumbing

Comments/Conditions: Sleeve supply line under drive - Install on Contour Maintain all setbacks

INITIAL SITE SKETCH

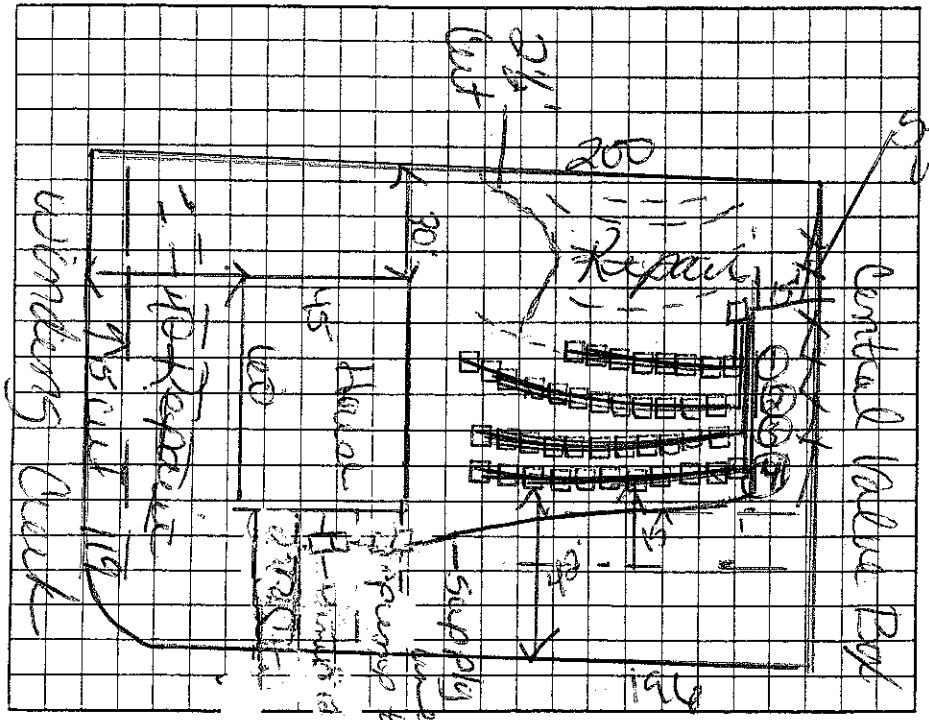


Comments/Conditions:


(1) 50' Back fill for possible Drainage

(2) 75'

(3) 70'

(4) 72'

AS BUILT SKETCH

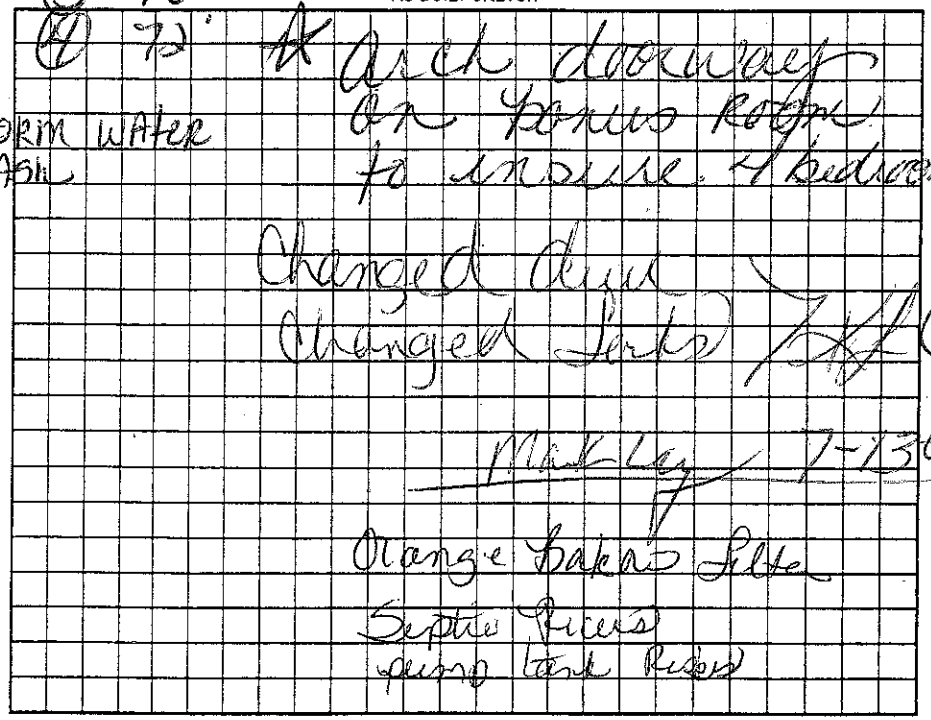


Permit can be suspended or revoked if any false information is supplied toward securing the permit/any unauthorized changes are made to the site/any unauthorized changes are made in the installation of the system. Improvement Permit with plat valid without expiration ☐ Improvement Permit with site plan valid for sixty months ☐ Authorization to Construct is valid for a period equal to that of Improvement Permit - not to exceed sixty months.

Signed: Mark & Kay date 1-8-07

Improvement Permit by: Reed Cook date 1-5-07

Authorization to Construct by: Reed Cook date 1-5-07

Installed by: Wayne Clontz

Operation Permit by: Reed Cook date 9-20-07

Existing System Inspection by: date

HEALTH DEPT. COPY: WHITE OWNER COPY (FINAL): YELLOW OWNER COPY (INITIAL): PINK