(CI)

IREDELL COUNTY HEALTH DEPARTMENT

STATESVILLE 704-878-5305 MOORESVILLE 704-664-5281

IMPROVEMENT PERMIT / AUTHORIZATION TO CONSTRUCT / OPERATION PERMIT / EXISTING SYSTEM INSPECTIO

PERMIT# 139660 PIN# 4730469173 DATE 1-5-07

OWNER OR APPLICANT S E L Homes Inc PHONE: Business 704-662-8467 Home

ADDRESS 110 Charleston Drive Suite Mooresville NC 28117

LOCATION State Park RD (L) winding Twin Creeks (L) winding Creek go to lot on left

SUBDIVISION Twin Creeks BLOCK / SECTION LOT 29 LOT AREA .57 SITE CLASS. PS DESIGN FLOW 480 L.T.A.R. .3

Septic Tank: 1000 Gallons; STB 1007 Date 3-9-07
Pump Tank: 1000 Gallons; PT 274 Date 5-18-07
Pump Make: Zoeller Model N-152 Serial No.
Nitrification Field: No Fields Square Feet 1600 Linear Feet 267
No Lines 4 Trench Width Max Trench Bottom Depth Gravel Depth


☑ New System ☐ Repair ☐ Expansion System Type: I II III (IV) V VI
System Description: 50% Low Pres
Repair System Description: 50% Low Pres
Maintenance Agreement Required: ☑ Yes ☐ No
☐ Gravity ☐ Pressure

☑ House/Mod. Home ☐ Mobile Home ☐ Business ☐ Other
No. Bedrooms 4 No. Persons No. Employees
Water Supply ☐ Individual ☑ Public ☐ Community
☐ Slab ☑ Crawl Space ☐ Basement w/plumbing ☐ Basement wo/plumbing

Comments:/Conditions: Sleeve supply line under drive
Install on contour
Maintain all setbacks

Comments:/Conditions:
(1) 50' Back fill for
(2) 75' possible drainage.
(3) 70'
(4) 73'

INITIAL SITE SKETCH

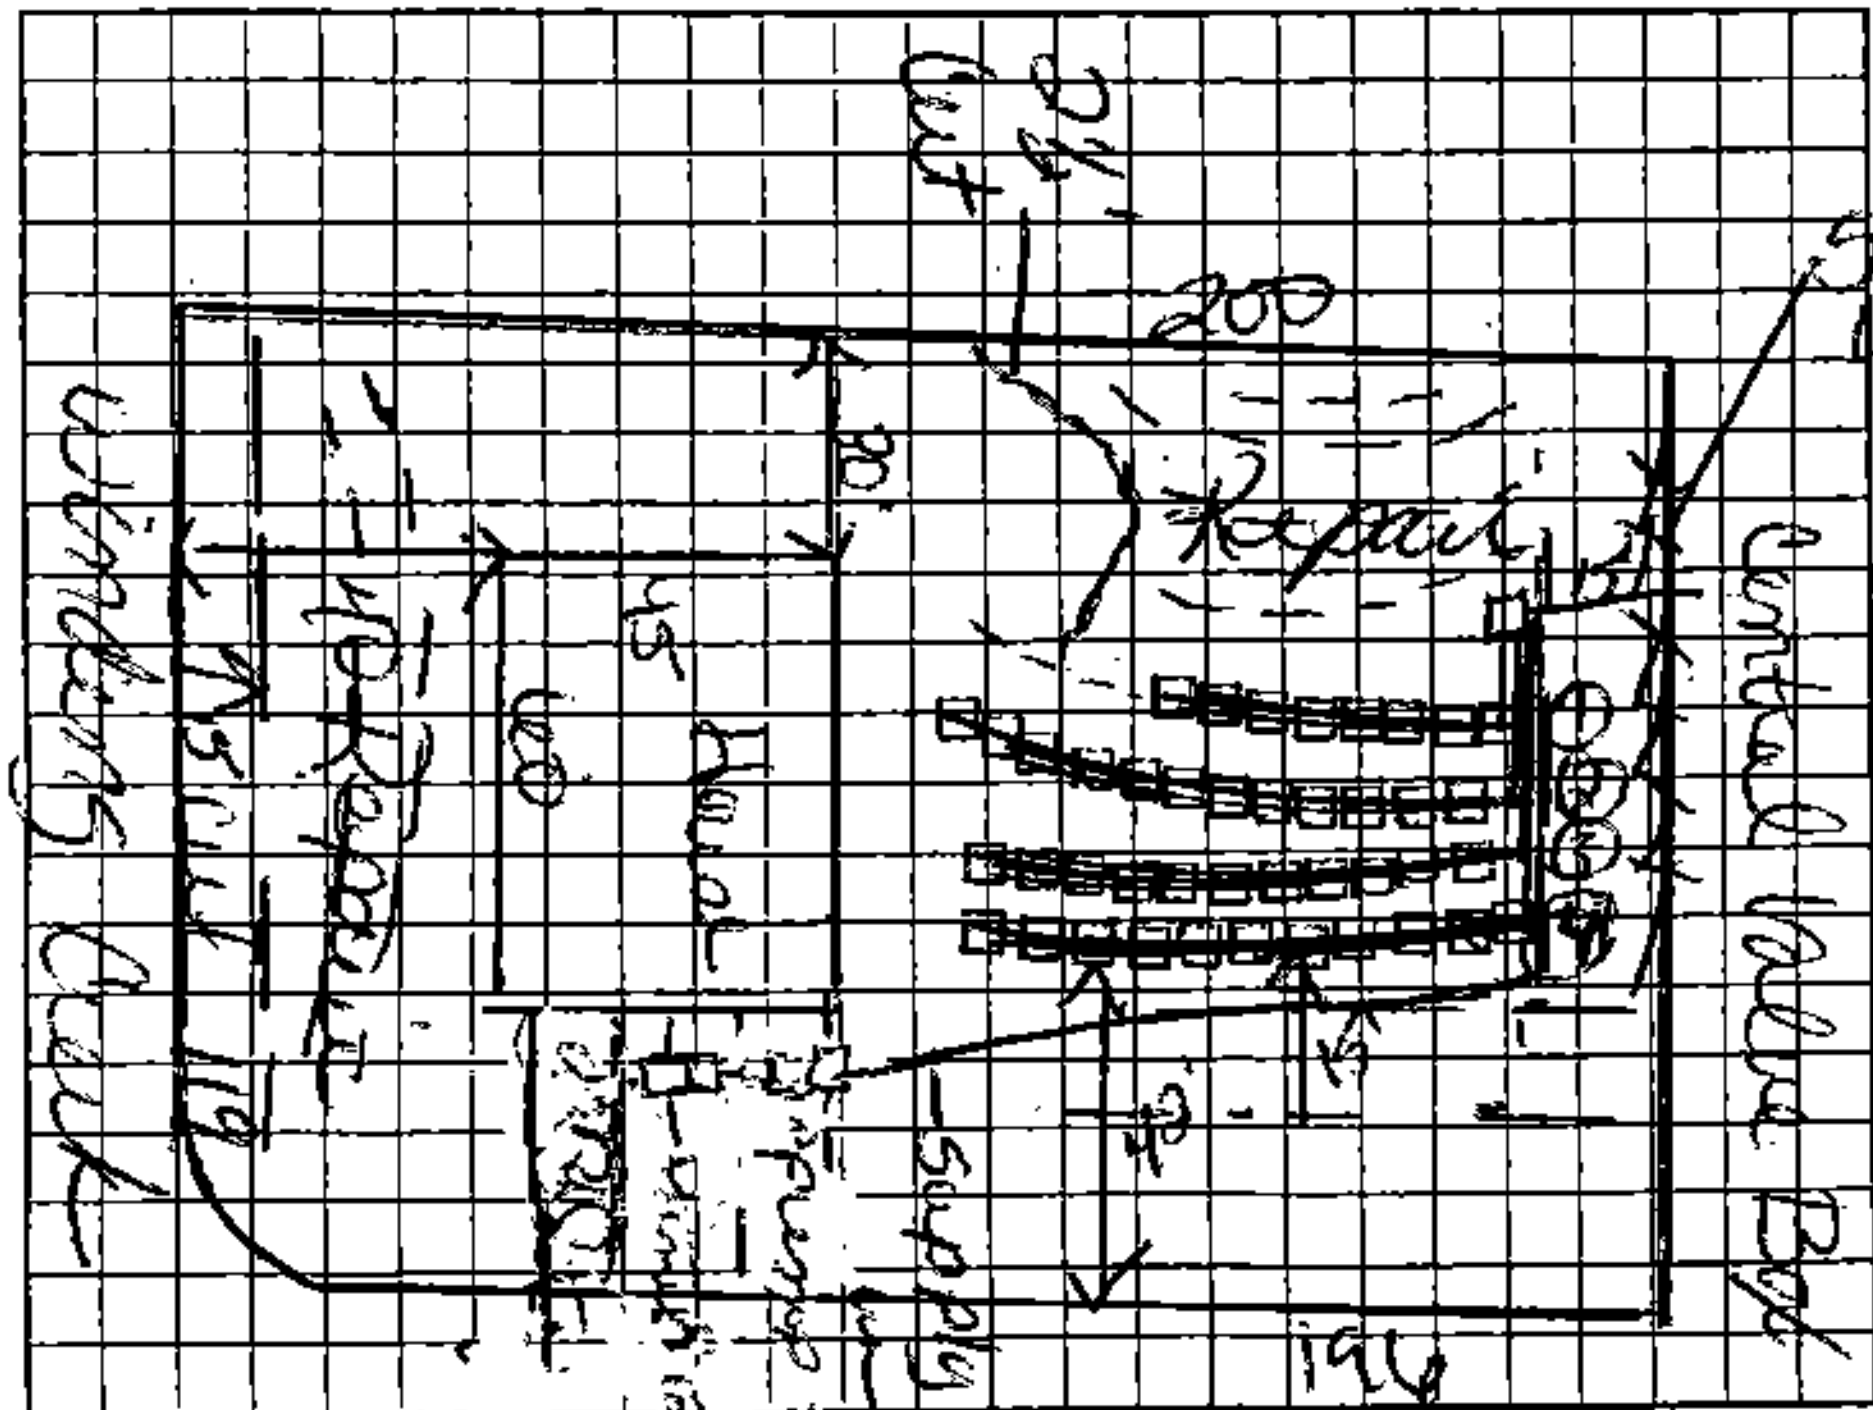

AS BUILT SKETCH

* Arch doorway on bonus room to insure 4 bdrm

Changed drive
Changed tanks

Mk Lay 7-?

Orange Lake Filter
Septic Risers
pump tank Risers

Permit can be suspended or revoked if any false information is supplied toward securing the permit/any unauthorized changes are made to the site/any unauthorized changes are made in the installation of the system. Improveme

Permit with plat valid without expiration ☐ Improvement Permit with site plan valid for sixty months ☐

Authorization to Construct is valid for a period equal to that of Improvement Permit – not to exceed sixty mont

Signed: Mark S. Lay date 1-8-07

Improvement Permit by: Keel Cook date 1-5-07

Authorization to Construct by: Keel Cook date 1-5-07

Installed by: Wayne Clontz

Operation Permit by: Keel Cook date 9-20-07

Existing System Inspection by: date

HEALTH DEPT. COPY: WHITE OWNER COPY (FINAL): YELLOW OWNER COPY (INITIAL): PINK