IREDELL COUNTY HEALTH DEPARTMENT

STATESVILLE 704-878-5305 (C1) MOORESVILLE 704-664-5281

IMPROVEMENT PERMIT / AUTHORIZATION TO CONSTRUCT / OPERATION PERMIT / EXISTING SYSTEM INSPECTION

PERMIT# 13731 PIN# 4736469227 DATE 5-23-06

OWNER OR APPLICANT Sherwood Homes PHONE: Business 704-799-8085 Home

ADDRESS 175 West Magaria Rd Mooresville NC 28117

LOCATION State Park Rd Twin Creeks (TC) Winding Creek Lot on left 5th

SUBDIVISION Twin Creeks BLOCK / SECTION LOT 6 LOT AREA .82 SITE CLASS PS DESIGN FLOW 360 L.T.A.R. 13

Septic Tank: 1000 Gallons; STB 1012 Date 5-23-06

Pump Tank: 1000 Gallons; PT 17 Date 7-7-06

Pump Make: Model Goulds Serial No WE05X12H

Nitrification Field: No Fields Square Feet 1200 Linear Feet 200

No Lines 3 Trench Width 24" Max Trench Bottom Depth 30 Gravel Depth

☐ New System ☐ Repair ☐ Expansion System Type: I II III IV V VI

System Description: Low Pres. Pump

Repair System Description: Low Pres. Pump

Maintenance Agreement Required: ☐ Yes ☐ No

☑ House/Mod. Home ☐ Mobile Home ☐ Business ☐ Other

No. Bedrooms 3 No. Persons No. Employees


Water Supply: ☐ Individual ☑ Public ☐ Community

☐ Gravity ☑ Pressure ☐ Slab ☐ Crawl Space ☐ Basement w/plumbing ☐ Basement wo/plumbing

Comments:/Conditions:

Maintain all setbacks
Install on Contour
15' away from pool


INITIAL SITE SKETCH

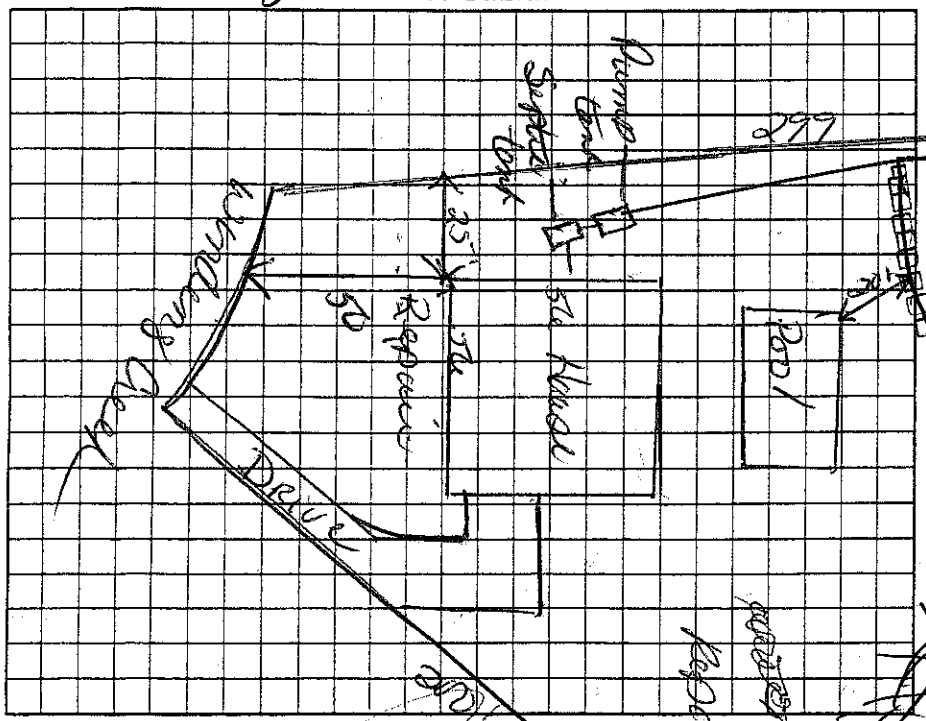

Comments:/Conditions:

3 @ 70' - Central Valve Box
② Fill in Gully - maintain 5' setback off edge
③ Shave Foam Terrace

AS BUILT SKETCH

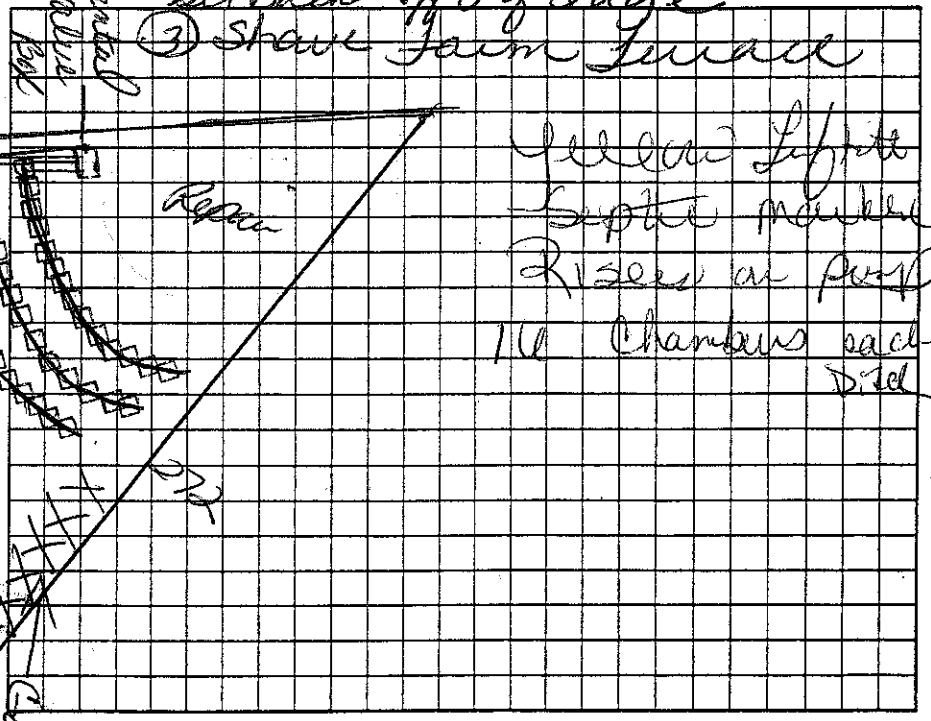

Permit can be suspended or revoked if any false information is supplied toward securing the permit/any unauthorized changes are made to the site/any unauthorized changes are made in the installation of the system. Improvement Permit with plat valid without expiration ☐ Improvement Permit with site plan valid for sixty months ☐ Authorization to Construct is valid for a period equal to that of Improvement Permit – not to exceed sixty months.

Signed: date 5/24/06 Installed by: Steve Jordan

Improvement Permit by: Kelly Cook date 5-23-06 Operation Permit by: Kelly Cook date 3-7-07

Authorization to Construct by: Kelly Cook date 5-23-06 Existing System Inspection by: date

HEALTH DEPT. COPY: WHITE OWNER COPY (FINAL): YELLOW OWNER COPY (INITIAL): PINK