Paid 300.00

IREDELL COUNTY HEALTH DEPARTMENT

STATESVILLE 704-878-5305 MOORESVILLE 704-664-5281

IMPROVEMENT PERMIT / AUTHORIZATION TO CONSTRUCT / OPERATION PERMIT / EXISTING SYSTEM INSPEC

PERMIT# -2- TROUTMAN PIN# 4730 48 6343 DATE 11/22/99

OWNER OR CONTRACTOR C & S ASSOCIATES PHONE: Business 202-4971 Home

ADDRESS 4474 LAKE DR. SHERRILLS FORD, NC 28673

LOCATION PERTHRO (S) - TR STATE PARK - TR MEADOW FALL LN - OFF RT

SUBDIVISION MEADOW GLEN BLOCK / SECTION LOT 3 LOT AREA .58 30 AC SITE CLASS RS DESIGN FLOW 360 L.T.A.R. .3

Septic Tank: 1000 Gallons; STB 823 Date 4/2/00
Pump Tank: Gallons; PT Date
Pump Make: Model Serial No.
Nitrification Field: No Fields 1 Square Feet 900 Linear Feet 300
No Lines @ 75' Trench Width 36" Max Trench Bottom Depth 36" Gravel Depth N/A

☑ New System ☐ Repair System Type: I. II (III) IV. V. VI
System Description: GRAVITY 25% REDUCTION
Repair System Description: SAME
Maintenance Agreement Required: ☐ Yes ☑ No


☑ House/Mod. Home No. Bedrooms 3
☐ Mobile Home No. Bathrooms 2
☐ Business No. Employees
☐ Other
☑ Slab ☐ Crawl Space ☐ Basement w/plumbing ☐ Basement wo/plumbing

Water Supply: ☐ Individual ☑ Public ☐ Community TROUTMAN


Comments/Conditions:

Comments/Conditions

INITIAL SITE SKETCH 1" = 50'

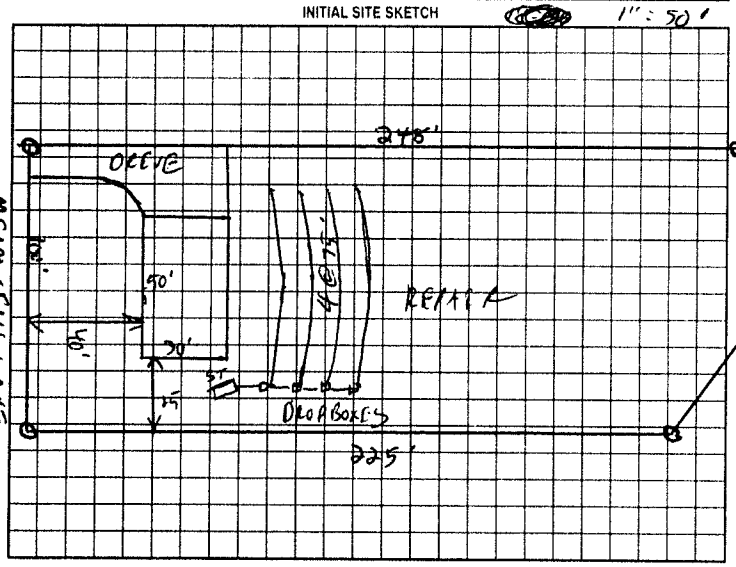

AS BUILT SKETCH

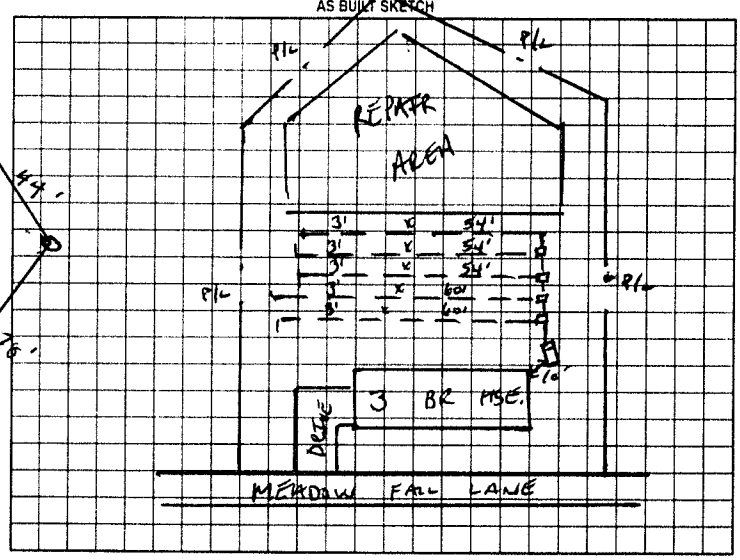

Permit can be suspended or revoked if any false information is supplied toward securing the permit/any unauthorized changes are made to the site/any unauthorized changes are made in the installation of the system. Improvement Permit with plat valid without expiration. Improvement Permit with site plan valid for sixty months. Authorization to Construct is valid for a period equal to that of Improvement Permit -- not to exceed sixty months.

Signed: date 5-9-01 Installed by: ROWAN SEPTIC

Improvement Permit by: KS date 11/22/99 Operation Permit by: date 4/23/01

Authorization to Construct by: KS date 11/22/99 Existing System Inspection by: date

HEALTH DEPT COPY WHITE OWNER COPY (FINAL) YELLOW OWNER COPY (INITIAL) PINK