79168

IREDELL COUNTY HEALTH DEPARTMENT

THIS PERMIT VOIDS PREVIOUS ISSUED 11-21-98

STATESVILLE 704-878-5305 MOORESVILLE 704-664-5281

IMPROVEMENT PERMIT / AUTHORIZATION TO CONSTRUCT / OPERATION PERMIT / EXISTING SYSTEM INSPECTION

PERMIT# 07-7-0998 PIN# 4730 48 6343 DATE 1-30-99

OWNER OR CONTRACTOR C & S ASSOCIATES, LLC PHONE: Business (336) 475-4111 Home

ADDRESS 904 SALEM STREET, THOMASVILLE, NC 27360

LOCATION US 21 S. TR PORTH ROAD, TR STATE PARK ROAD, 2ND LOT ON RIGHT

SUBDIVISION MEADOW GLEN BLOCK / SECTION I LOT 16 LOT AREA 15,000 SF SITE CLASS PS DESIGN FLOW 360 L.T.A.R. 0.25 GPD/FT²

Septic Tank: 1000 Gallons; STB 826 Date 2-14-99

Pump Tank: 1000 Gallons; PT 47 Date 2-14-99

Pump Make: Zoller Model N137 Serial No

Nitrification Field: No Fields 1 Square Feet Eq. To 1440 Linear Feet 240

No Lines EIGHT Trench Width 24" Max Trench Bottom Depth 36" Gravel Depth SAND 6"

☑ New System Repair System Type: I II (III) IV V VI

System Description: PPBPS, pump-fed

Repair System Description: PPBP's, pump-fed

Maintenance Agreement Required: Yes ☐ No ☑

☑ House/Mod. Home ☐ Mobile Home ☐ Business ☐ Other

No. Bedrooms 3 No. Bathrooms 2 No. Employees


Slab ☑ Crawl Space Basement w/plumbing Basement wo/plumbing

Water Supply: ☐ Individual ☑ Public ☐ Community

Comments/Conditions: ① INSTALL FIFTY-SIX (56) PPBPS PANELS ② SEE ATTACHED SHEETS FOR PUMP AND PRESSURE MANIFOLD REQUIREMENTS

Comments/Conditions: Checked drainfield set pressure head 3-17-99 Tanks

INITIAL SITE SKETCH SCALE: 1" = 30'

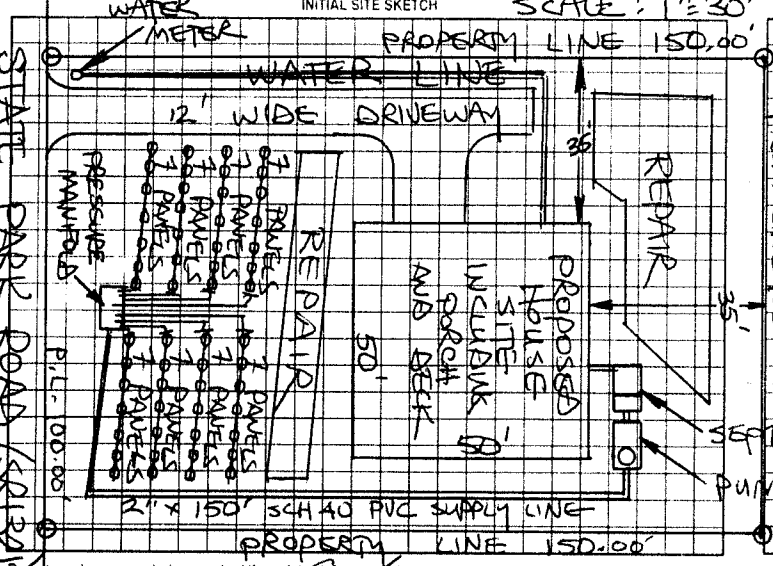

AS BUILT SKETCH

Installed as shown

Permit can be suspended or revoked if any false information is supplied toward securing the permit; any unauthorized changes are made to the site; any unauthorized changes are made in the installation of the system. Improvement Permit with plat valid without expiration. Improvement Permit with site plan valid for sixty months. Authorization to Construct is valid for a period equal to that of Improvement Permit – not to exceed sixty months.

Signed: _____ date 2-25-99 Installed by: Rowan Septic

Improvement Permit by: STEVE HEDRICK date 1-30-99 Operation Permit by: [illegible] date 3-23-99

Authorization to Construct by: STEVE HEDRICK date 1-30-99 Existing System Inspection by: _____ date _____

HEALTH DEPT COPY WHITE OWNER COPY (FINAL) YELLOW OWNER COPY (INITIAL) PINK