~~79501~~ 92232 THIS PERMIT VOIDS PREVIOUS ISSUED 1.23.99

IREDELL COUNTY HEALTH DEPARTMENT

STATESVILLE 704-878-5305 MOORESVILLE 704-664-5281

IMPROVEMENT PERMIT / AUTHORIZATION TO CONSTRUCT / OPERATION PERMIT / EXISTING SYSTEM INSPECTION

PERMIT# 07-Z-1098 PIN# 4730 48 6343 (PT) DATE 6-3-99

OWNER OR CONTRACTOR C & S ASSOCIATES, LLC PHONE: Business (336) 475-4111 Home

ADDRESS 904 SALEM STREET, THOMASVILLE NC 27360

LOCATION US 21 S, TR PERTH ROAD, TR STATE PARK ROAD, 1ST LOT ON RIGHT

SUBDIVISION MEADOW GLEN BLOCK / SECTION I LOT 17 LOT AREA 0.3838 ACRE SITE CLASS. PS DESIGN FLOW 360 L.T.A.R. 0.25 GPD/FT2

Septic Tank: 1000 Gallons; STB 312 Date 1-1-01
Pump Tank: ___ Gallons; PT ___ Date ___
Pump Make: ___ Model ___ Serial No. ___
Nitrification Field: No Fields 1 Square Feet 120 TO 140 Linear Feet 240
No Lines EIGHT Trench Width 24" Max Trench Bottom Depth 36"

☑ New System ☐ Repair System Type: I, II, III, IV, V, VI
System Description: PPBPS GRAVITY
Repair System Description: PPBPS LOW PRESS.
Maintenance Agreement Required: ☐ Yes ☑ No

~~Gravel~~ Depth SAND 6" ☐ Slab ☑ Crawl Space ☐ Basement w/plumbing ☐ Basement wo/plumbing


☑ House/Mod. Home No. Bedrooms 3
☐ Mobile Home No. Bathrooms 2
☐ Business No. Employees ___
☐ Other ___

Water Supply: ☐ Individual ☑ Public ☐ Community


Comments/Conditions: INSTALL FIFTY-SIX (56) PPBPS PANELS IN EIGHT (8) EQUAL LENGTH LINES ON CONTOUR AS SHOWN

Comments/Conditions (1) PUMP SEPTIC TANK EVERY 3 5 YRS.

INITIAL SITE SKETCH

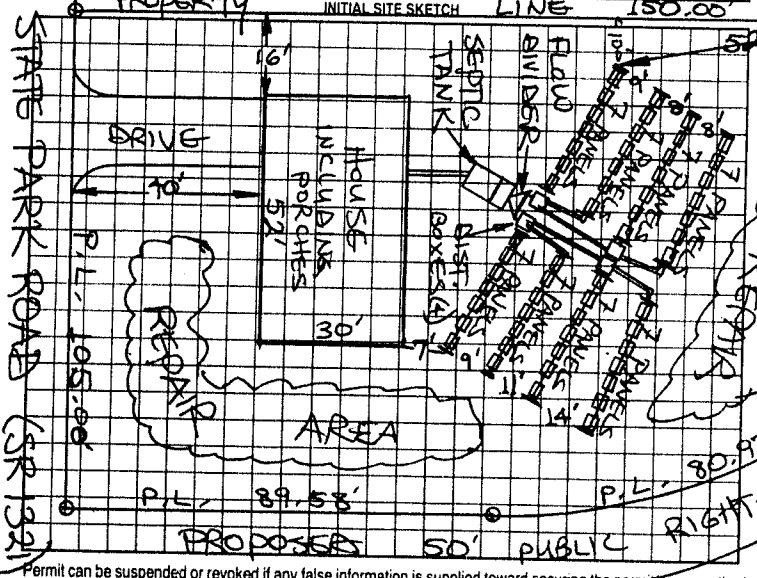

AS BUILT SKETCH

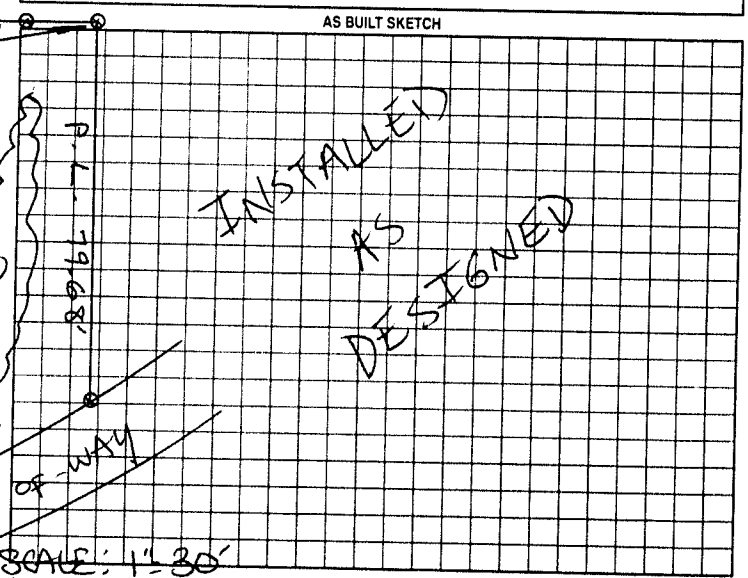

Permit can be suspended or revoked if any false information is supplied toward securing the permit/any unauthorized changes are made to the site/any unauthorized changes are made in the installation of the system. Improvement Permit with plat valid without expiration. Improvement Permit with site plan valid for sixty months. Authorization to Construct is valid for a period equal to that of Improvement Permit – not to exceed sixty months.

Signed: Ginger Cecil date 7/27/99

Improvement Permit by: STEVE HEDRICK date 6-3-99

Authorization to Construct by: STEVE HEDRICK date 6-3-99

Installed by: TOMMY FLYE

Operation Permit by: Tracy Shinn date 4/19/01

Existing System Inspection by: ___ date ___

HEALTH DEPT COPY WHITE OWNER COPY (FINAL) YELLOW OWNER COPY (INITIAL) PINK