IREDELL COUNTY HEALTH DEPARTMENT

STATESVILLE 704-878-5305 MOORESVILLE 704-664-5281

IMPROVEMENT PERMIT / AUTHORIZATION TO CONSTRUCT / OPERATION PERMIT / EXISTING SYSTEM INSPECTION

PERMIT# TROUTMAN (176761) PIN# 4731-48-8453 4730477838 DATE 5-20-05

OWNER OR CONTRACTOR C & S ASSOCIATES, LLC PHONE: Business (704) 932-6195 Home

ADDRESS 108 WESTFIELD PLAZA MOORESVILLE NC 28115

LOCATION US 21S TR PERTH TR STATE PARK TR MEADOW GLEN TL SHENANDOAH LOT AT CORNER OF PARK VISTA

SUBDIVISION MEADOW GLEN BLOCK / SECTION LOT 45 LOT AREA 0.3745 SITE CLASS. PS DESIGN FLOW 360 L.T.A.R. 0.30 GPD/FT²

Septic Tank: 1000 Gallons; STB 825 Date 2-4-13

Pump Tank: 1000 Gallons; PT 307 Date 1-6-13

Pump Make: Zoeller Model N152 Serial No.

Nitrification Field: No Fields 1 Square Feet 1200 Linear Feet 300

No Lines FOUR Trench Width 36" Max Trench Bottom Depth 36" Gravel Depth N/A

☑ New System ☐ Repair System Type: I, II, (III), IV, V, VI

System Description: PUMP 25% REDUCTION

Repair System Description: LP PPBPS 50% REDUCTION

Maintenance Agreement Required: ☐ Yes ☑ No

☑ House/Mod. Home No. Bedrooms 3

☐ Mobile Home No. Bathrooms

☐ Business No. Employees

☐ Other

☐ Slab ☑ Crawl Space ☐ Basement w/plumbing ☐ Basement wo/plumbing


Water Supply: ☐ Individual ☑ Public ☐ Community

Comments:/Conditions: ① INSTALL SYSTEM ON CONTOUR


② MAINTAIN SETBACKS

Comments:/Conditions:

INITIAL SITE SKETCH

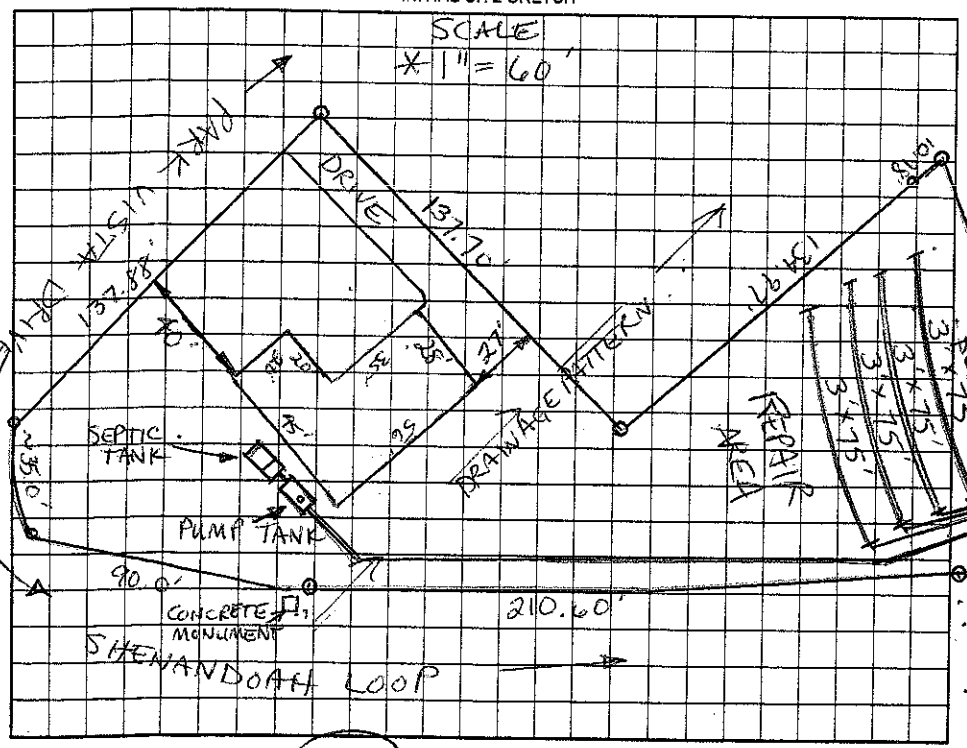

AS BUILT SKETCH

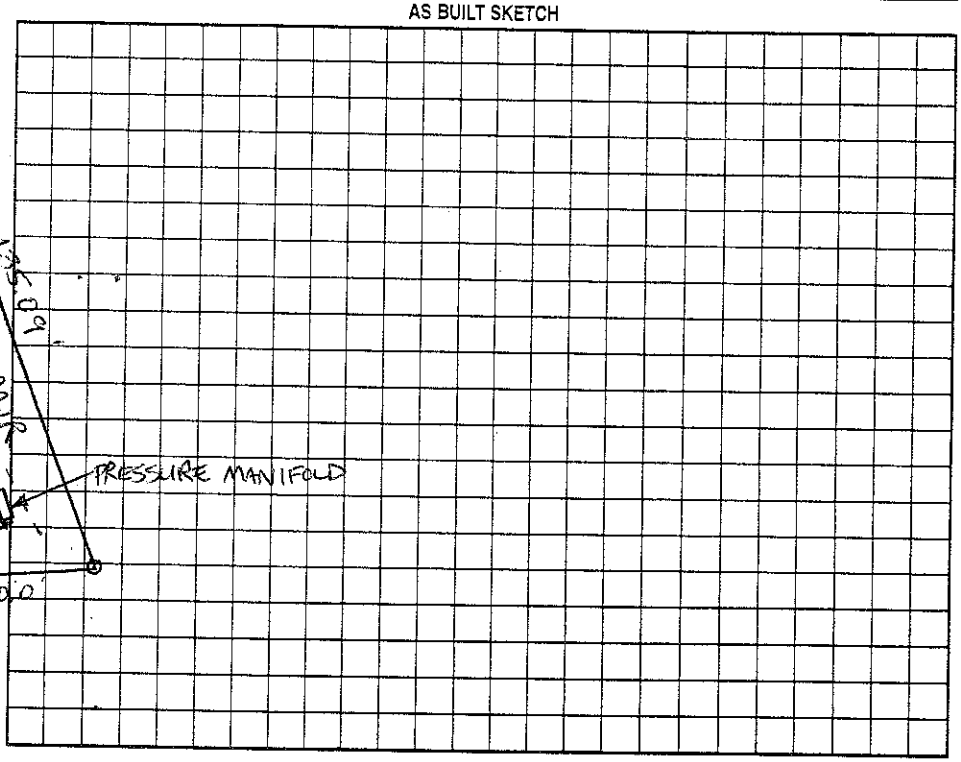

Permit can be suspended or revoked if any false information is supplied toward securing the permit/any unauthorized changes are made to the site/any unauthorized changes are made in the installation of the system. Improvement Permit with plat valid without expiration. Improvement Permit with site plan valid for sixty months. Authorization to Construct is valid for a period equal to that of Improvement Permit – not to exceed sixty months.

Signed: date

Improvement Permit by: Christopher M. Sherrill, RS, LSS date 5-20-05

Authorization to Construct by: Christopher M. Sherrill, RS, LSS date 5-20-05

Installed by: Rowan Septic

Operation Permit by: date 4-23-13

Existing System Inspection by: date

HEALTH DEPT. COPY: WHITE 1-22-13 OWNER COPY (FINAL): YELLOW OWNER COPY (INITIAL): PINK