THIS PERMIT VOIDS PREVIOUS ISSUED 4-15-00

IREDELL COUNTY HEALTH DEPARTMENT

STATESVILLE 704-878-5305 MOORESVILLE 704-664-5281

IMPROVEMENT PERMIT / AUTHORIZATION TO CONSTRUCT / OPERATION PERMIT / EXISTING SYSTEM INSPECTION

PERMIT# 108961 PIN# 4730-47-8570 DATE 12-20-02

OWNER OR CONTRACTOR C & S ASSOCIATES, LLC PHONE: Business 336-475-4111 Home 202-4971/876-6162

ADDRESS 904 SALEM STREET, THOMASVILLE, NC 27360

LOCATION US 21 SOUTH, TR PERTH ROAD, TR STATE PARK ROAD 8TH LOT ON RIGHT

SUBDIVISION MEADOW GLEN BLOCK / SECTION I LOT 19 LOT AREA 0.4402 ACRES SITE CLASS. PS DESIGN FLOW 360 L.T.A.R. 0.25 GPD/FT²

Septic Tank: 1000 Gallons; STB 825 Date 01/28/03
Pump Tank: ____ Gallons; PT ____ Date ____
Pump Make: ____ Model ____ Serial No. ____
Nitrification Field: No Fields 1 Square Feet ~~EQ. TO~~ 1440 Linear Feet 240
No Lines SIX Trench Width 24" Max Trench Bottom Depth 36" ~~Gravel~~ Depth 6" SAND

☑ New System ☐ Repair System Type: I, II, III, IV, V, VI
System Description: 50% REDUCTION, GRAVITY
Repair System Description: 50% REDUCTION, GRAVITY
Maintenance Agreement Required: ☐ Yes ☐ No LOW-PRESS ~~LEED~~ Other

☑ House/Mod. Home No. Bedrooms 3
☐ Mobile Home No. Bathrooms 2
☐ Business No. Employees ____
☐ Slab ☐ Crawl Space ☐ Basement w/plumbing ☐ Basement wo/plumbing


Water Supply: ☐ Individual ☑ Public ☐ Community

Comments/Conditions: INSTALL 50% REDUCTION SYSTEM USING FIFTY-FOUR (54) PPBPS PANELS IN SIX EQUAL LENGTH LINES AS SHOWN

Comments/Conditions:

* POLY-LOC FILTER USED

INITIAL SITE SKETCH SCALE: 1"=40'

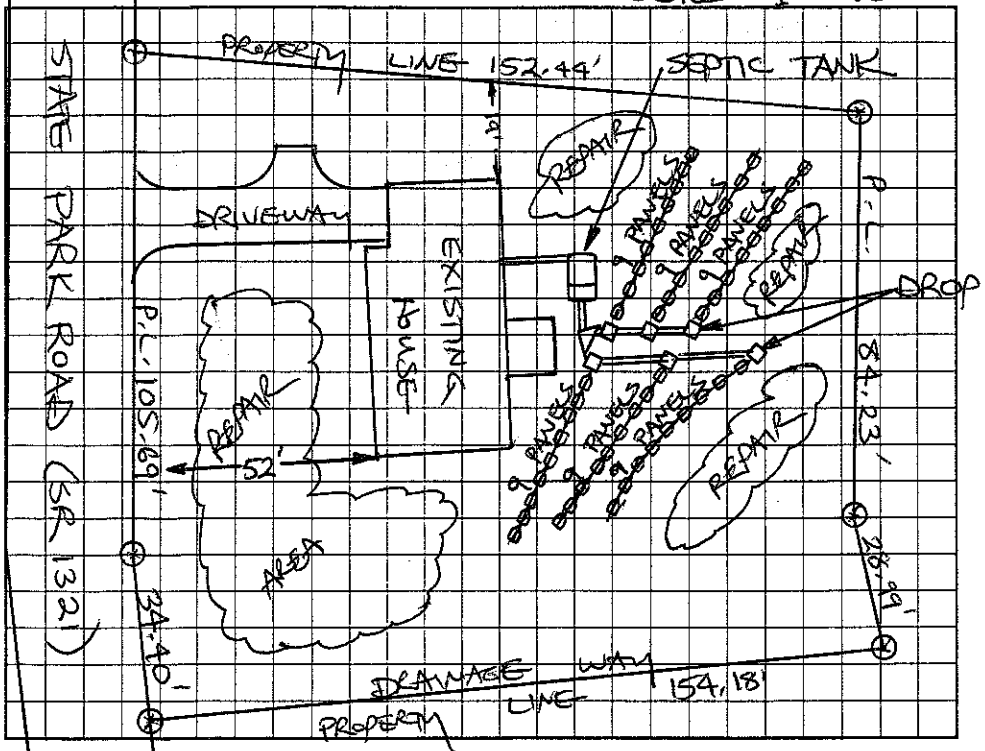

AS BUILT SKETCH

* SYSTEM INSTALLED AS SHOWN IN INITIAL SITE SKETCH.

Permit can be suspended or revoked if any false information is supplied toward securing the permit/any unauthorized changes are made to the site/any unauthorized changes are made in the installation of the system. Improvement Permit with plat valid without expiration. Improvement Permit with site plan valid for sixty months. Authorization to Construct is valid for a period equal to that of Improvement Permit – not to exceed sixty months.

Signed: _____ date 12/30/02 Installed by: ROWAN SEPTIC

Improvement Permit by: STEVE HEDRICK date 12-20-02 Operation Permit by: Patrick Mitchell date 08/06/03

Authorization to Construct by: STEVE HEDRICK date 12-20-02 Existing System Inspection by: _____ date _____

HEALTH DEPT. COPY: WHITE OWNER COPY (FINAL): YELLOW OWNER COPY (INITIAL): PINK