IREDELL COUNTY HEALTH DEPARTMENT

STATESVILLE 704-878-5305 MOORESVILLE 704-664-5281

IMPROVEMENT PERMIT / AUTHORIZATION TO CONSTRUCT / OPERATION PERMIT / EXISTING SYSTEM INSPECTION

PERMIT# 23-7-699 PIN# 4730486413 DATE 8/5/99

OWNER OR CONTRACTOR Max Spear PHONE: Business (704) 361-7518 Home

ADDRESS 607 Anderson Ave Salisbury NC 28144

LOCATION State Park Rd from Perth Rd TR onto Meadow Glen Dr TL Meadow Glen Circle

SUBDIVISION Meadow Glen BLOCK / SECTION LOT 36 LOT AREA .4205 Acre SITE CLASS PS DESIGN FLOW 360 gpd L.T.A.R. .3

Septic Tank: 1000 Gallons: STB 825 Date 8-5-99

Pump Tank: 1600 Gallons: PT 502 Date

Pump Make: Zoeller Model Serial No.

Nitrification Field: No Fields 1 Square Feet 900' Linear Feet 300'

No Lines 5 or 6 Trench Width 36" Max Trench Bottom Depth 36" Gravel Depth N/A

X New System ☐ Repair System Type: I, II, (III), V, V, VI

System Description: Pump (pm) - 25% Reductia

Repair System Description: Pump - Panel Block

Maintenance Agreement Required: ☐ Yes X No

X Slab ☐ Crawl Space ☐ Basement w/plumbing ☐ Basement wo/plumbing

X House/Mod. Home ☐ Mobile Home ☐ Business ☐ Other

No. Bedrooms 3 No. Bathrooms 2 No. Employees

Water Supply: ☐ Individual X Public ☐ Community


Comments/Conditions: Keep Septic System at least 5' from House & 10' from PL.

Comments/Conditions 10-7 Line Install As Shown Tank & P.Tank ok


10-8: Pressure Checked & Set

10-13 Wiring & Alarm Check & ok

INITIAL SITE SKETCH Scale 1:50

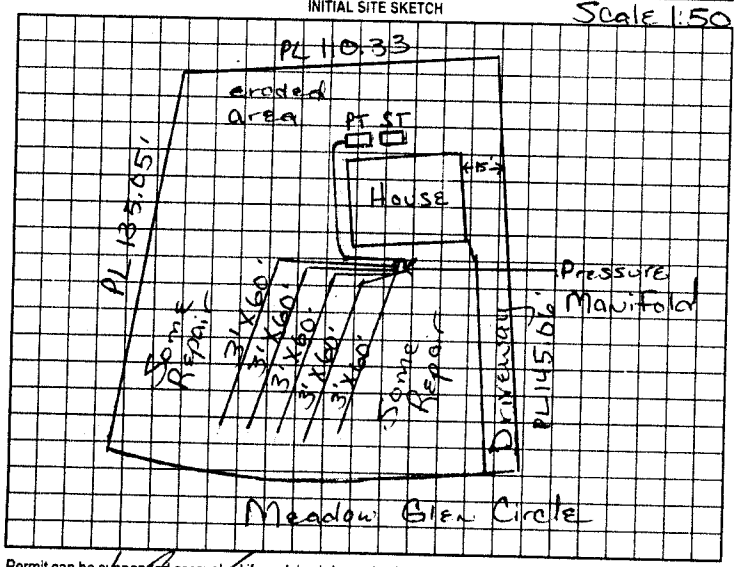

AS BUILT SKETCH

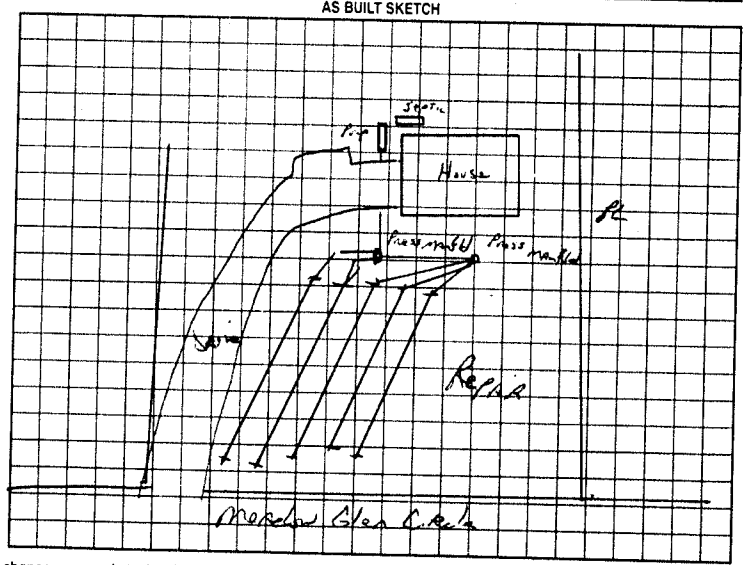

Permit can be suspended or revoked if any false information is supplied toward securing the permit/any unauthorized changes are made to the site/any unauthorized changes are made in the installation of the system. Improvement Permit with plat valid without expiration. Improvement Permit with site plan valid for sixty months. Authorization to Construct is valid for a period equal to that of Improvement Permit - not to exceed sixty months.

Signed: date 8-6-99

Improvement Permit by: Marcia H.H. Dotson date 8/6/99

Authorization to Construct by: Marcia H.H. Dotson date 8/6/99

Installed by: Lowe's Septic

Operation Permit by: C Potter date Oct 13 99

Existing System Inspection by: date

HEALTH DEPT. COPY: WHITE OWNER COPY (FINAL) YELLOW OWNER COPY (INITIAL) PINK