$330

IREDELL COUNTY HEALTH DEPARTMENT

STATESVILLE 704-878-5305 MOORESVILLE 704-664-5281

IMPROVEMENT PERMIT / AUTHORIZATION TO CONSTRUCT / OPERATION PERMIT / EXISTING SYSTEM INSPECTION

PERMIT# ~~06307~~ Troutman PIN# 4730-48-6343 DATE March 13, 02

OWNER OR CONTRACTOR C&S Associates PHONE Business Home

ADDRESS 4474 Lake Dr. Sherrills Ford N.C. 28673

LOCATION State Park Rd. TR into Meadowglen to end Bear left on Shenandoah on to ft

SUBDIVISION Meadow Glen BLOCK / SECTION 4 LOT 87 LOT AREA .3854 Ac SITE CLASS PS pm.192 DESIGN FLOW 360gpd L T A R. .3

Septic Tank: 1,000 Gallons. STB 825 Date 06/24/02
Pump Tank: 1,000 Gallons. PT 302 Date 05/27/02
Pump Make: ZOELER Model N-98 Serial No
Nitrification Field: No Fields 1 Square Feet 400 Linear Feet 200
No Lines 4@50' Trench Width 24" 8'oc Max Trench Bottom Depth 36"

~~New System~~ Repair System Type I. II (III) IV. V. VI
System Description gm - PPBPS
Repair System Description: LPPPBPS
Maintenance Agreement Required: Yes ~~No~~ Initially
Gravel Depth N/A Slab ~~Crawl Space~~ Basement w/plumbing Basement w/o plumbing


~~House/Mod Home~~ No Bedrooms 3
Mobile Home No Bathrooms 2
Business No Employees
Other

Water Supply: ☐ Individual ~~Public~~ ☐ Community


Comments /Conditions: Do not cut house site & Back fill As Needed Against foundation to provide positive drainage

Comments /Conditions SEPTIC TANK INSTALLED USING POLY-LOK FILTER + marker. SYSTEM INSTALLED AS SHOWN BELOW IN "AS BUILT SKETCH".

1"=50' INITIAL SITE SKETCH

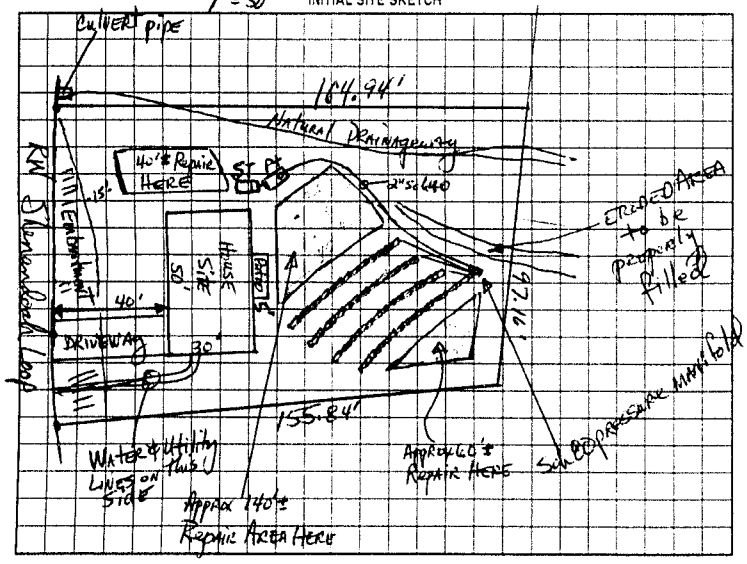

AS BUILT SKETCH

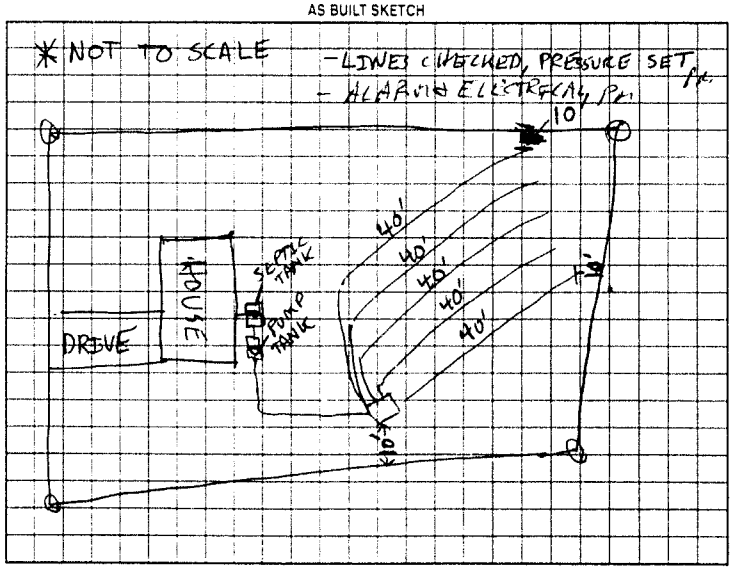

Permit can be suspended or revoked if any false information is supplied toward securing the permit any unauthorized changes are made to the site any unauthorized changes are made in the installation of the system. Improvement Permit with plat valid without expiration. Improvement Permit with site plan valid for sixty months. Authorization to Construct is valid for a period equal to that of Improvement Permit - not to exceed sixty months

Signed: LaVern Henry date 4-16-02 Installed by: ROWAN SEPTIC

Improvement Permit by: [signature] date 3-13-02 Operation Permit by: Patrick Mitchell date 08/15/02 08/26/02 PM

Authorization to Construct by: [signature] date 4/29/02 Existing System Inspection by: date

HEALTH DEPT COPY WHITE OWNER COPY (FINAL) YELLOW OWNER COPY (INITIAL) PINK