106308

IREDELL COUNTY HEALTH DEPARTMENT

#330

STATESVILLE 704-878-5305 MOORESVILLE 704-664-5281

IMPROVEMENT PERMIT / AUTHORIZATION TO CONSTRUCT / OPERATION PERMIT / EXISTING SYSTEM INSPECTION

PERMIT# Z - Troutman PIN# 4730-48-6343 DATE March 13, 02

OWNER OR CONTRACTOR C&S Associates PHONE Business Home

ADDRESS 4474 Lake Dr. Sherrills Ford NC 28673

LOCATION State Park Rd TR into Meadow Glen to end Back left on Shenandoah Loop - 2nd lot left

SUBDIVISION Meadow Glen BLOCK / SECTION LOT 86 LOT AREA .7651 Ac SITE CLASS PS DESIGN FLOW 360 gpd L T A R .025

Septic Tank: 1000 Gallons: STB 225 Date 06/27/02
Pump Tank: 1000 Gallons: PT 302 Date 06/21/02
Pump Make: Zoeller Model N1-37 Serial No
Nitrification Field: No Fields 1 Square Feet 1080 Linear Feet 360
No Lines 4 @ 90' Trench Width 36" Max Trench Bottom Depth 36"

✓ New System Repair System Type I II (III) IV V VI
System Description pm- Innovative- 25% Reduction
Repair System Description LPPBPS
Maintenance Agreement Required: Yes ✓ No Initially
Gravel Depth NA Slab ✓ Crawl Space Basement w/plumbing Basement wo/plumbing

✓ House/Mod. Home No. Bedrooms 3
Mobile Home No. Bathrooms 2
Business No. Employees
Other

Water Supply: ☐ Individual ☒ Public ☐ Community


Comments/Conditions: Do not cut around house site. Backfill as needed against foundation to provide positive drainage.

House 48x30' 4/27/02 cop

Comments/Conditions: - SEPTIC TANK INSTALLED USING POLY-LOC FILTER & Marker.

INITIAL SITE SKETCH

1" = 50'

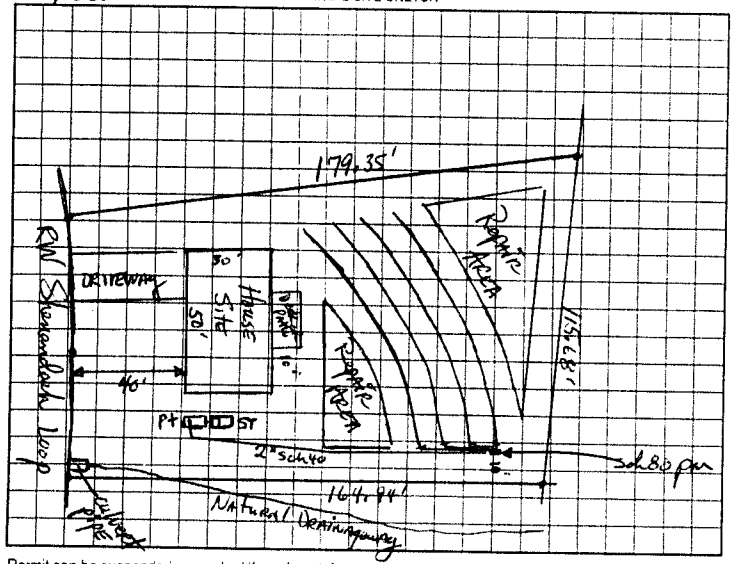

AS BUILT SKETCH

- LINES CHECKED & PRESSURE SET 6/21
- ALARM & ELECTRICAL ✓ pm

SYSTEM INSTALLED AS SHOWN IN INITIAL SITE SKETCH

Permit can be suspended or revoked if any false information is supplied toward securing the permit/any unauthorized changes are made to the site any unauthorized changes are made in the installation of the system. Improvement Permit with plat valid without expiration. Improvement Permit with site plan valid for sixty months. Authorization to Construct is valid for a period equal to that of Improvement Permit - not to exceed sixty months

Signed: date 4-16-02 Installed by ROWAN SEPTIC

Improvement Permit by: date 3-13-02 Operation Permit by date 06/29/02 PM

Authorization to Construct by: date 4/29/02 Existing System Inspection by date

HEALTH DEPT. COPY WHITE OWNER COPY (FINAL) YELLOW OWNER COPY (INITIAL) PINK