95345

IREDELL COUNTY HEALTH DEPARTMENT

STATESVILLE 704-878-5305 300.00 Paid MOORESVILLE 704-664-5281

IMPROVEMENT PERMIT / AUTHORIZATION TO CONSTRUCT / OPERATION PERMIT / EXISTING SYSTEM INSPECTION

PERMIT# 34-S-01O PIN# 4730-48-6343 DATE 4/27/01

OWNER OR CONTRACTOR C & S Associates PHONE: Business 202-4971 Home

ADDRESS 4474 Lake Dr. Sherrills Ford N.C. 28673

LOCATION State Park Rd. TR. into Meadow Glen TL Spring Lake Dr. on left

SUBDIVISION Meadow Glen BLOCK / SECTION 4 LOT 72 LOT AREA 1.407 ac SITE CLASS PS DESIGN FLOW 360 gpd L.T.A.R. .3

Septic Tank: 1000 Gallons; STB 1007 Date 3-28-01
Pump Tank: Gallons; PT Date
Pump Make: Model Serial No.
Nitrification Field: No Fields 1 Square Feet 900 Linear Feet 300
No Lines 4 Trench Width 36" Max Trench Bottom Depth 36" Gravel Depth N/A

☑ New System ☐ Repair System Type: I, II, III, IV, V, VI
System Description: Gravity Innovative - 25% Red
Repair System Description: LPP PBPS
Maintenance Agreement Required: ☐ Yes ☑ No initially
☐ Slab ☑ Crawl Space ☐ Basement w/plumbing ☐ Basement wo/plumbing

~~☐~~ House/Mod. Home No. Bedrooms 3
☐ Mobile Home No. Bathrooms 2
☐ Business No. Employees
☐ Other


Water Supply: ☐ Individual ☑ Public ☐ Community

Comments/Conditions:

Comments/Conditions: SEPTIC TANK W/ RISER AND MARKER INSTALLED USING "PolyLok" ALTE

1"=50'

PARTIAL SITE SKETCH

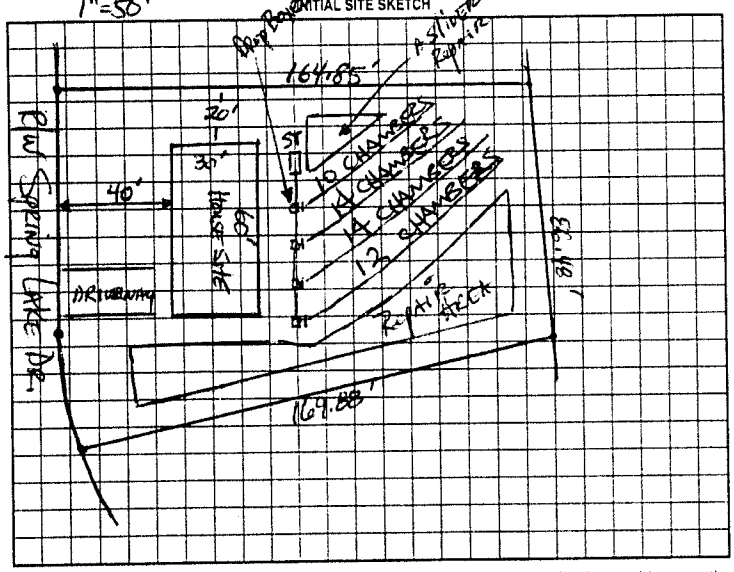

AS BUILT SKETCH

SYSTEM INSTALLED ACCORDING TO INITAL SITE SKETCH USING FIFTY (50) INFILTRATOR CHAMBERS. SYSTEM INSTALLED OUT OF CONTOUR (LOWER LINE) AND DURING PERIOD OF WET WEATHER.

Permit can be suspended or revoked if any false information is supplied toward securing the permit/any unauthorized changes are made to the site/any unauthorized changes are made in the installation of the system. Improvement Permit with plat valid without expiration. Improvement Permit with site plan valid for sixty months. Authorization to Construct is valid for a period equal to that of Improvement Permit – not to exceed sixty months.

Signed: Sanitarian Supervisor date 2-27-01
Improvement Permit by: Sanitarian date 2-27-01
Authorization to Construct by: Sanitarian date 3/14/01

Installed by: WAYNE CONTR
Operation Permit by: STEVE HEARICK date 5-18-01
Existing System Inspection by: date

HEALTH DEPT. COPY WHITE OWNER COPY (FINAL) YELLOW OWNER COPY (INITIAL) PINK