IREDELL COUNTY HEALTH DEPARTMENT

STATESVILLE 704-878-5305 300.00 Paid MOORESVILLE 704-664-5281

IMPROVEMENT PERMIT / AUTHORIZATION TO CONSTRUCT / OPERATION PERMIT / EXISTING SYSTEM INSPECTION

PERMIT# 06-2-0800 PIN# 4730-46-6343 DATE March 29, 01

OWNER OR CONTRACTOR C&S Associates PHONE: Business 202-4971 Home

ADDRESS 4474 Lake Dr. Statesville NC 28673

LOCATION State Park Rd TR 1106 Meadow Glen Ln Valley Glen Last lot on left

SUBDIVISION Meadow Glen BLOCK / SECTION 4 LOT 59 LOT AREA ±3.79 ac SITE CLASS B DESIGN FLOW 360gpd L.T.A.R. ±3

Septic Tank: 1000 Gallons; STB 825 Date 3-20-01
Pump Tank: Gallons; PT Date
Pump Make: Model Serial No.
Nitrification Field: No Fields 1 Square Feet 900 Linear Feet 300
No Lines 5@60' Trench Width 36" Max Trench Bottom Depth 36"

☑ New System ☐ Repair System Type: I, II, (III), IV, V, VI
System Description: Gravity Innovative - 25% Red.
Repair System Description: NLP Pipes
Maintenance Agreement Required: ☐ Yes ☑ No Initially
Gravel Depth N/A ☐ Slab ☑ Crawl Space ☐ Basement w/plumbing ☐ Basement wo/plumbing

☑ House/Mod. Home No. Bedrooms 3
☐ Mobile Home No. Bathrooms 2
☐ Business No. Employees
☐ Other


Water Supply: ☐ Individual ☑ Public ☐ Community

Comments/Conditions:

Comments/Conditions: - Poly/Lok Filter Installed
-50 Infiltrator Chambers Installed

1"=50'

INITIAL SITE SKETCH

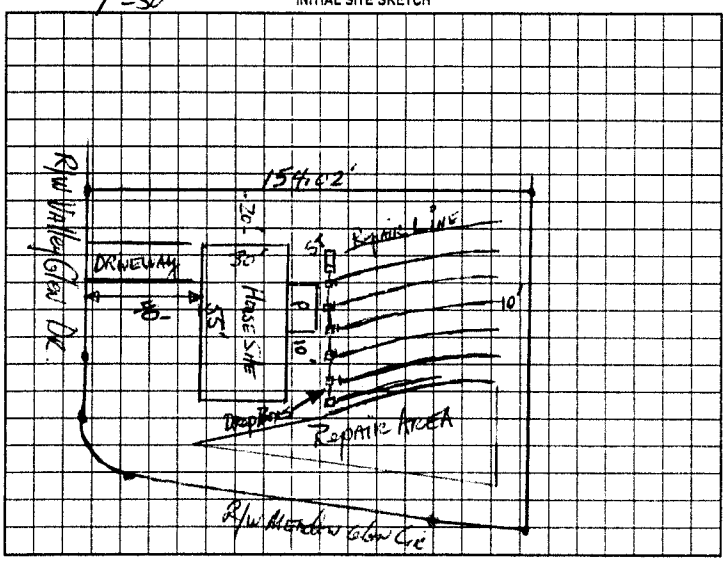

AS BUILT SKETCH

Installed as Shown Per Initial Site Sketch

6 Lines
5 @ 60 Lines
1 @ 45 Lines
5 Chambers
4 Chambers

Permit can be suspended or revoked if any false information is supplied toward securing the permit/any unauthorized changes are made to the site/any unauthorized changes are made in the installation of the system. Improvement Permit with plat valid without expiration. Improvement Permit with site plan valid for sixty months. Authorization to Construct is valid for a period equal to that of Improvement Permit – not to exceed sixty months.

Signed: Angie Cook date 4/2/01
Improvement Permit by: [signature] date 3-30-01
Authorization to Construct by: [signature] date 5/10/01

Installed by: Rolston Septic
Operation Permit by: Collin S. Johnson date 2/14/01
Existing System Inspection by: date

HEALTH DEPT. COPY WHITE OWNER COPY (FINAL) YELLOW OWNER COPY (INITIAL) PINK