IREDELL COUNTY HEALTH DEPARTMENT

STATESVILLE 704-878-5305 300.00 Pd MOORESVILLE 704-664-5281

IMPROVEMENT PERMIT / AUTHORIZATION TO CONSTRUCT / OPERATION PERMIT / EXISTING SYSTEM INSPECTION

DATE July 13, 01

PERMIT# 01-5-070 PIN# 4730-48-6343

OWNER OR CONTRACTOR C & S Associates PHONE: Business Home

ADDRESS 4474 Lake Dr. Sherrills Ford, N.C. 28673

LOCATION State Park Rd. TR Meadow Glen Dr. TL Spring Lake Dr 3rd lot on left

SUBDIVISION Meadow Glen BLOCK / SECTION 4 LOT 69 LOT AREA .35 Ac SITE CLASS PS DESIGN FLOW 360 gpd L.T.A.R. .3

Septic Tank: 1000 Gallons: STB 312 Date 8-21-01

Pump Tank: 1000 Gallons: PT 283 Date 9-1-01

Pump Make: Model Serial No

Nitrification Field: No Fields 1 Square Feet 400 Linear Feet 200

No Lines 6 Trench Width 24" B/oc Trench Bottom Depth 36"

☑ New System ☐ Repair System Type: I, II, III, IV, V, VI

System Description: pm - PPBPS

Repair System Description: LP PPBPS

Maintenance Agreement Required: ☐ Yes ☑ No initially

Gravel Depth NA ☐ Slab ☐ Crawl Space ☐ Basement w/plumbing ☐ Basement wo/plumbing

☑ House/Mod. Home No. Bedrooms 3

☐ Mobile Home No. Bathrooms 2

☐ Business No. Employees

☐ Other


Water Supply: ☐ Individual ☑ Public ☐ Community

Comments/Conditions: Use 46 panels total & install laterals at 36" trench bottom due to some compaction on rear of lot.

Comments/Conditions: SEPTIC TANK WITH MARKER INSTALLED USING "ZABEL" FILTER

INITIAL SITE SKETCH

1"=50'

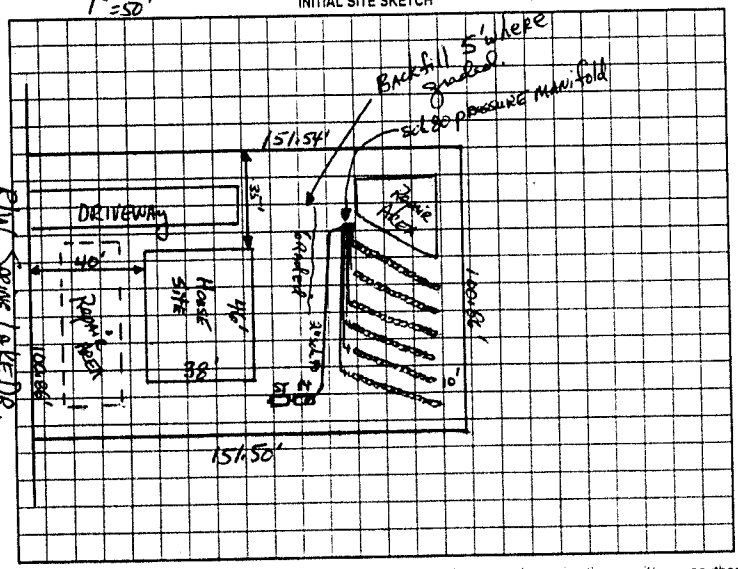

AS BUILT SKETCH

LINES CHECKED
TANKS CHECKED
PUMP INTO CHECKED
PRESSURE SET
NEEDS ALL ELECTRICAL

Installed as Shown

Permit can be suspended or revoked if any false information is supplied toward securing the permit/any unauthorized changes are made to the site/any unauthorized changes are made in the installation of the system. Improvement Permit with plat valid without expiration. Improvement Permit with site plan valid for sixty months. Authorization to Construct is valid for a period equal to that of Improvement Permit – not to exceed sixty months.

Signed: LaVerne Hargrave date 7-16-01 Installed by: CRAIG THOMPSON

Improvement Permit by: David L. Jones, RS date 7-13-01 Operation Permit by: William O. Johnson date 11/27/01

Authorization to Construct by: STEVEN HEDRICK date 7-18-01 Existing System Inspection by: date

HEALTH DEPT. COPY: WHITE OWNER COPY (FINAL): YELLOW OWNER COPY (INITIAL): PINK