100528

IREDELL COUNTY HEALTH DEPARTMENT

STATESVILLE 704-878-5305 300.00 Paid MOORESVILLE 704-664-5281

IMPROVEMENT PERMIT / AUTHORIZATION TO CONSTRUCT / OPERATION PERMIT / EXISTING SYSTEM INSPECTION

DATE 2-27-01

PERMIT# 20-2-0900 PIN# 4730-46-6343

OWNER OR CONTRACTOR C & S Associates PHONE: Business 202-4971 Home

ADDRESS 4474 Cuffe Dr. Sherrills Ford N.C. 28673

LOCATION State Park Rd TR Meadow Glen Drive on left past Spring Lake Dr.

SUBDIVISION Meadow Glen BLOCK / SECTION 4 LOT 81 LOT AREA .34ac SITE CLASS PS DESIGN FLOW 360gpd L.T.A.R. .3

Septic Tank: 1000 Gallons: STB ~~1000~~ 1042 Date 6-25-01

Pump Tank: Gallons: PT Date

Pump Make: Model Serial No

Nitrification Field: No Fields 1 Square Feet 900/600 Linear Feet 200

No Lines 4@50' Trench Width 24" Max Trench Bottom Depth 36"

☒ New System ☐ Repair System Type: I II III IV V VI

System Description: Gravity PPBPS

Repair System Description: 1 PPPBPS

Maintenance Agreement Required: ☐ Yes ☒ No installed

Gravel Depth N/A

☒ House/Mod. Home No. Bedrooms 3

☐ Mobile Home No. Bathrooms 2

☐ Business No. Employees

☐ Other


☐ Slab ☒ Crawl Space ☐ Basement w/plumbing ☐ Basement wo/plumbing

Water Supply: ☐ Individual ☒ Public ☐ Community


Comments/Conditions: * 3' wide trenches, 9' on center may be used
① CONTACT HEALTH DEPT. PRIOR TO INSTALLATION
- Lines may be deep due to Landscape 3/16/01

Comments/Conditions - Polylok Filter Installed
- Septic Tank Marker Installed
- 200ft of PPBPS Installed.

INITIAL SITE SKETCH

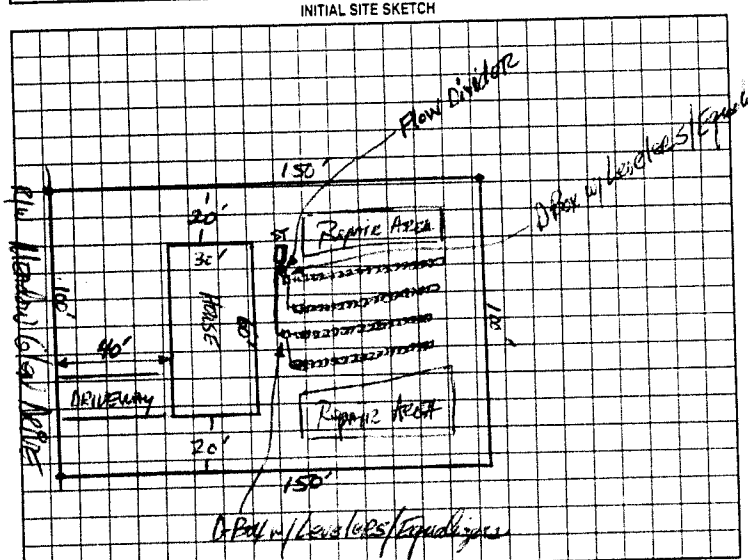

AS BUILT SKETCH

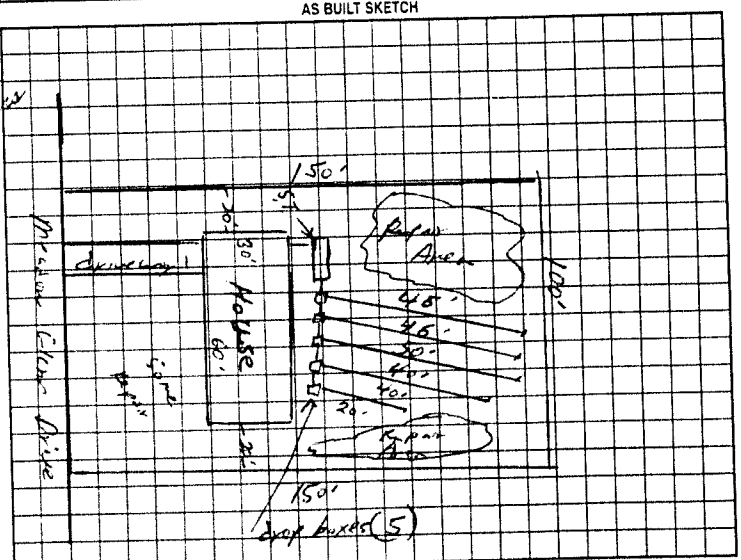

Permit can be suspended or revoked if any false information is supplied toward securing the permit/any unauthorized changes are made to the site/any unauthorized changes are made in the installation of the system. Improvement Permit with plat valid without expiration. Improvement Permit with site plan valid for sixty months. Authorization to Construct is valid for a period equal to that of Improvement Permit – not to exceed sixty months.

Signed: [signature] date 4/2/01

Improvement Permit by: [signature] date 2-27-01

Authorization to Construct by: [signature] date 5/3/01

Installed by: Mitchell Grading

Operation Permit by: William E Johnson date 9/26/01

Existing System Inspection by: date

HEALTH DEPT COPY: WHITE OWNER COPY (FINAL): YELLOW OWNER COPY (INITIAL): PINK